



DDDD

Electromagnetic Hold Open Elevator Lobby Doors in Office Building "Traffic Door" (each leaf swings in each direction) type, solid core, draft seals. Z-corridors on typical floors (with the exception of the 2 hour doors to ve to be fire rated, but simply be solid core, with smoke and draft seals from both the Office Building and the Parking e Town of Addison. See Site Plan Sheet 1.0. on Levels 3-8, non fire rated, will be of the , with smoke c

Stair Pressurization will be via Barometric Damper Relief meth section 3310(b) Exception 1 for Fully Sprinklered Buildings, via labeled breakout wi utside the line building As previously agreed to by Town of Elevator Equipment Room and the Pecessary throughout the Parking Gara 16721 (14 Oct 97 rear Office Building and and to house ows (i.e. NOT a

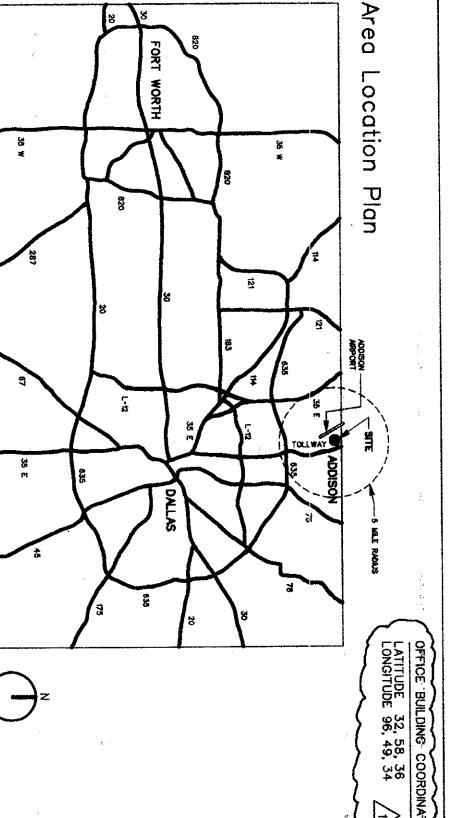

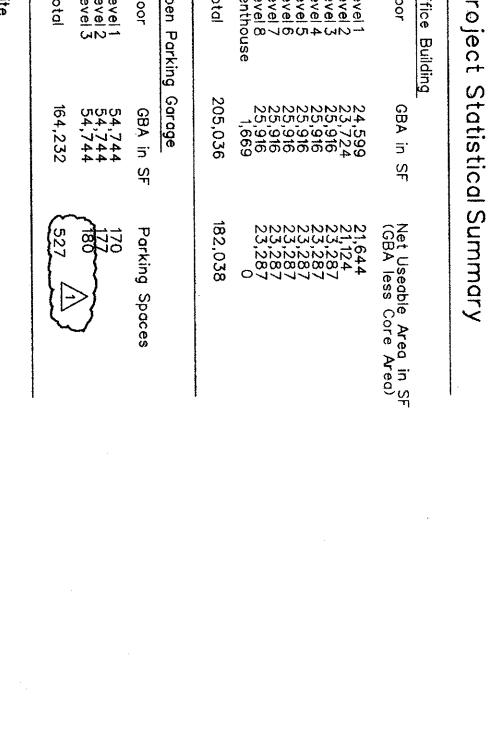

DELIVER TO: