	CURVE	DELTA ANGLE	RADIUS	ARC LENGTH	CHORD BEARING	CHORD LENGTH
FIELD	C1	04°39'02"	1600.00'	129.87'	S 19°42'20" E	129.83'
PER PLAT	C1	04°39'06"	1600.00'	129.90'	S 19°44'43" E	129.86'

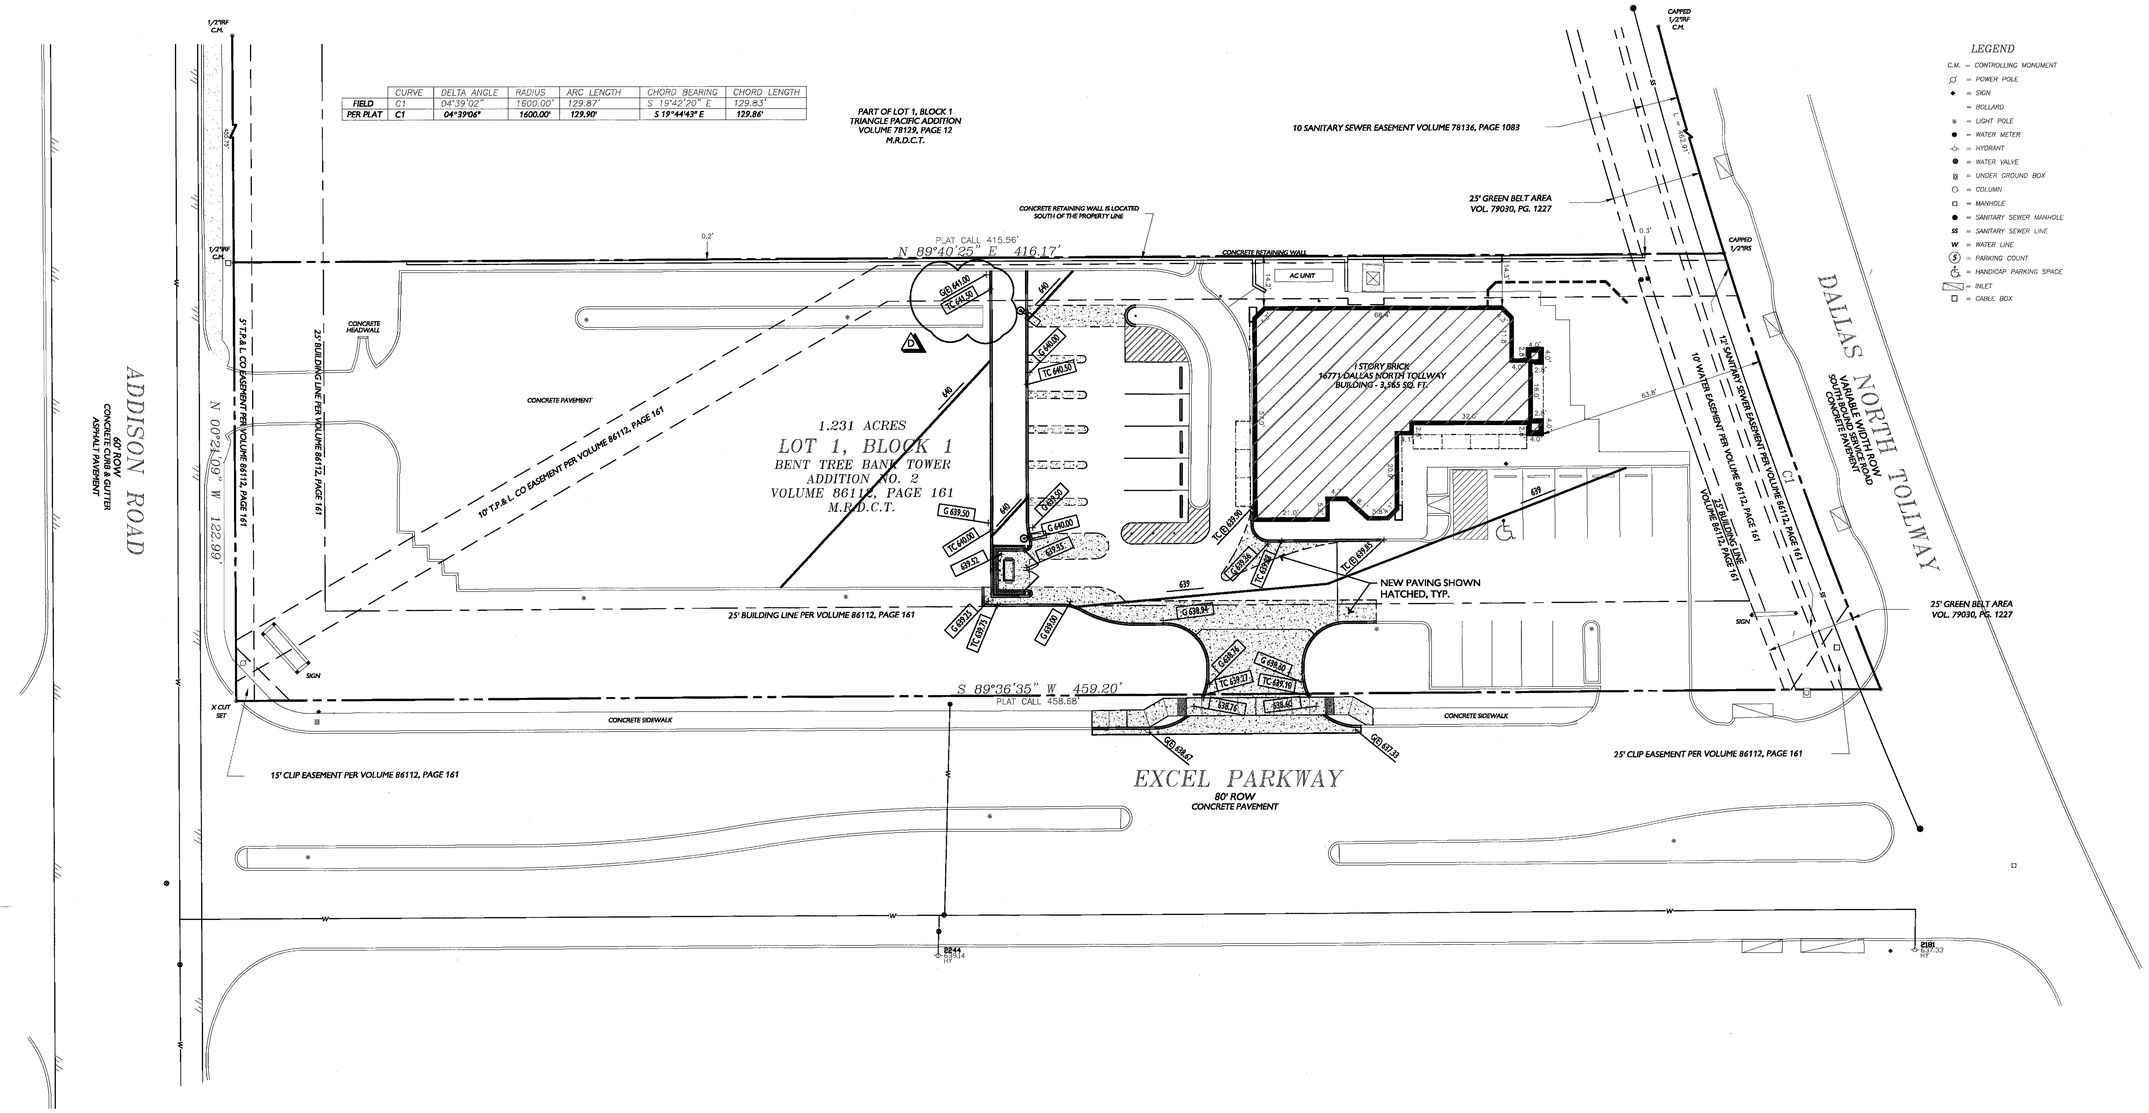

LEGEND

- C.M. = CONTROLLING MONUMENT
- = POWER POLE
- = SIGN
- = BOLLARD
- = LIGHT POLE
- = WATER METER
- = HYDRANT
- = WATER VALVE
- = UNDER GROUND BOX
- = COLUMN
- = MANHOLE
- = SANITARY SEWER MANHOLE
- SS = SANITARY SEWER LINE
- W = WATER LINE
- = PARKING COUNT
- = HANDICAP PARKING SPACE
- = INLET
- = CABLE BOX

01 GRADING PLAN

SCALE: 1" = 20'-0"

NORTH

SITE INFORMATION TAKEN FROM TAYLOR-HEWLWTT, INC. DRAWINGS DATED 08.15.85 USED IN ORIGINAL CONSTRUCTION AND ALTA SURVEY BY SURDUKAN SURVEYING, INC. DATED 11.01.11

NOTE:
THIS DRAWING HAS BEEN SCALED FROM EXISTING RECORD PRINTS, RECORD ELEVATIONS HERON, PROVIDED BY THE OWNER AND/OR OTHERS. ALLOWANCES HAVE BEEN MADE IN THE DESIGN FOR LACK OF EXACT DIMENSIONS. HIDDEN CONDITIONS MAY REQUIRE ADJUSTMENT TO THE APPROVED DESIGN.

ALEXANDER KIENAST SCHNITZ

ARCHITECTURE & INTERIOR DESIGN
13601 PRESTON RD, SUITE 107W
DALLAS, TX 75240
P: 972.233.3506
F: 972.233.3525
Email: akstexas@akstexas.com
Web: www.akstexas.com

REGISTERED ARCHITECT JACK W. KIENAST 9384 STATE OF TEXAS

03.01.13

REVISIONS

A	REVISIONS PER CITY COMMENTS	03.01.13
B	REVISIONS PER CITY COMMENTS	03.06.13

DATE: 01.28.13

PROJECT NO: 1220

ISSUED FOR: PERMIT, PRICING & CONSTRUCTION

All drawings & written materials appearing herein constitute original unpublished work, & may not be duplicated, used or disclosed without written consent of ALEXANDER + KIENAST + SCHNITZ, LLC.

GREEN BANK
BANK SUSTAINABLY
Dallas North Tollway Branch
16771 Dallas Parkway
Addison, TX 75001

NEW SHEET

GRADING PLAN

120

J:\dwg\2012\1220 - Greenbank Dallas North Tollway\Sheets\100 - Site\120 GRADING PLAN.dwg Mar 06, 2013 11:18am AKS-112-PC