


LINE N

LINE O

LINE P

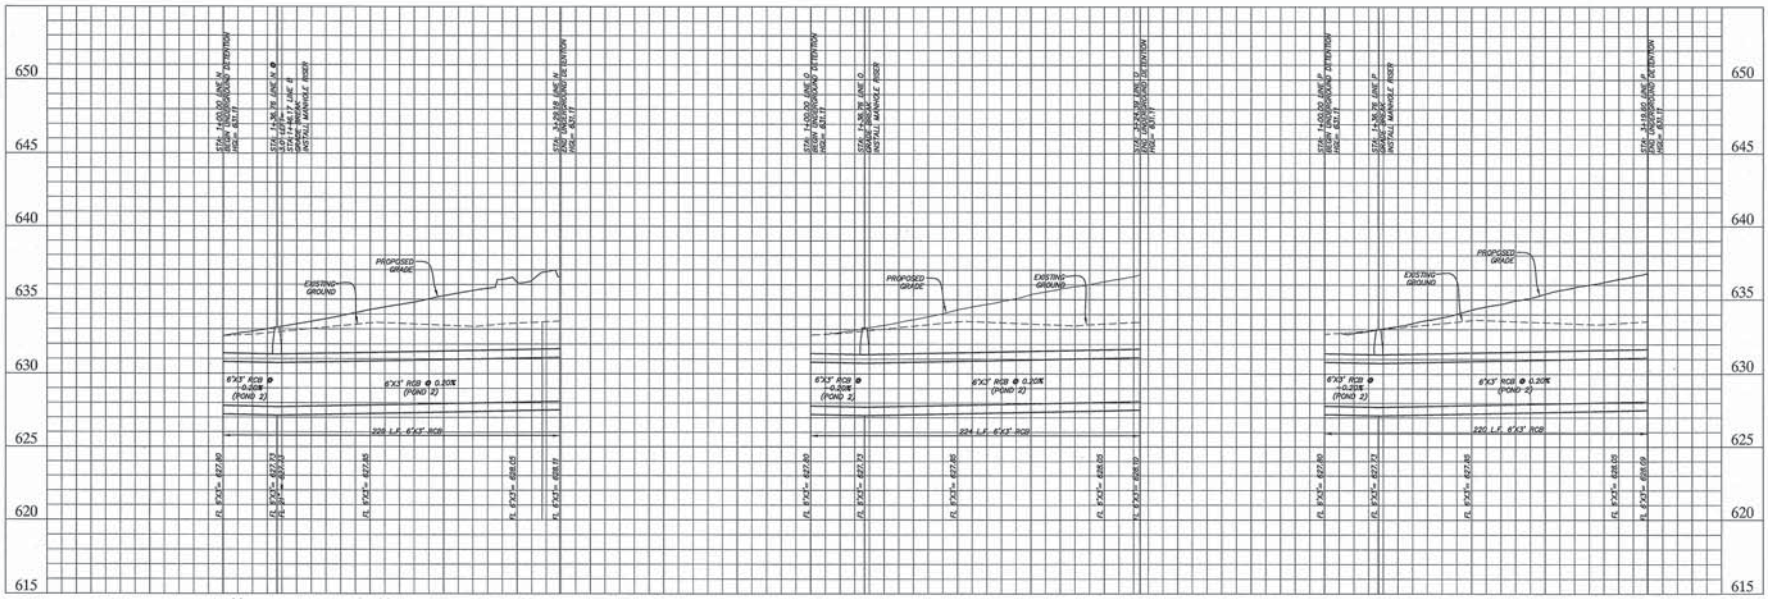


LINE Q

GRAPHIC SCALE 40'
1"=40'

THE CONTRACTOR SHALL FIELD VERIFY THE HORIZONTAL AND VERTICAL LOCATIONS OF ALL EXISTING UTILITIES PRIOR TO START OF CONSTRUCTION AND SHALL NOTIFY THE CONSTRUCTION MANAGER AND ENGINEER OF ANY CONFLICTS DISCOVERED. CONTRACTOR IS RESPONSIBLE FOR PROTECTING EXISTING UTILITIES (SHOWN OR NOT SHOWN) WITHIN SCOPE OF CONSTRUCTION , IF ANY EXISTING UTILITIES ARE DAMAGED, THE CONTRACTOR SHALL REPLACE THEM AT HIS OWN EXPENSE. CALL 1-800-DIG-TESS AT LEAST 72 HOURS PRIOR TO COMMENCING CONSTRUCTION IN VICINITY.

**RECORD DRAWINGS (SEPTEMBER 2010)**

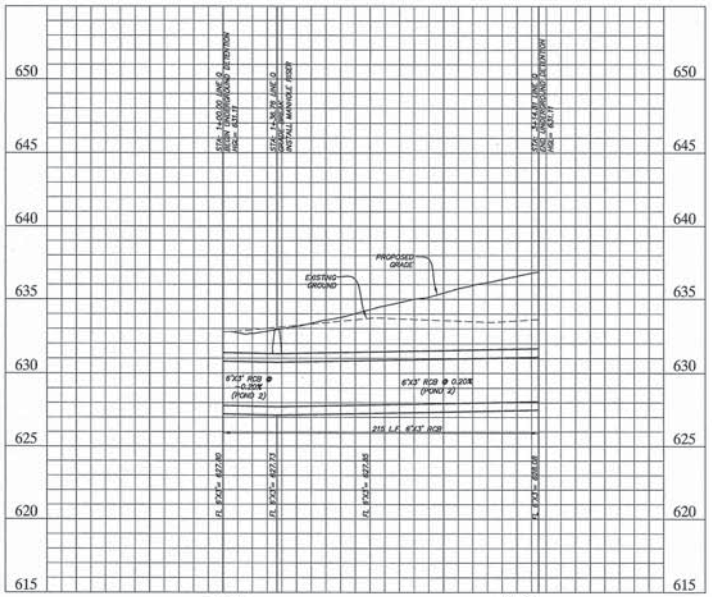INFORMATION PROVIDED BY:
Rogers-O'Brien Construction Company

BENCHMARK

1. "□" FOUND ON TOP OF THE CONCRETE BASE OF A LIGHT POLE IN THE CENTER MEDIAN OF EXCEL PARKWAY APPROXIMATELY 50 FEET WEST OF THE CENTERLINE OF ADDISON ROAD. (PER TOWN OF ADDISON PLAN # 96103, SHEET 2, DATED JANUARY 1998) ELEV=644.41
2. BM #60"CP" SET ON TOP OF A CONCRETE CURB INLET LOCATED ON THE WEST SIDE OF DALLAS PARKWAY APPROXIMATELY 826 FEET NORTH OF THE CENTERLINE OF SOJOURN DRIVE. ELEV=632.78
3. BM #61"CP" SET ON TOP OF A CONCRETE CURB INLET LOCATED ON THE WEST SIDE OF DALLAS PARKWAY APPROXIMATELY 160 FEET NORTH OF THE CENTERLINE OF SOJOURN DRIVE. ELEV=638.04

| No. | Date | Revisions | App. |
|---|---|---|---|


Kimley-Horn and Associates, Inc.
5750 Genesis Court, Suite 200
Frisco, Texas 75034
Tel. No.(972) 335-3580
Fax No.(972) 335-3779
State of Texas Registration No. F-928


DAVID K. KOCHALKA
87781
LICENSED
PROFESSIONAL
ENGINEER
STATE OF TEXAS

METHODIST HOSPITAL
FOR SURGERY
ADDISON, TEXAS
FILE NUMBER: 311T-7863

DETENTION PROFILES

| | |
|---|---|
| Scale: | AS SHOWN |
| Designed by: | TNB |
| Drawn by: | BCO |
| Checked by: | DKK |
| Date: | 11/2009 |
| Project No. | 69083000 |

SHEET
C-13


IMAGES
ADDED
FOOTED BY
PLOTTED BY
LAST SAVED
\\DEC-JOB_FILES\Data\
BRAZIL_TEXT_11X17.DWT
K:\DFW_Survey\METHODIST ADDISON\PHASE_II\PLOTS_DETENTION PROFILES.DWG
11/20/09 7:48 AM