


**ADDISON ROAD**  
(ASPHALT PAVING)

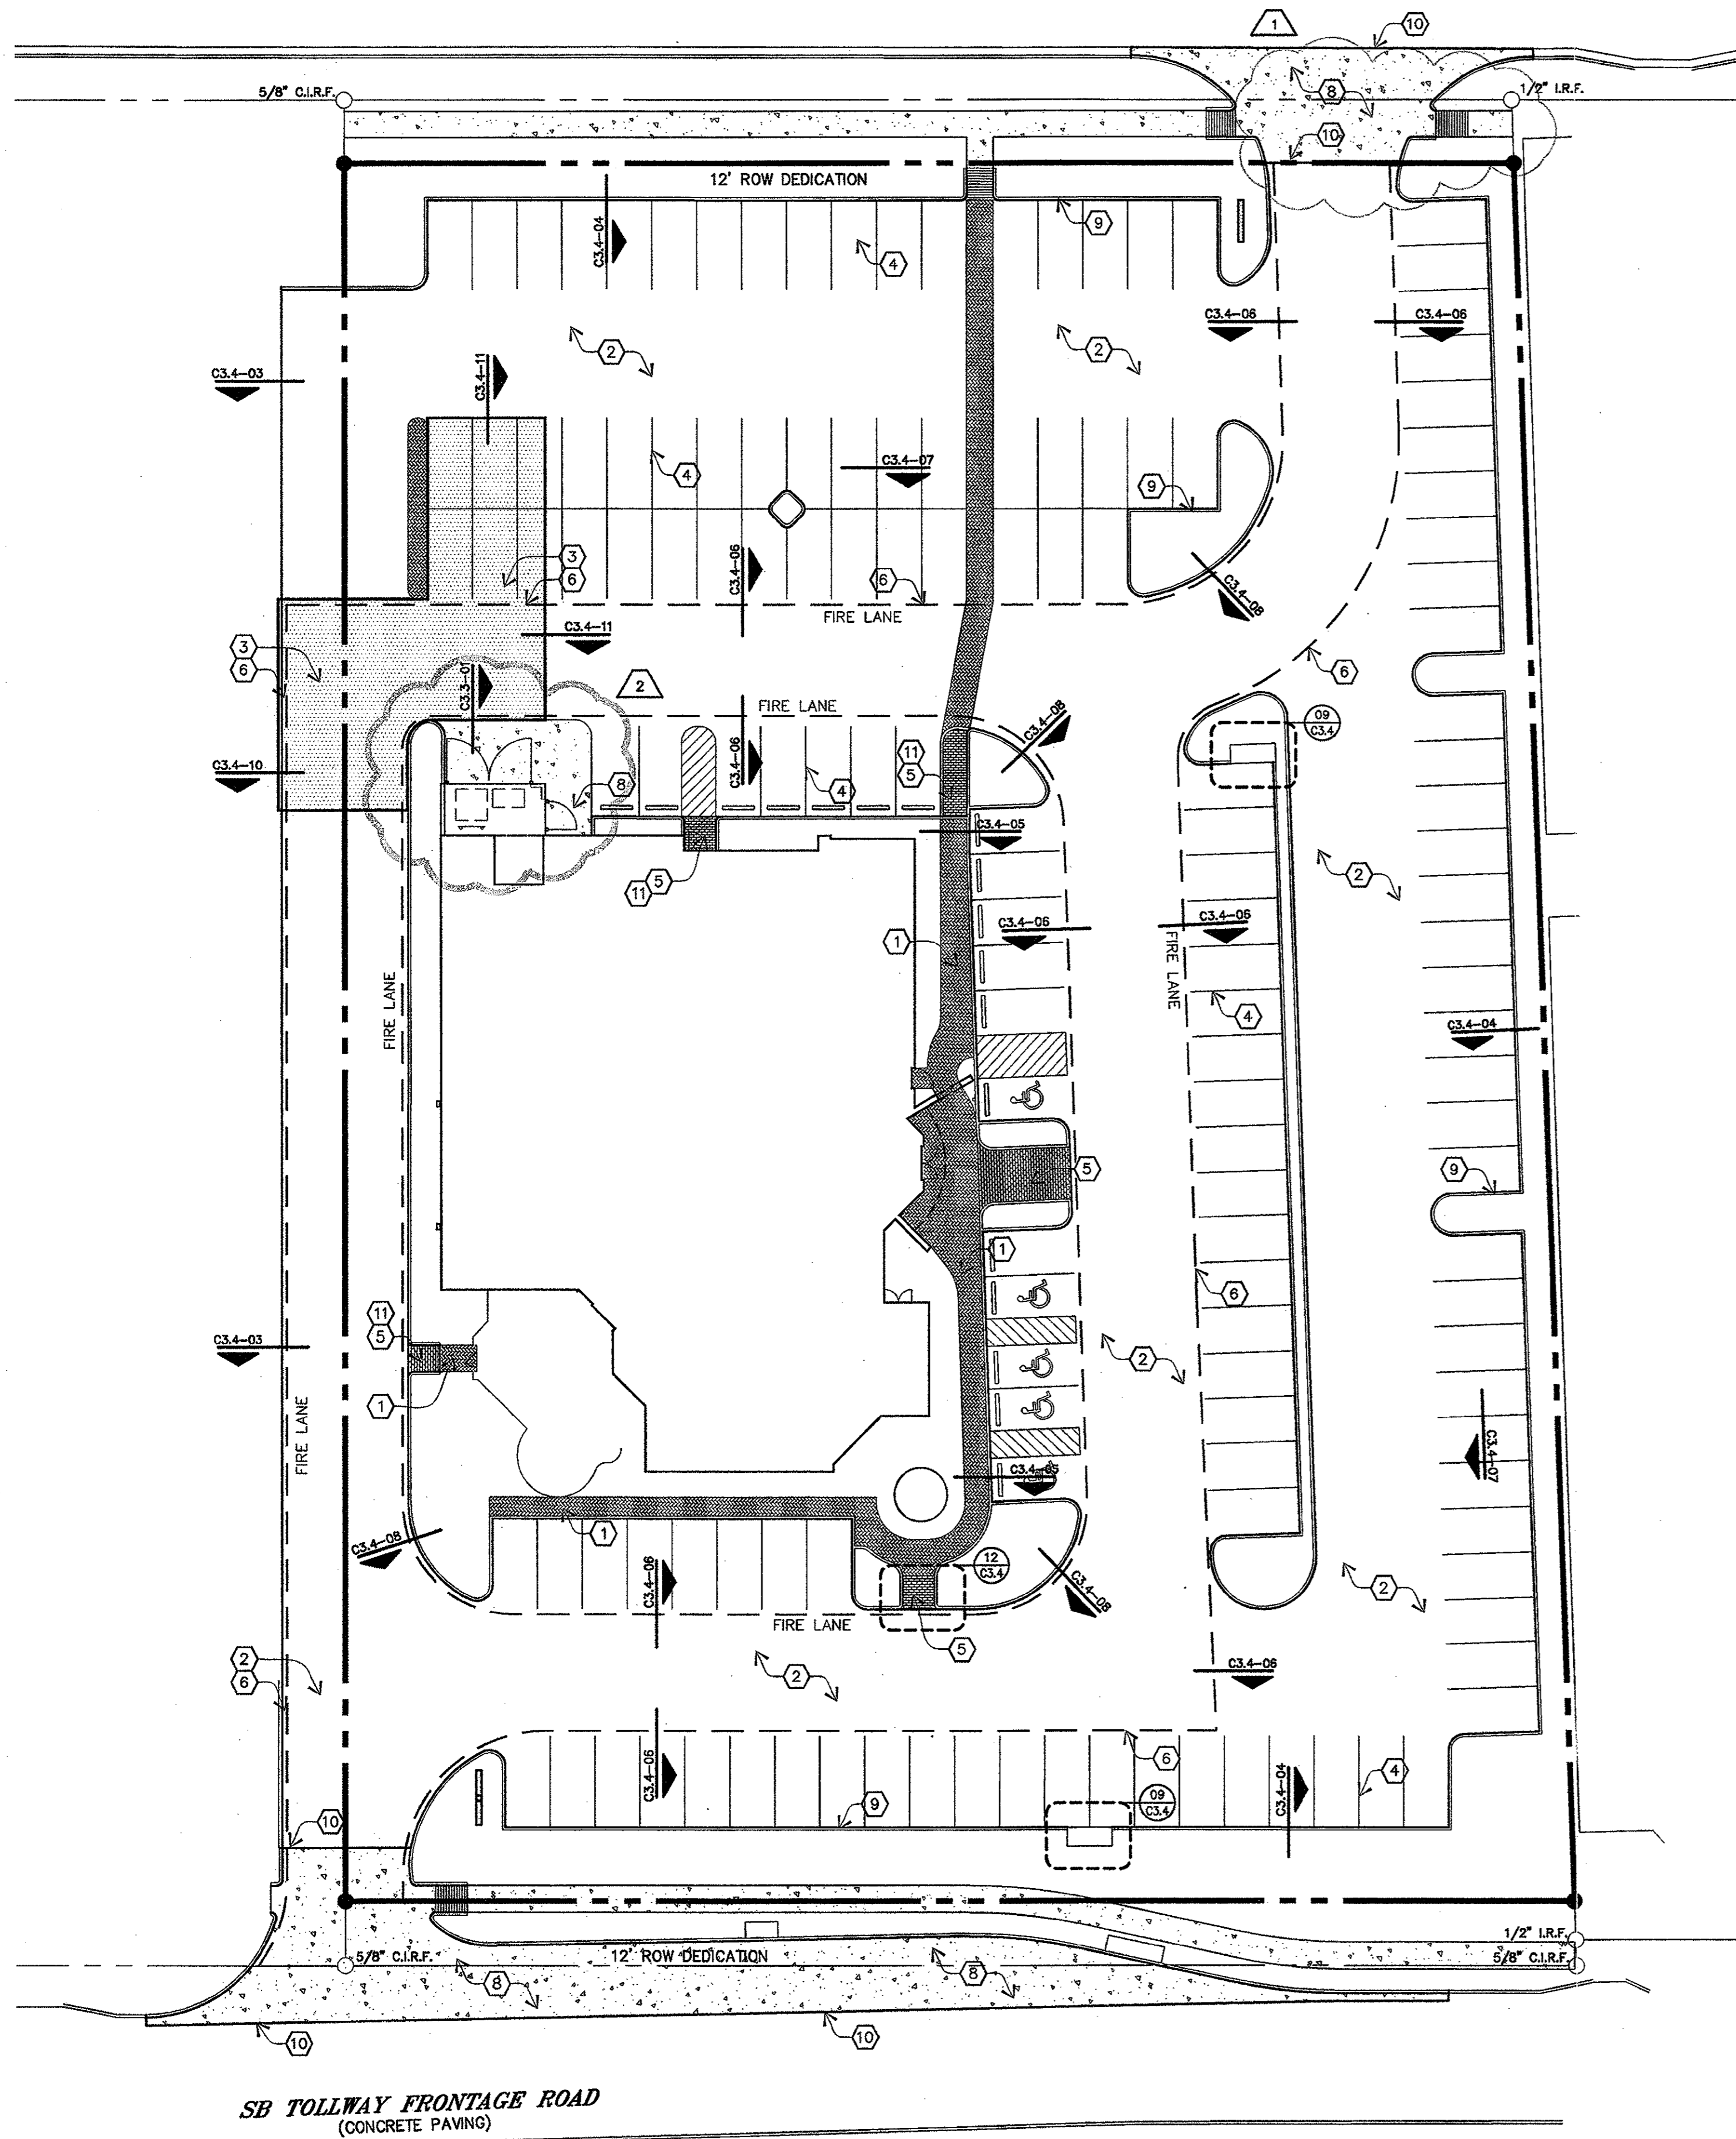

**SB TOLLWAY FRONTAGE ROAD**  
(CONCRETE PAVING)

**KEYED NOTES**


- ① MODULAR BLOCK PAVERS (SIDEWALK), SEE DETAIL C3.4-02.
- ② MODULAR BLOCK PAVERS (STANDARD PAVEMENT), SEE DETAIL C3.4-01.
- ③ MODULAR BLOCK PAVERS (HEAVY DUTY PAVEMENT), SEE DETAIL C3.4-10.
- ④ MODULAR BLOCK PAVERS (CONTRASTING COLOR). TYPICAL ALL PARKING LOT STRIPING. SEE DETAIL C3.4-07.
- ⑤ MODULAR BLOCK PAVERS (ADA COMPLIANT), SEE DETAIL C3.4-12.
- ⑥ MODULAR BLOCK PAVERS (FIRE LANE). SEE DETAIL C3.4-06.
- ⑦ STANDARD DUTY CONCRETE PAVING, SEE DETAIL C2.1-02.
- ⑧ HEAVY DUTY CONCRETE PAVING. SEE DETAIL C2.1-02.
- ⑨ FORMED CONCRETE CURB, SEE DETAIL C2.1-06.
- ⑩ TURN DOWN EDGE, SEE DETAIL C2.1-04.
- ⑪ SERVICE RAMP, SEE DETAIL C2.1-09.

**GENERAL NOTES**

- 1. MODULAR BLOCK PAVERS TO BE USED FOR SIDEWALKS WILL BE "HOLLAND 98", 3 1/8" INCH THICK, COLOR TO BE CUSTOM BLEND TO MATCH BUILDING FACADE COLORS, AS MANUFACTURED BY PAVESTONE COMPANY.
- 2. MODULAR BLOCK PAVERS TO BE USED FOR STANDARD/HEAVY-DUTY PAVEMENT WILL BE "HOLLAND 98", 3 1/8" INCH THICK, COLOR TO BE PEWTER, AS MANUFACTURED BY PAVESTONE COMPANY.
- 3. MODULAR BLOCK PAVERS TO BE USED FOR CONTRASTING PAVEMENT COLOR WILL BE "HOLLAND 98", 3 1/8" INCH THICK, COLOR TO BE CHARCOL, AS MANUFACTURED BY PAVESTONE COMPANY.
- 4. MODULAR BLOCK PAVERS TO BE USED FOR ADA ACCESSIBLE RAMPS WILL BE "ADA DETECTABLE WARNING PAVEMENT", 3 1/8" INCH THICK, COLOR TO BE CONTRASTING TO ADJACENT SIDEWALK, AS MANUFACTURED BY PAVESTONE COMPANY.



0 10 20 40  
**SCALE: 1" = 20.00'**

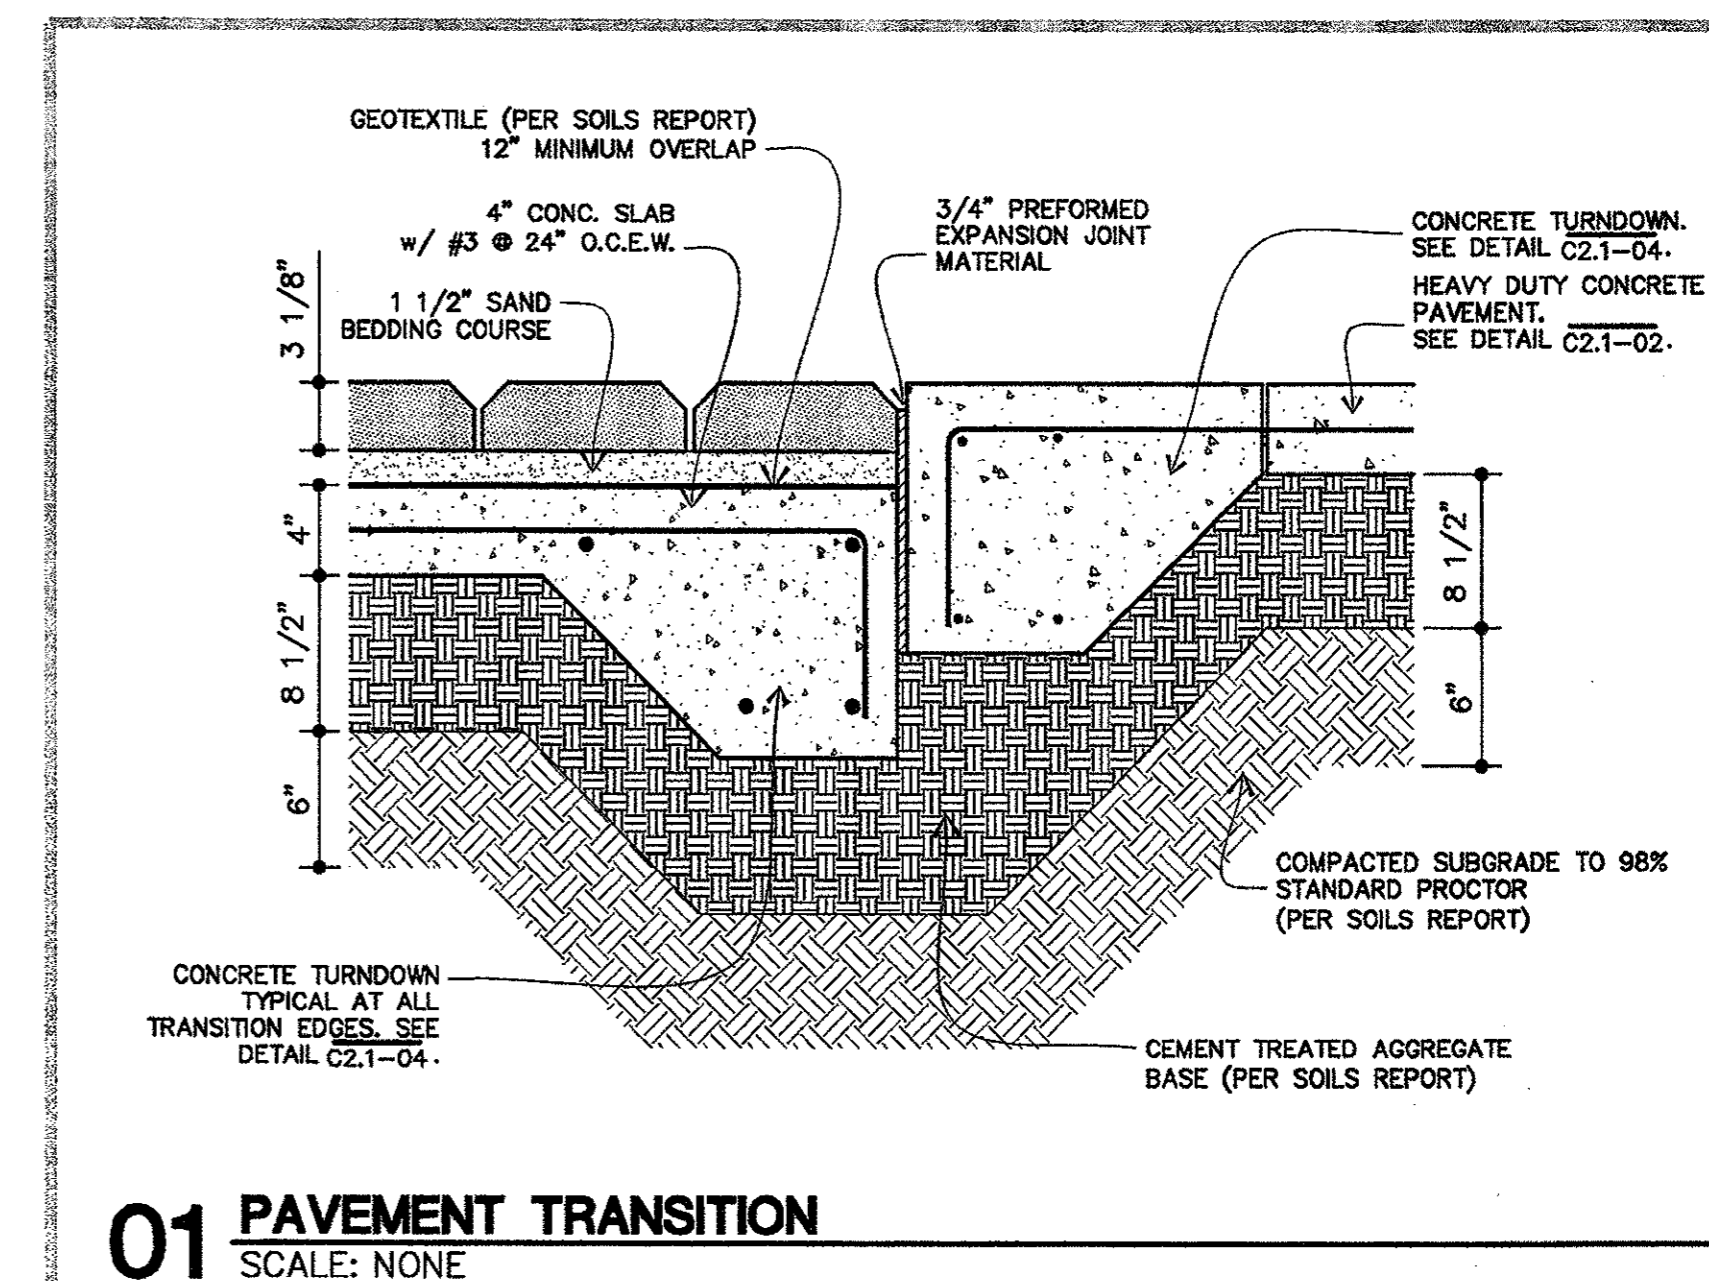


**01 PAVEMENT TRANSITION**  
SCALE: NONE




2350 Valley View Lane  
Suite 100  
Dallas, Texas 75234-5734  
T 214.351.5400  
F 214.351.2095  
info@wdpartners.com  
wdpartners.com

Dallas  
Columbus  
Los Angeles  
Chicago  
Miami

expesite.com

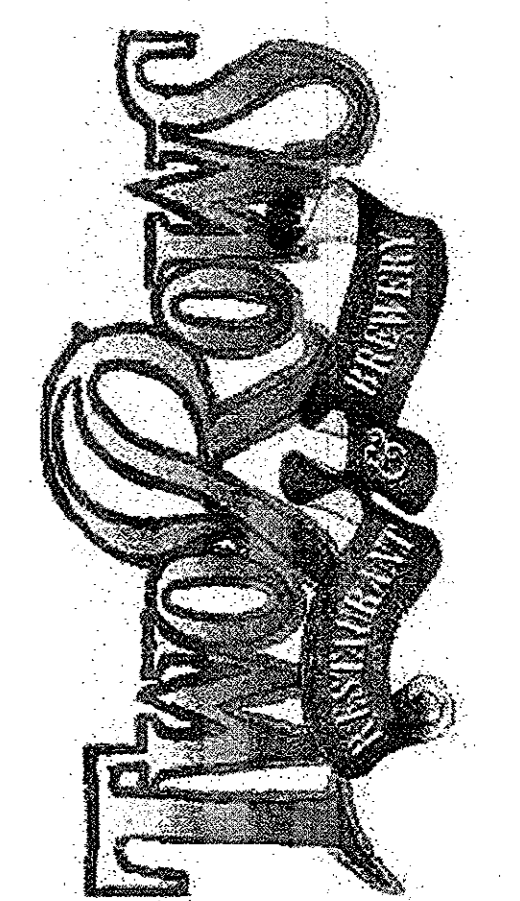

17225 Dallas Parkway  
Addison, TX

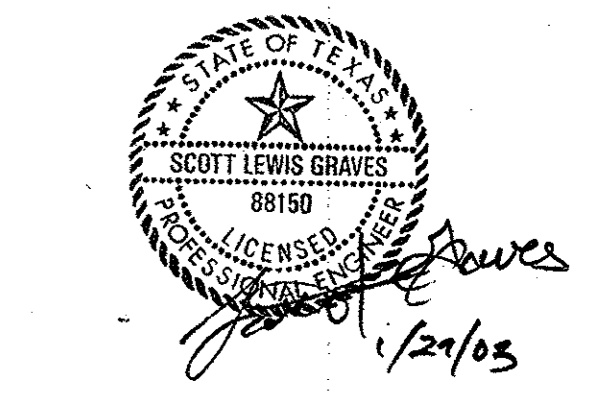

**REVISIONS**

1	12/19/02 (City)
2	01/24/03 (City)

PROTOTYPE

STORE NUMBER

WD PROJECT NUMBER  
0000.659-00

**C3.3**

**PAVING PLAN**