

NOTES

- A. WHERE BACKFILL IS DESIGNATED "COMPACTED", THIS MEANS 90% TO 95% STANDARD PROCTOR, AASHTO T-99. ALL FILL PLACED BELOW PIPES AND STRUCTURES MUST MEET THIS REQUIREMENT.
- B. FOR ALL TRENCHES WITH A GRADE GREATER THAN 4% AND/OR WHERE GROUNDWATER IS APPARENT, INSTALL CLAY DAMS AROUND PIPE AT 100' INTERVALS.

CONDITION AND PIPE	**SELECT MATERIAL	LINING MATERIAL	3" Y-DIMENSION
DUCTILE IRON PIPE IN "ORDINARY SOIL"	TYPE I, II, OR III	SAND OR TYPE III	3"
RCP PIPE IN "ORDINARY SOIL"	TYPE II OR III	SAND OR TYPE III	6"
ALL PIPE OVER BEDROCK OR LEDGE	TYPE II OR III	SAND OR TYPE III	4"
DUCTILE IRON PIPE IN CLAY OR MUCK	TYPE II OR III	SAND	6"
RCP PIPE IN CLAY	TYPE II OR III	SAND	6"
PLASTIC-ALL	SAND OR TYPE III	SAND OR TYPE III	


* SUITABLE MATERIAL SHOULD CONTAIN NO STONES GREATER THAN 4" IN DIAMETER, NO FROZEN LUMPS, AND ONLY MINOR AMOUNTS OF CLAY OR ORGANIC MATERIAL. ALL MATERIAL TO BE PLACED IN MAXIMUM OF 12" LIFTS AND COMPACTED BEFORE PLACING NEXT LIFT.

** TYPE I MATERIAL SHALL BE EITHER GRAVEL OR EXCAVATED MATERIAL CONTAINING NO STONES GREATER THAN 1 1/2" IN DIAMETER, NO FROZEN LUMPS, NO CLAY, AND NO ORGANIC MATERIAL.

** TYPE II MATERIAL SHALL BE CLEAN, HARD, CRUSHED OR NATURAL STONE WITH A GRADATION BY WEIGHT OF 100% PASSING A 1 1/2" SQUARE OPENING, NOT MORE THAN 25% PASSING A 3/4" SQUARE OPENING AND NOT MORE THAN 5% PASSING A 1/2" SQUARE OPENING.

** TYPE III MATERIAL SHALL BE CLEAN, HARD, CRUSHED STONE FREE FROM COATINGS AND THOROUGHLY WASHED WITH A GRADATION BY WEIGHT OF 100% PASSING A 1" SQUARE OPENING AND 0 TO 5% PASSING A 1/4" SQUARE OPENING.


01 TRENCH/BACKFILL NOTES
SCALE: NONE

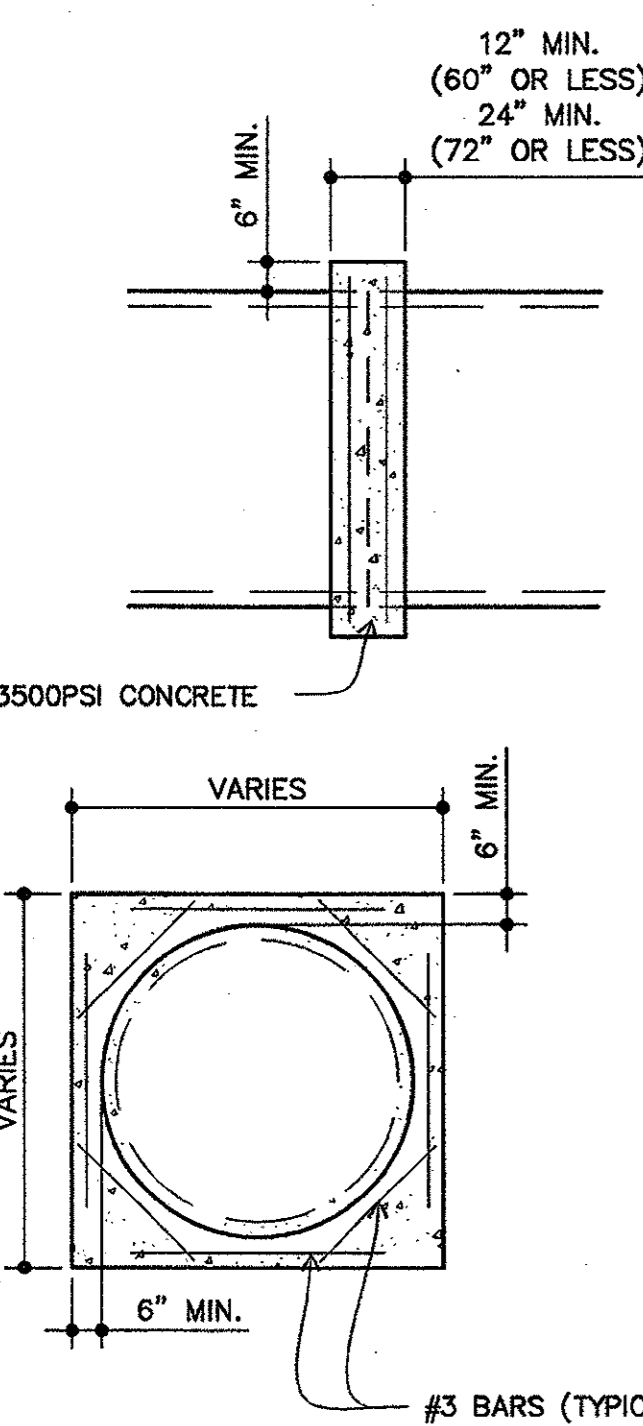


04 CONCRETE COLLAR
SCALE: NONE

SITE ELECTRICAL NOTES


- A. FINAL ADJUSTMENTS OF THE FLOODLIGHTS ANGLE AND DIRECTION ARE TO BE MADE AFTER DARK TO AVOID INTERFERENCE WITH TRAFFIC OR ADJACENT PROPERTY, PER SATISFACTION OF OWNERS REPRESENTATIVE.
- B. ALL SITE LIGHTING TO BE WIRED IN 1" P.V.C. CONDUIT. EACH CIRCUIT TO HAVE DIRECT RUN TO THE SWITCH-GEAR. EACH CIRCUIT TO HAVE ITS OWN CONDUIT, UNLESS NOTED OTHERWISE.
- C. FLOODLIGHTS, POLE SIGNS, SIDE BUILDING SIGNS AND ROOF LIGHTS ARE TURNED ON/OFF THROUGH A LIGHTING CONTROLLER (WITH PHOTOCELL) AND TIME CLOCKS.
- D. RAISE SITE LIGHT BASE TO 2'-6" ABOVE FINISHED GRADE WHEN LOCATED IN PARKING LOT.
- E. RUN 1 1/2" CONDUIT FOR THE POLE SIGN(S) UNLESS NOTED OTHERWISE.
- F. COORDINATE BASE PLATE AND ANCHOR BOLT LAYOUT WITH POLE SUPPLIER.

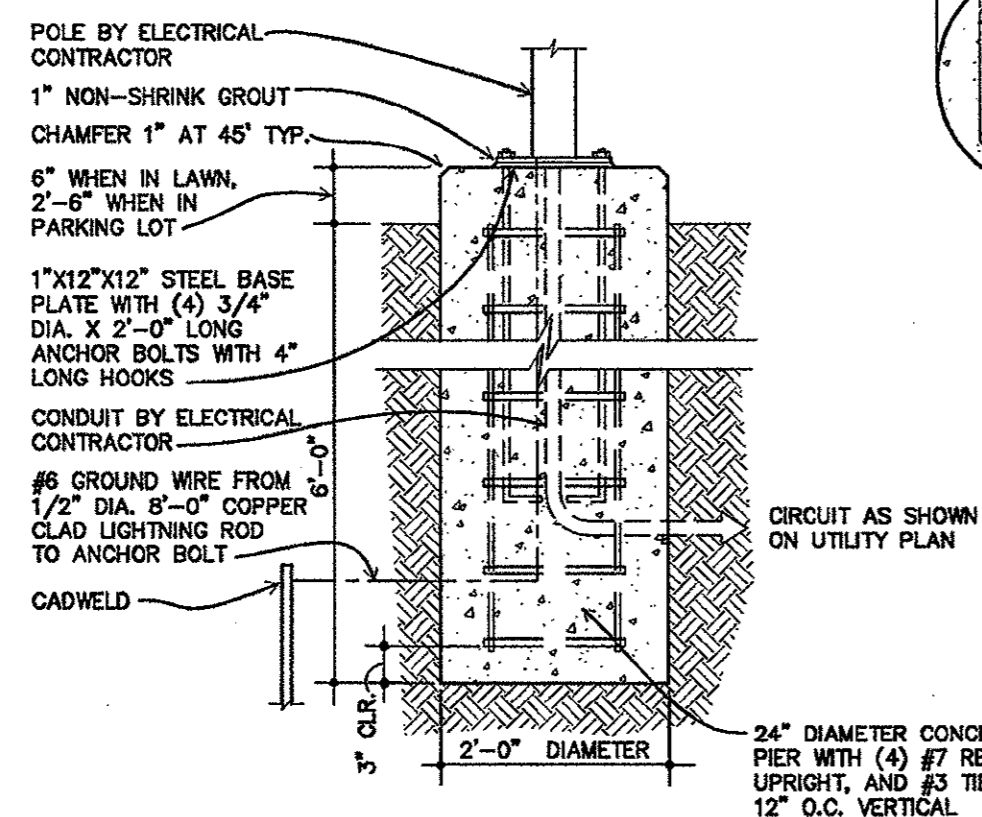


05 SITE LIGHT POLE BASE
SCALE: NONE

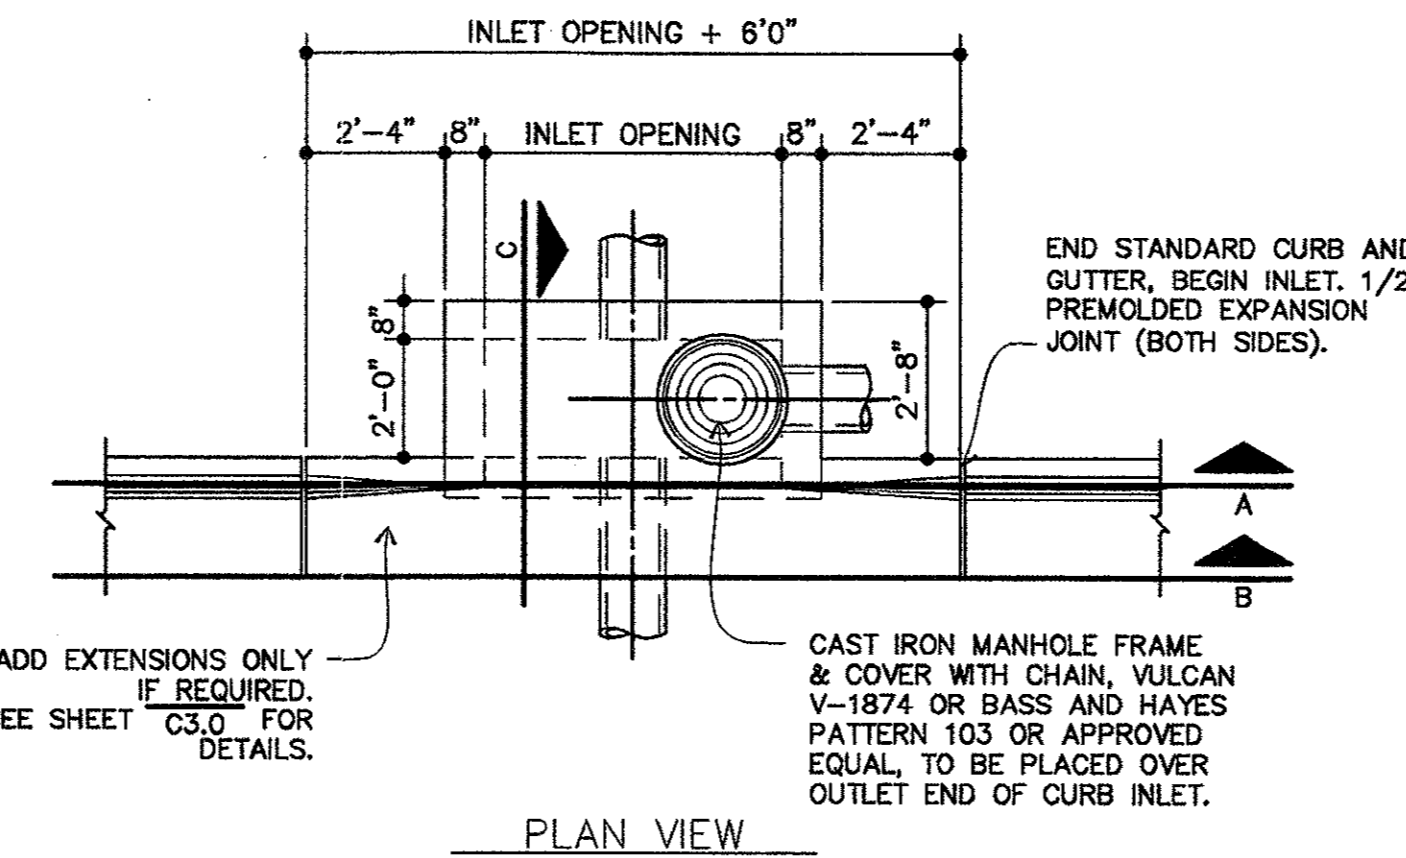

02 CURB INLET
SCALE: NONE

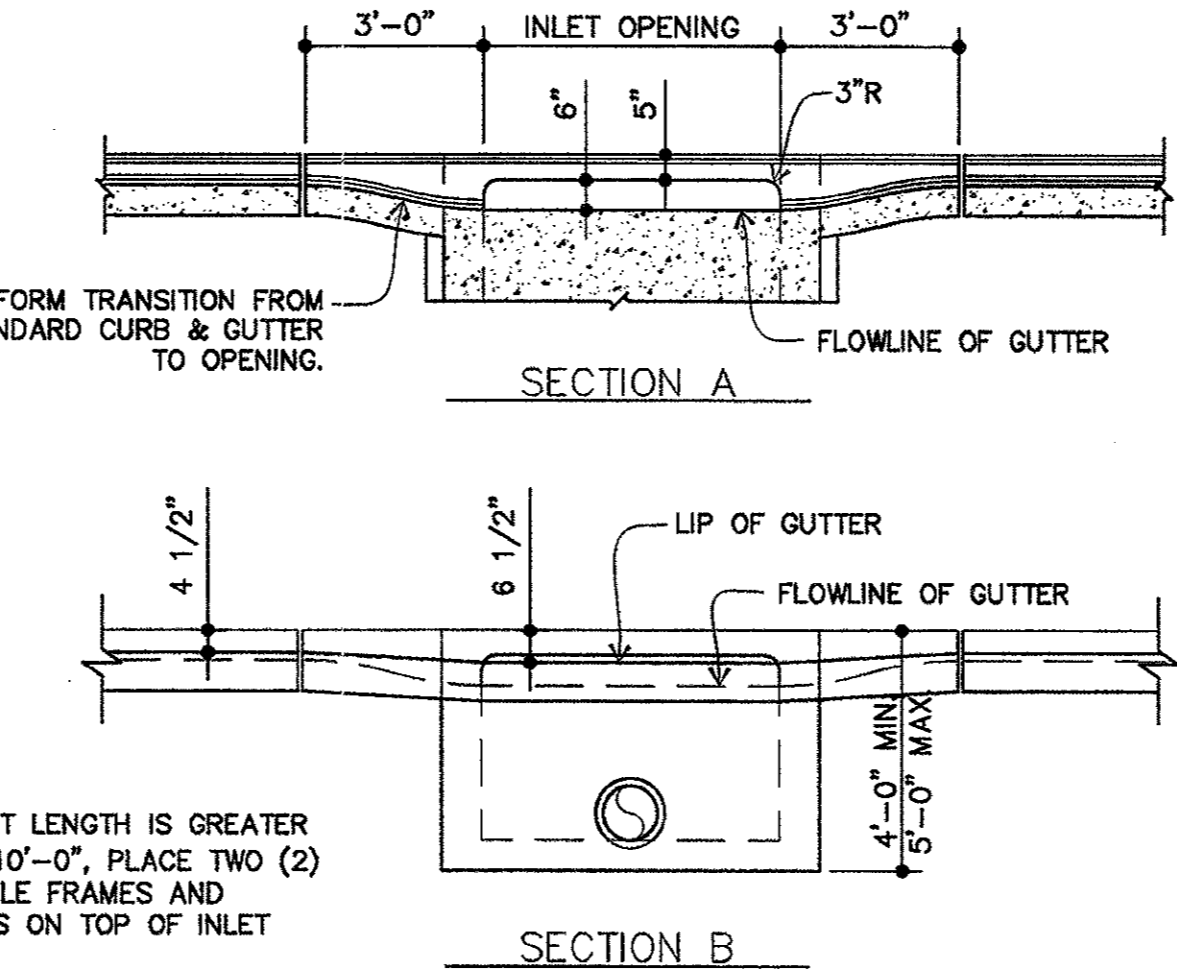


03 TWO-WAY CLEANOUT
SCALE: NONE

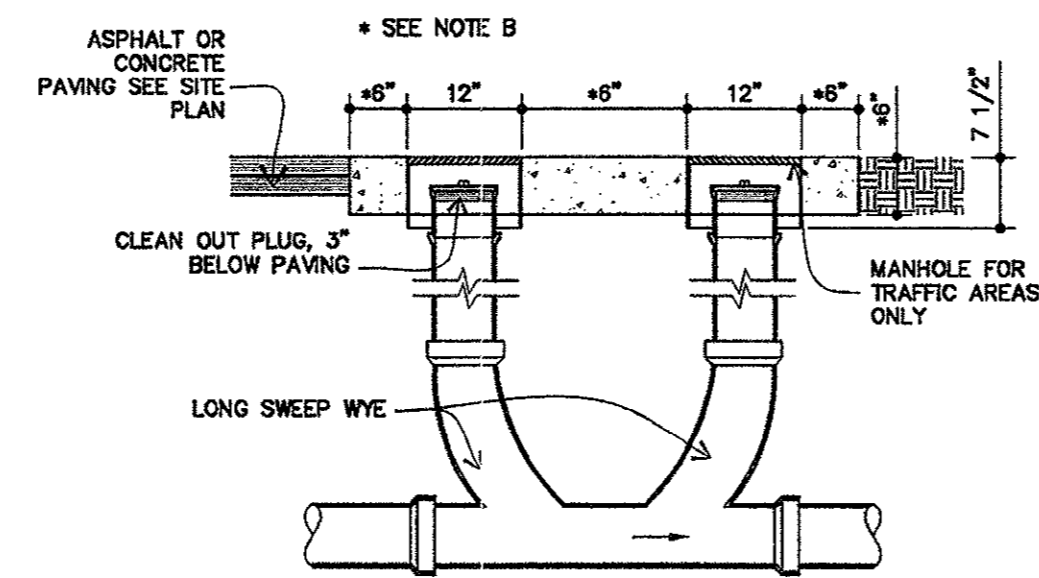


NOTES


- A. CLEAN OUT LOCATIONS INDICATED ON GRADING & UTILITY PLANS AS "CO"
- B. IF CLEANOUT IS LOCATED IN ASPHALT OR LANDSCAPE, ENSURE 6 INCHES MINIMUM OF CONCRETE ON ALL SIDES AND BOTTOM.
- C. PROVIDE CLEANOUTS AS SPECIFIED BELOW:
 - ZURN Z-1400 CLEAN OUTS IN NON-TRAFFIC AREAS & SIDEWALKS
 - ZURN Z-1448 CLEAN OUTS IN LANDSCAPED AREAS
 - ZURN Z-1400 HD CLEAN OUTS IN TRAFFIC AREAS WITH A "SERVICE STATION" TYPE MANHOLE, OPW #04 A12 - DOVER CORP./OPW DIV.

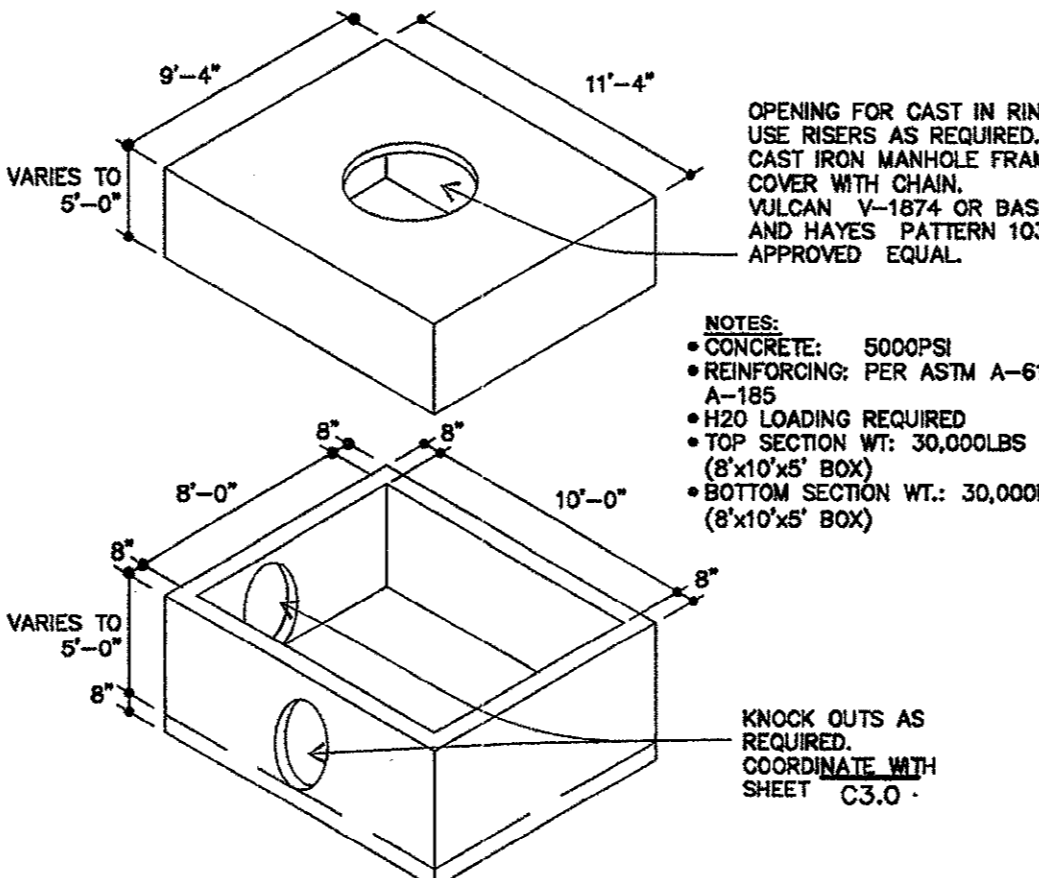

06 PRECAST JUNCTION BOX
SCALE: NONE

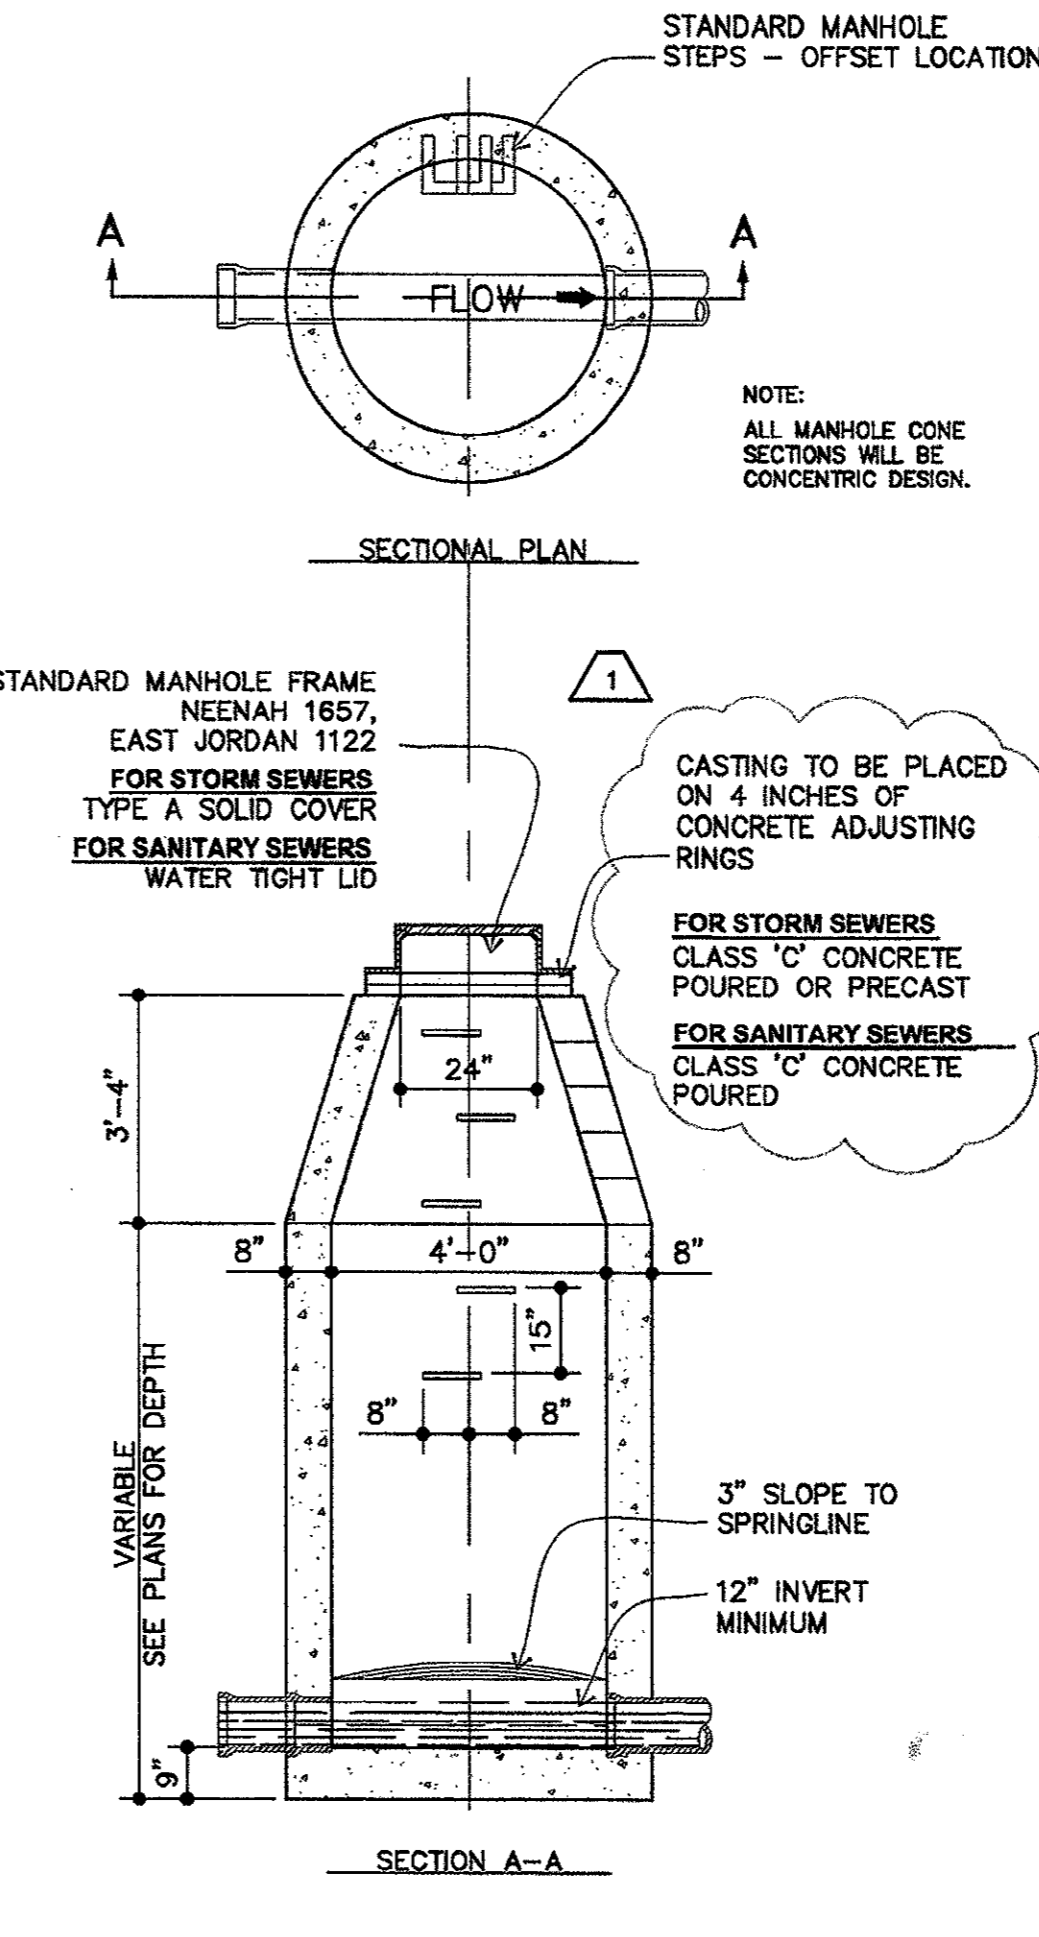

07 SANITARY SEWER MANHOLE
SCALE: NONE

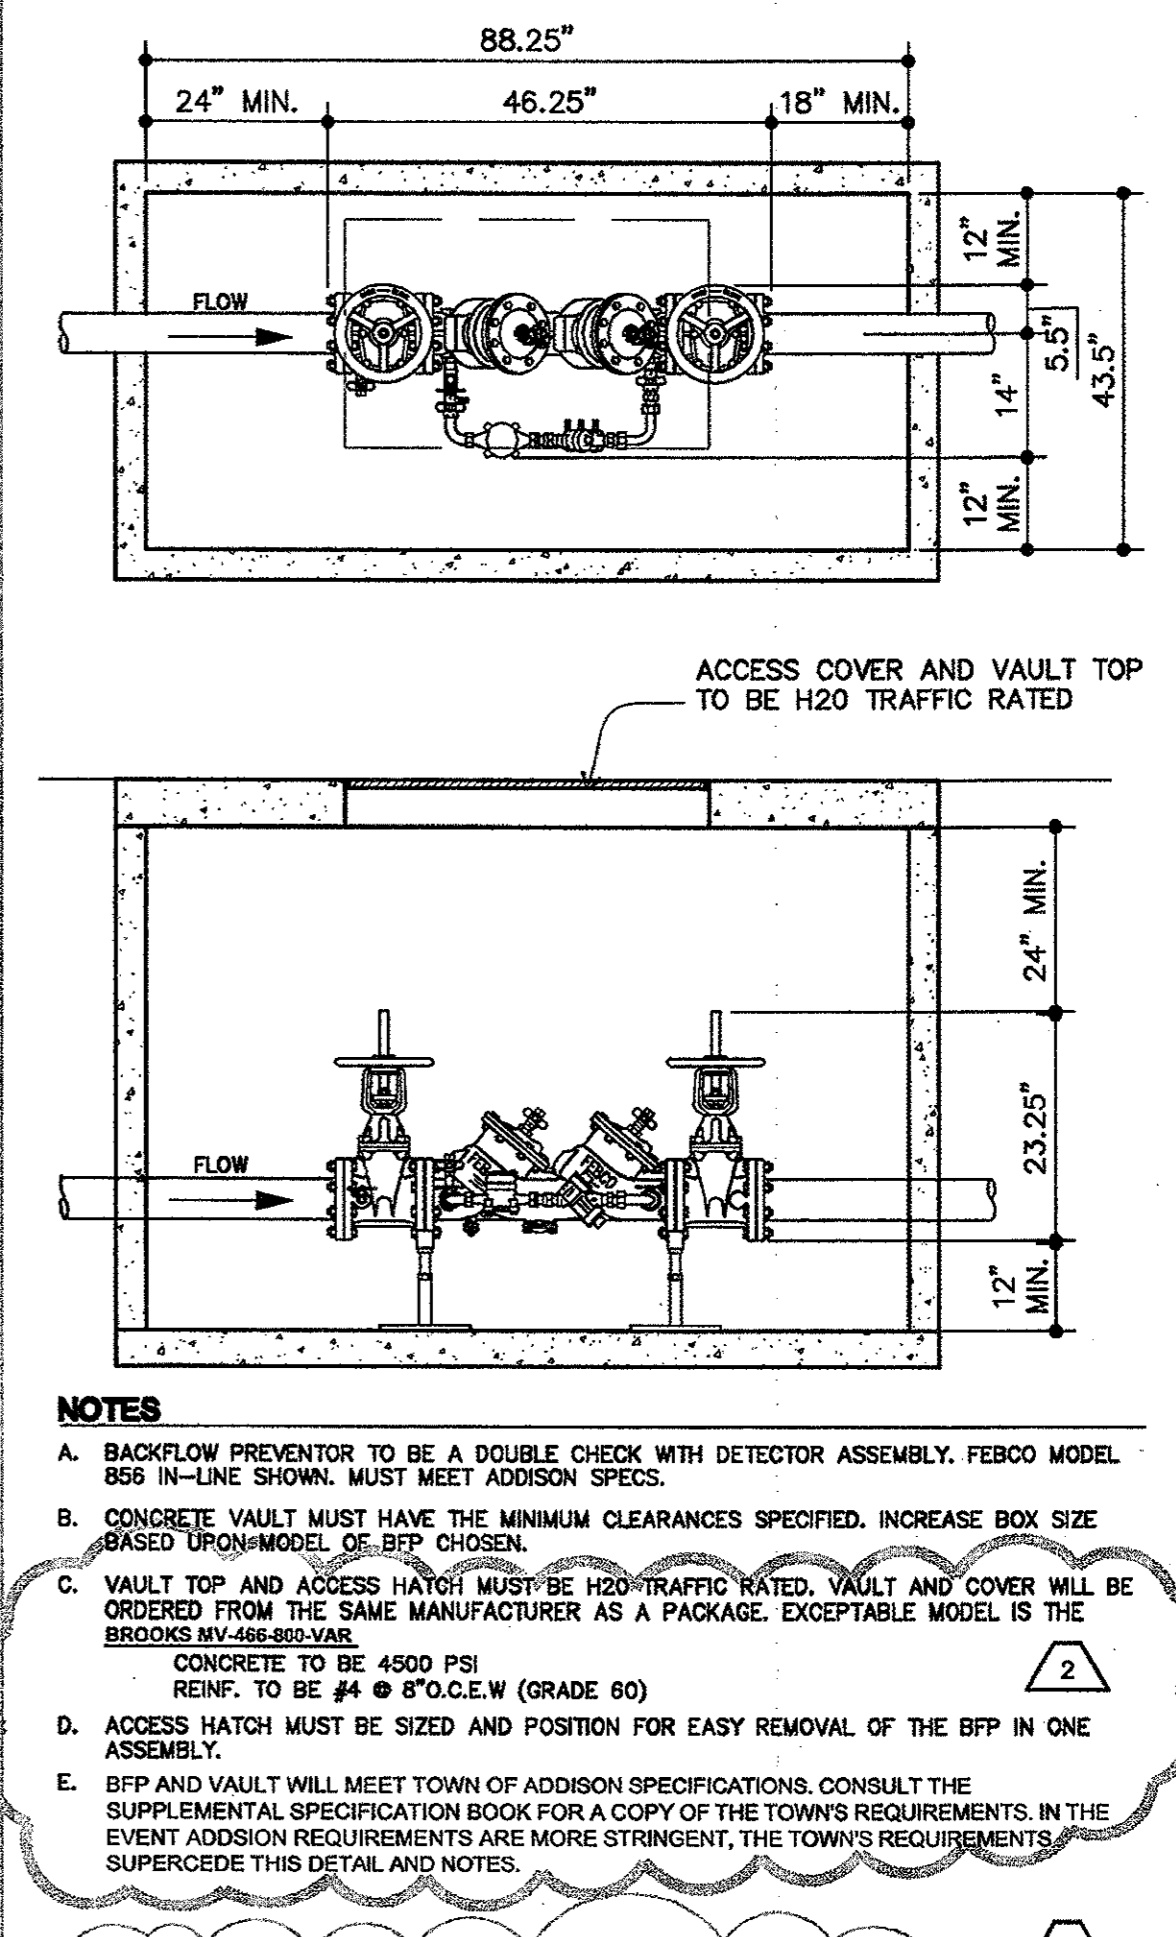

08 BACKFLOW PREVENTER
SCALE: NONE

GENERAL NOTES:

1. IN GENERAL, INLET REINFORCING STEEL SHALL BE #4 BARS ON 12" CENTERS BOTH WAYS FOR GUTTER, BOTTOM SLAB ENDS, FRONT AND BACK WALLS, AND #4 BARS ON 6" CENTERS BOTH WAYS FOR TOP SLAB. AN ADDITIONAL #6 BAR SHALL BE PLACED IN THE FRONT EDGE OF THE TOP SLAB IN THE INLETS AND ADDITIONAL STEEL SHALL BE PLACED AROUND MANHOLES AS SHOWN.
2. ALL REINFORCING STEEL SHALL BE GRADE 60.
3. ALL CONCRETE SHALL BE CLASS "A". ALL EXPOSED CORNERS SHALL BE CHAMFERED 3/4".
4. ALL REINFORCING STEEL SHALL HAVE A MINIMUM COVER OF 2" TO THE CENTERS OF THE BARS.
5. 10'-0" OF EXISTING CURB AND GUTTER UPSTREAM AND 10'-0" OF EXISTING CURB AND GUTTER DOWNSTREAM SHALL BE REMOVED AND REPAIRED INTEGRALLY WITH EACH INLET.
6. ALL BACK FILLING SHALL BE COMPACTED TO 95% STANDARD PROCTOR DENSITY.
7. CENTER BEAM IS REQUIRED FOR ALL INLET OPENINGS GREATER THAN 10'-0".
8. TWO MANHOLE FRAMES AND COVERS ARE REQUIRED WHEN INLET OPENING IS GREATER THAN 10'-0".
9. ALL INLET FLOORS ARE TO HAVE A 2% SLOPE TOWARDS THE OUTLET PIPE.
10. MINIMUM INLET OPENING SIZE IS 5'-0".
11. MAXIMUM INLET OPENING SIZE IS 20'-0".
12. OUTLET PIPE TO BE PLACED AT LOWEST END OF FLOOR INLET. MANHOLE COVER TO BE PLACED ABOVE OUTLET END OF INLET.
13. MANHOLE FRAME AND COVER SHALL BE CAST IRON, VULCAN V-1874 OR BASS AND HAYES PATTERN 103 OR APPROVED EQUAL.
14. MANHOLE COVERS SHALL HAVE CHAINS ATTACHED TO PREVENT COVERS FROM BEING WASHED AWAY DURING FLOOD CONDITIONS.

wd partners

2350 Valley View Lane
Suite 100
Dallas, Texas 75234-5734
T 214.351.5400
F 214.351.2095
info@wdpartners.com
wdpartners.com

Dallas
Columbus
Los Angeles
Chicago
Miami

Two Stars

17225 Dallas Parkway
Addison, TX

STATE OF TEXAS
SCOTT LEWIS GRAVES
98150
LICENSED PROFESSIONAL ENGINEER
1/21/03

REVISIONS

- 1 12/19/02 (City)
- 2 01/24/03 (City)

PROTOTYPE

STORE NUMBER

WD PROJECT NUMBER
0000.659-00

C4.1 UTILITY DETAILS