



V.K.D. Inc. August 28, 1984  
 30' Easement For 84" Water Main  
 From Sta. 100+46.9' To Sta. 105+36.2'  
 Block 8178  
 Temporary Working Space Granted  
 C.O.  
 Vol: Pg: Date:

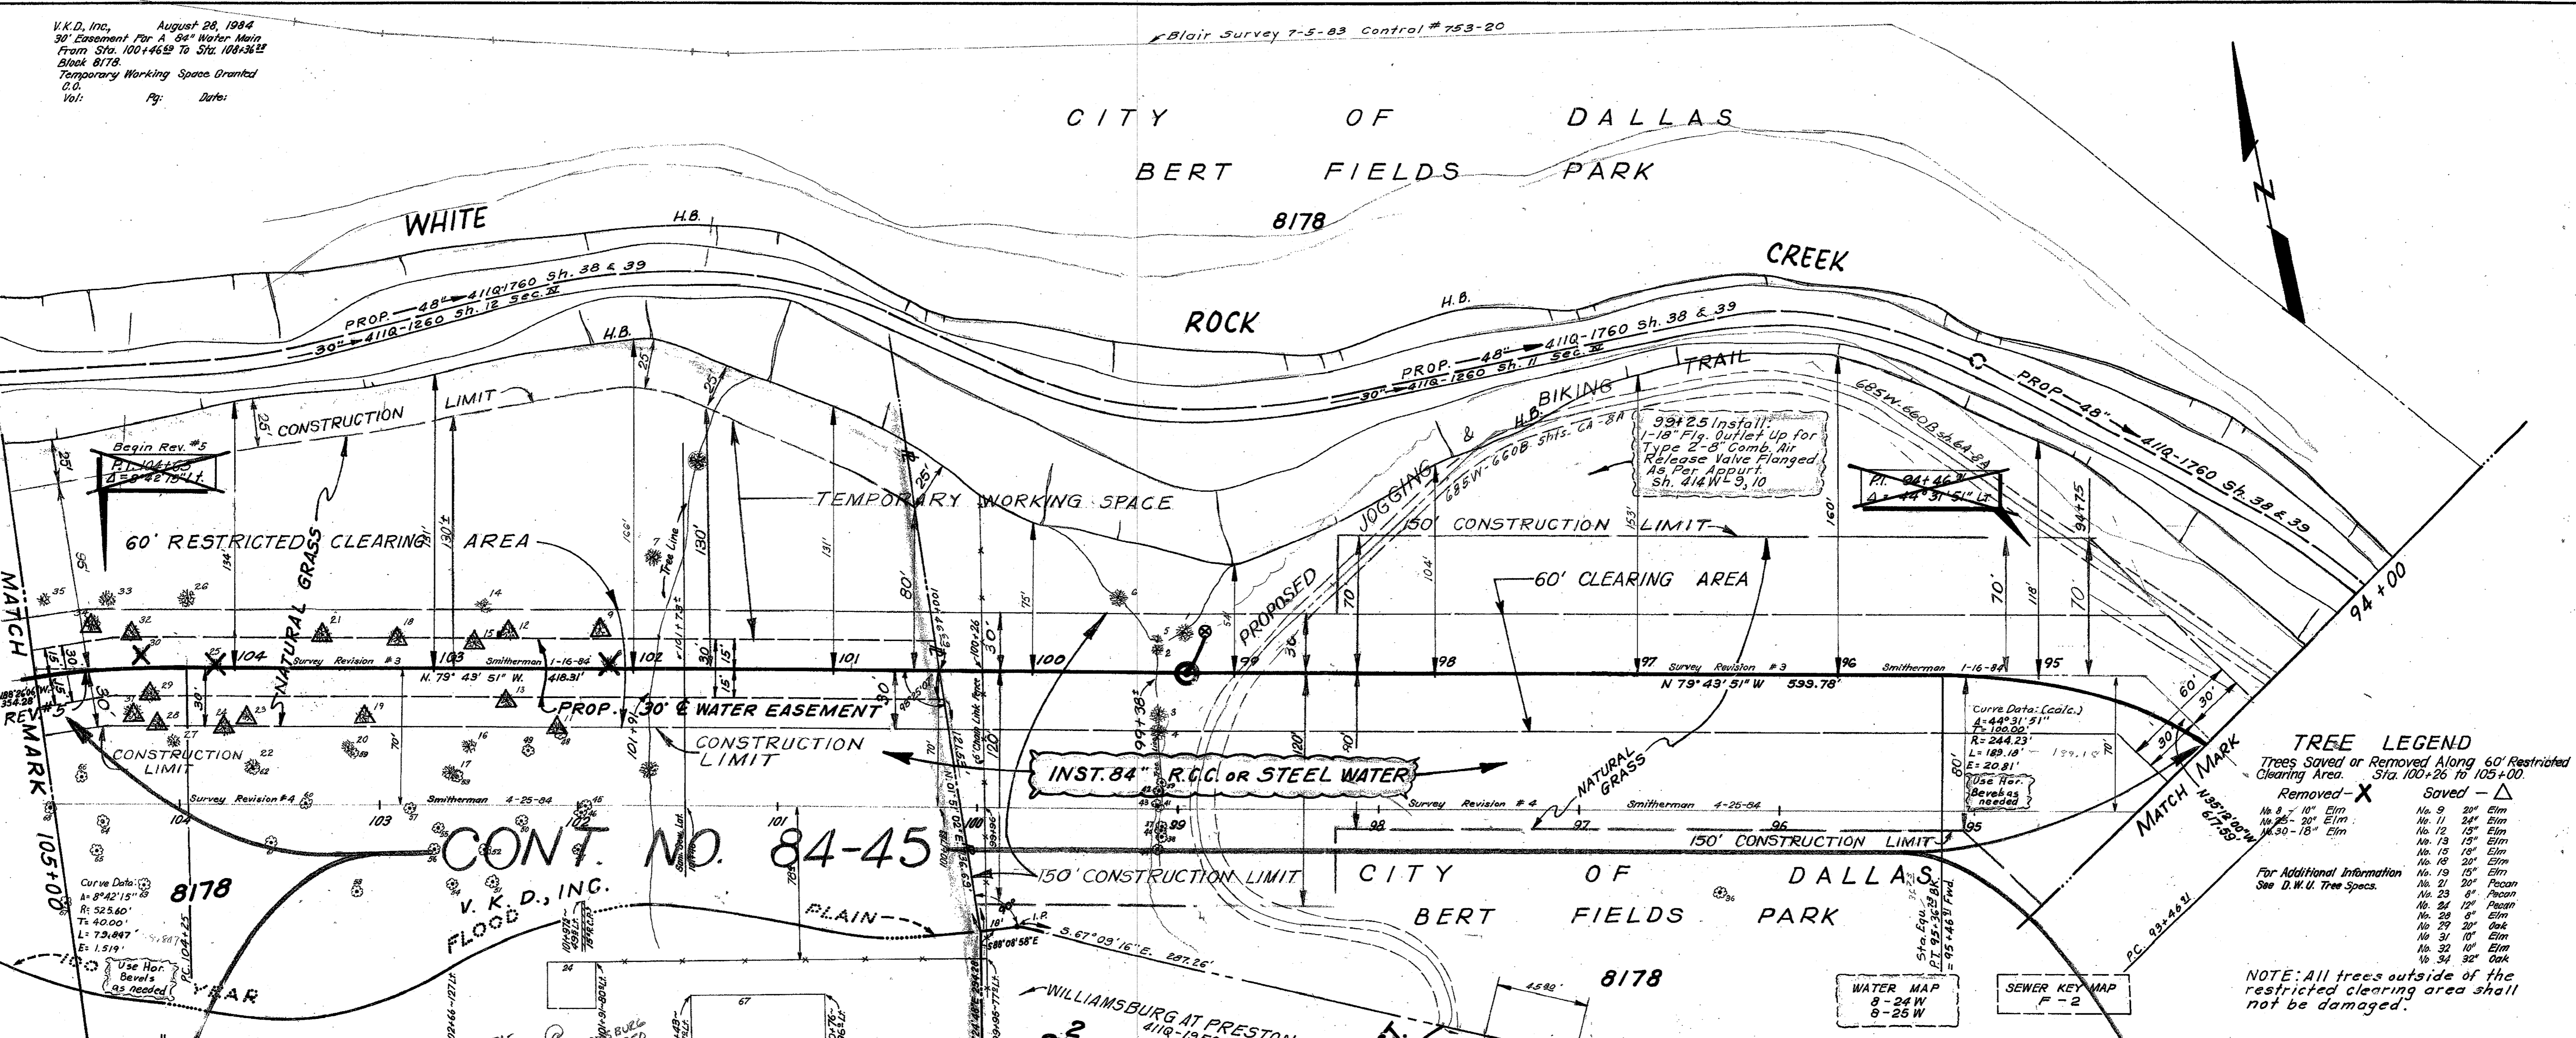


**TREE LEGEND**  
 Trees Saved or Removed Along 60' Restricted Clearing Area. Sta. 100+26 to 105+00.

Removed - X	Saved - Δ
No. 9	20" Elm
No. 11	24" Elm
No. 12	15" Elm
No. 13	15" Elm
No. 15	15" Elm
No. 18	20" Elm
No. 19	20" Elm
No. 21	20" Pecan
No. 23	8" Pecan
No. 24	12" Pecan
No. 28	8" Elm
No. 29	20" Oak
No. 31	10" Elm
No. 32	10" Elm
No. 34	32" Oak

For Additional Information See D.W.U. Tree Specs.

NOTE: All trees outside of the restricted clearing area shall not be damaged.

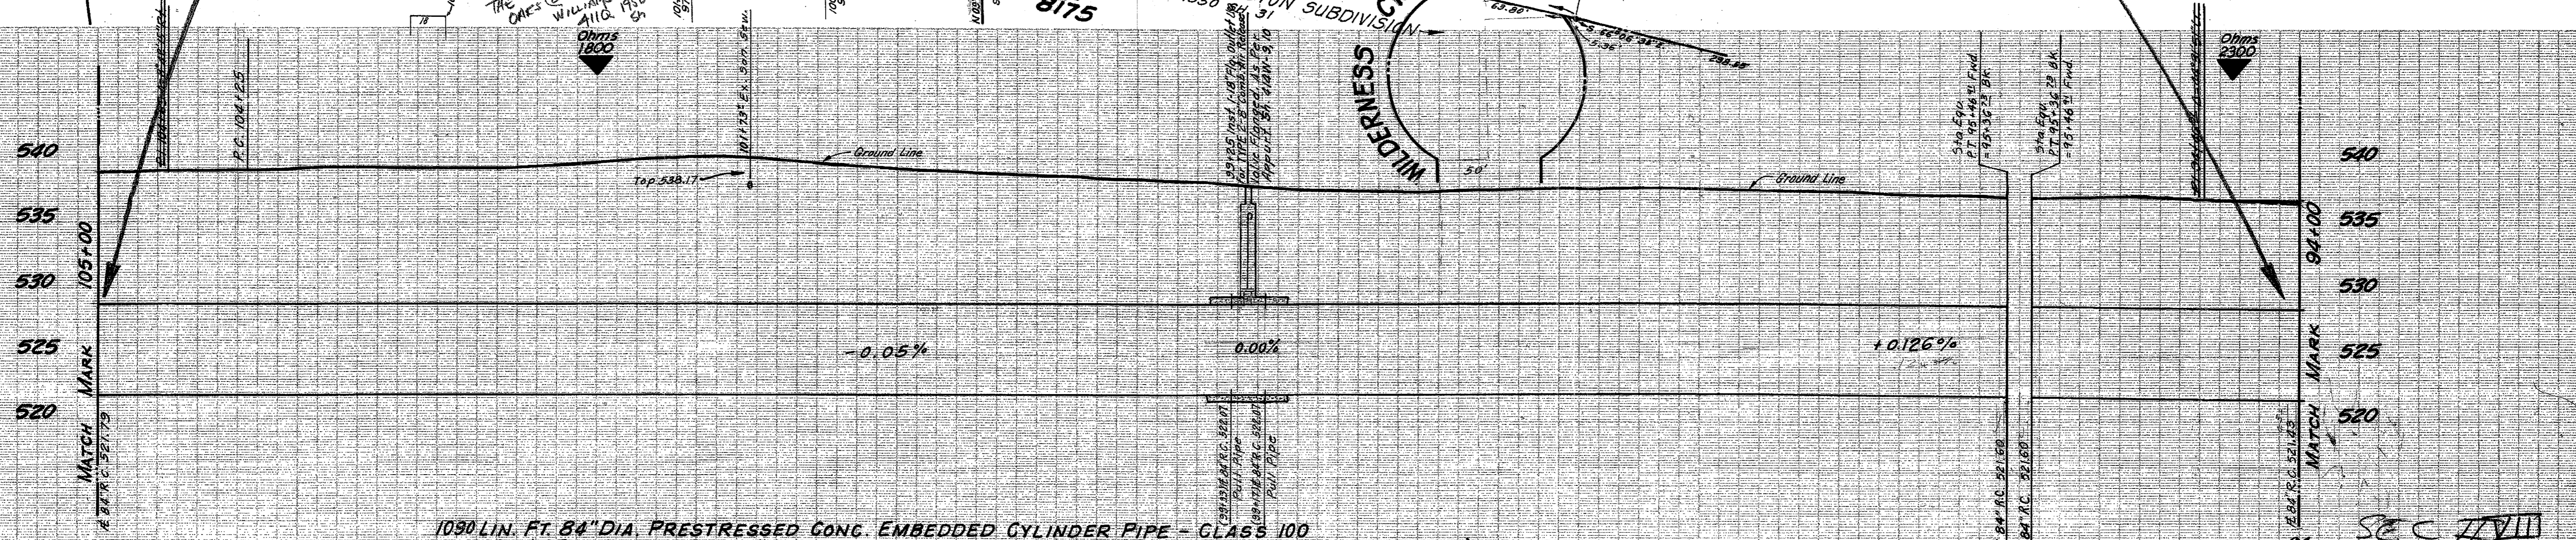


1090 LIN. FT. 84" DIA. PRESTRESSED CONC. EMBEDDED CYLINDER PIPE - CLASS 100  
 ALTERNATE: 1090 LIN. FT. 84" DIA. STEEL PIPE (AS PER PART "T" SPECIAL SPECIFICATIONS)

B.M. "X" Cut in Top Conc. Curb on S. Survey  
 N. Curb SPRING VALLEY RD @ 454.1 E.  
 End of Bridge over WHITE ROCK CREEK  
 Elev. 548.04

B.M. Sta. W.D.B.M. on S.E. Cor. of Conc. Bridge  
 of WHITE ROCK CREEK & PRESTON ROAD  
 Elev. 554.05

T.B.M. Top L.R. of Sta. 115+54.35  
 of Original Survey  
 Elev. 541.62

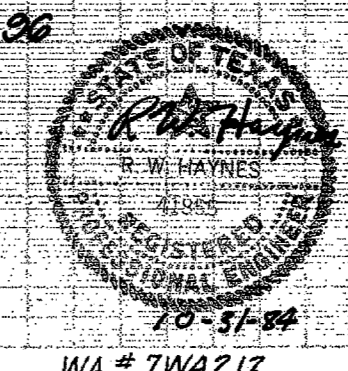

84" R.C. WATER MAIN					
ALONG WHITE ROCK CREEK					
FROM SPRING VALLEY TO DALLAS N. PKWY.					
DALLAS WATER UTILITIES DEPT.					
CITY OF DALLAS, TEXAS					
DESIGN	DRAWN	DATE	SCALE	NOTES	FILE NO.
M. PEREZ	H. WATTS	JAN. '84	Hor. 1"=40' Vert. 1"=6'		685W660B