



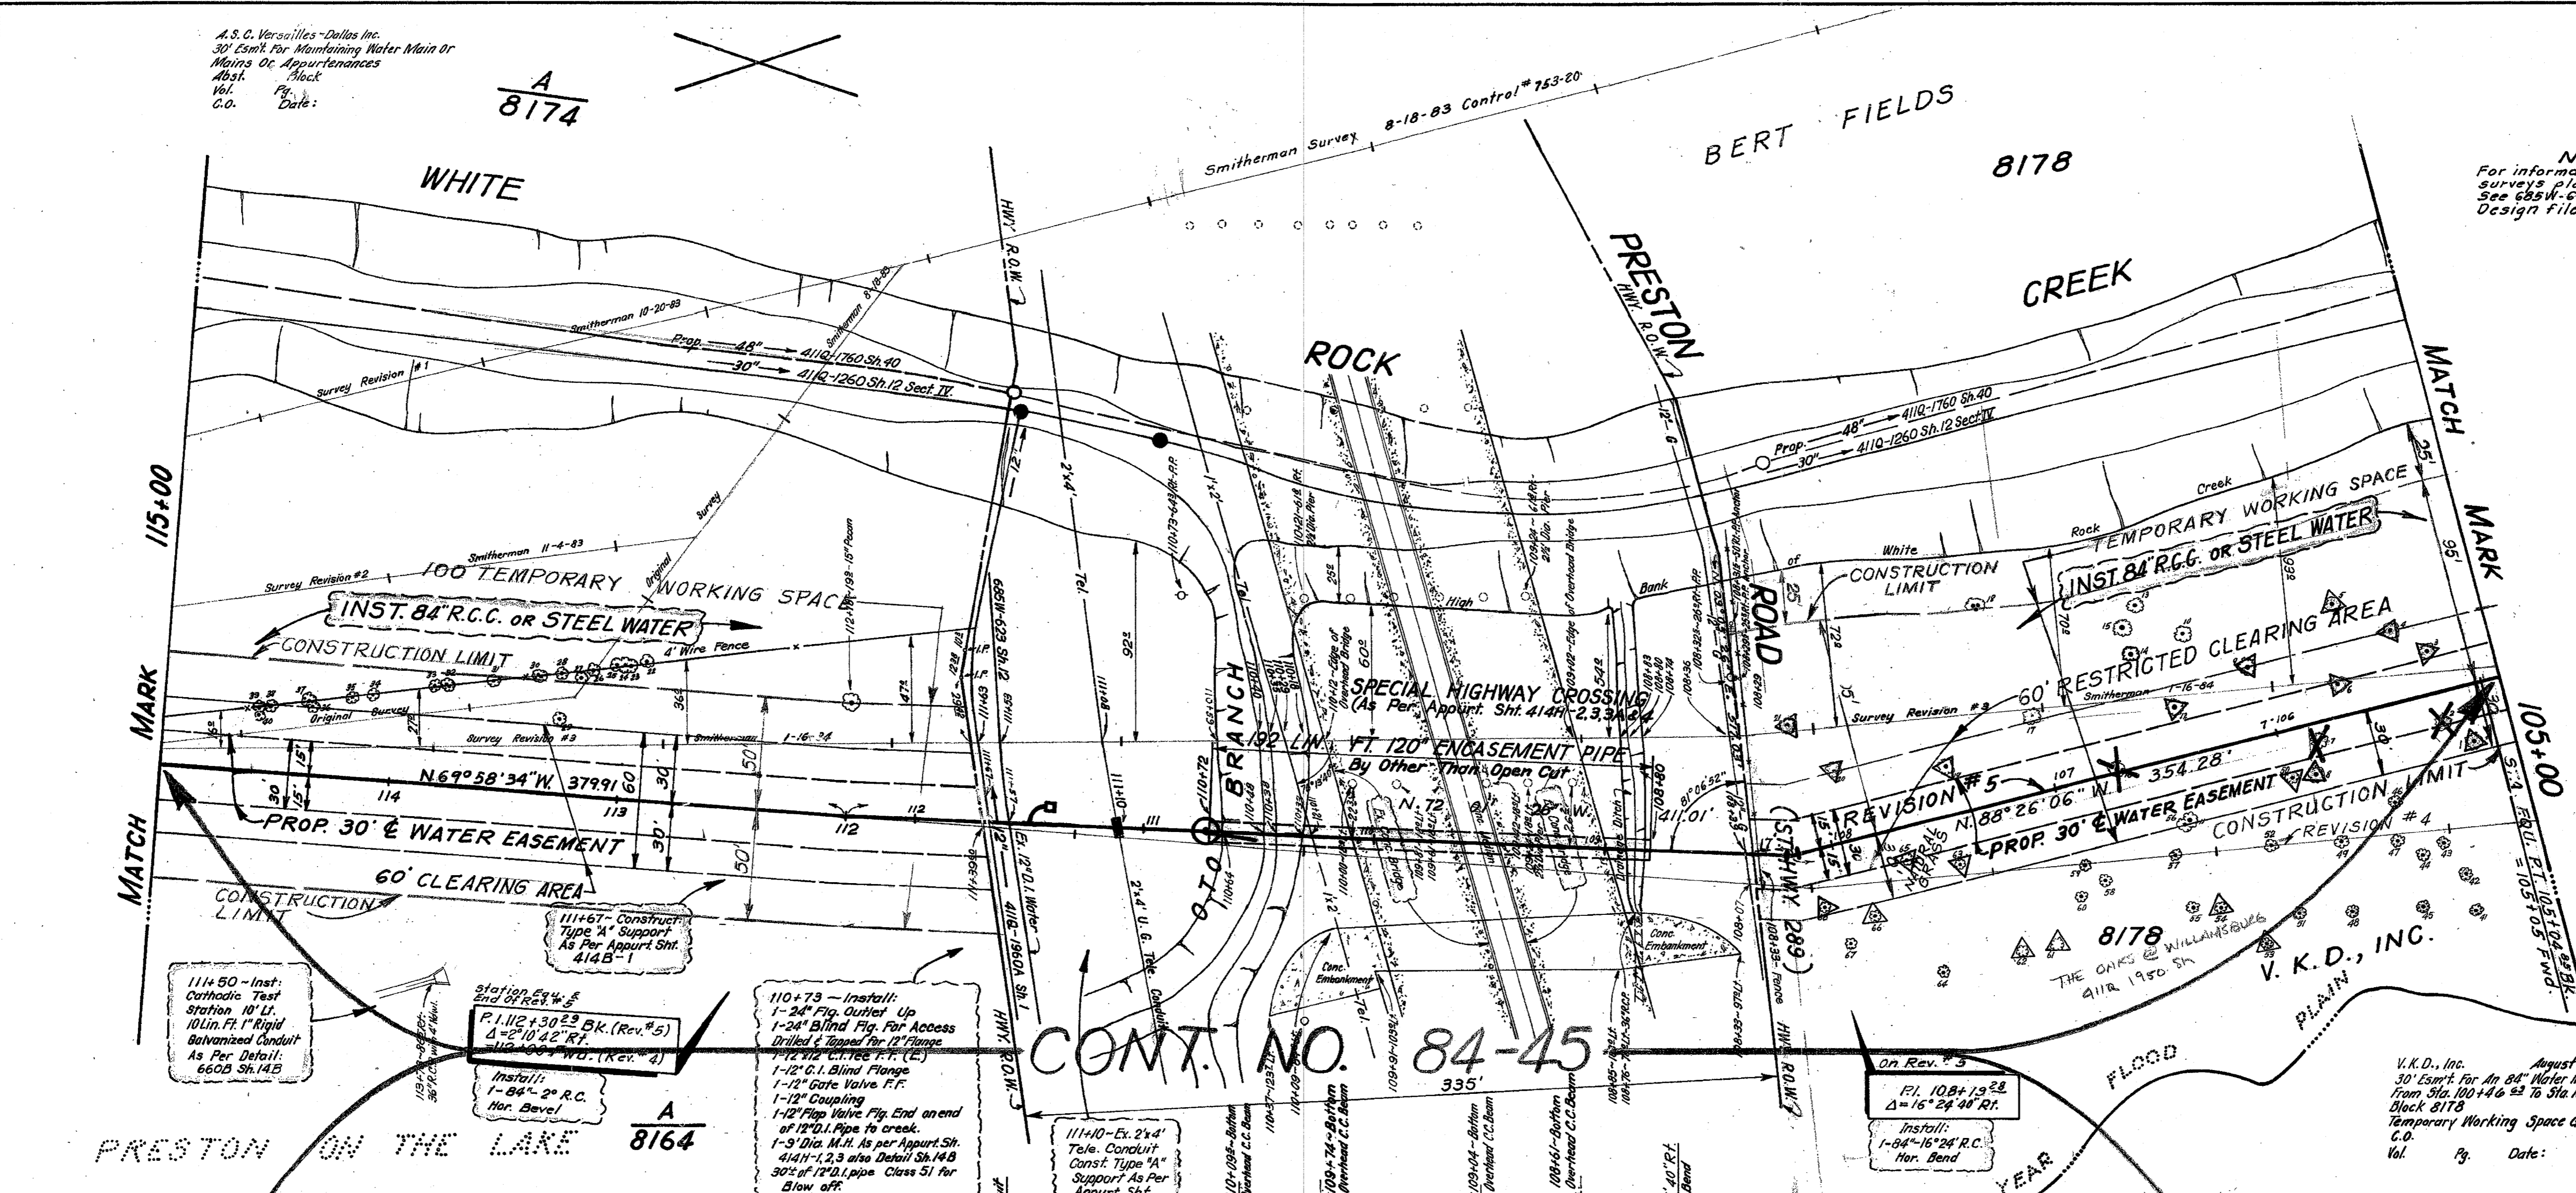


**NOTE:**  
For information on additional surveys plotted on this line, see 685W-660B folder in Water Design Files.

**STATE DEPARTMENT OF HIGHWAYS & PUBLIC TRANSPORTATION APPROVAL**  
For an 84" Water Main Within the R.O.W. of Preston Road State Highway 289 Contractor is to Contact James Simmons Telephone (214) 235-3314 at least 48 Hours Prior to Starting Construction in Order that they may have a Representative Present.  
Date: July 17, 1984. Expiration Date: January 17, 1985. Permit # 704079 Control 31 Section 6.

**TREE LEGEND**  
Trees Saved or Removed Along 60' Restricted Clearing Area. Sta. 105+00 to 108+10'

Removed - X	Saved - Δ
No. 2 - 6" Elm	No. 1 - 24" Oak
No. 7 - 10" Elm	No. 3 - 20" Oak
No. 16 - 15" Elm	No. 4 - 18" Elm
	No. 6 - 24" Ash
	No. 8 - 10" Elm
	No. 9 - 24" Ash
	No. 11 - 36" Sycamore Tree 36" Oak
	No. 12 - 20" Elm
	No. 15 - 20" Elm
	No. 20 - 20" Pecan
	No. 63 - 20" Pecan
	No. 65 - 20" Elm
	No. 68 - 10" Hackberry
	No. 5 - 20" Elm
	No. 21 - 20" Pecan
	No. 59 - 24" Oak
	No. 54 - 30" Oak
	No. 61 - 15" Elm
	No. 62 - 12" Ash
	No. 66 - 30" Oak

For Additional Information See D.W. Tree Specs.

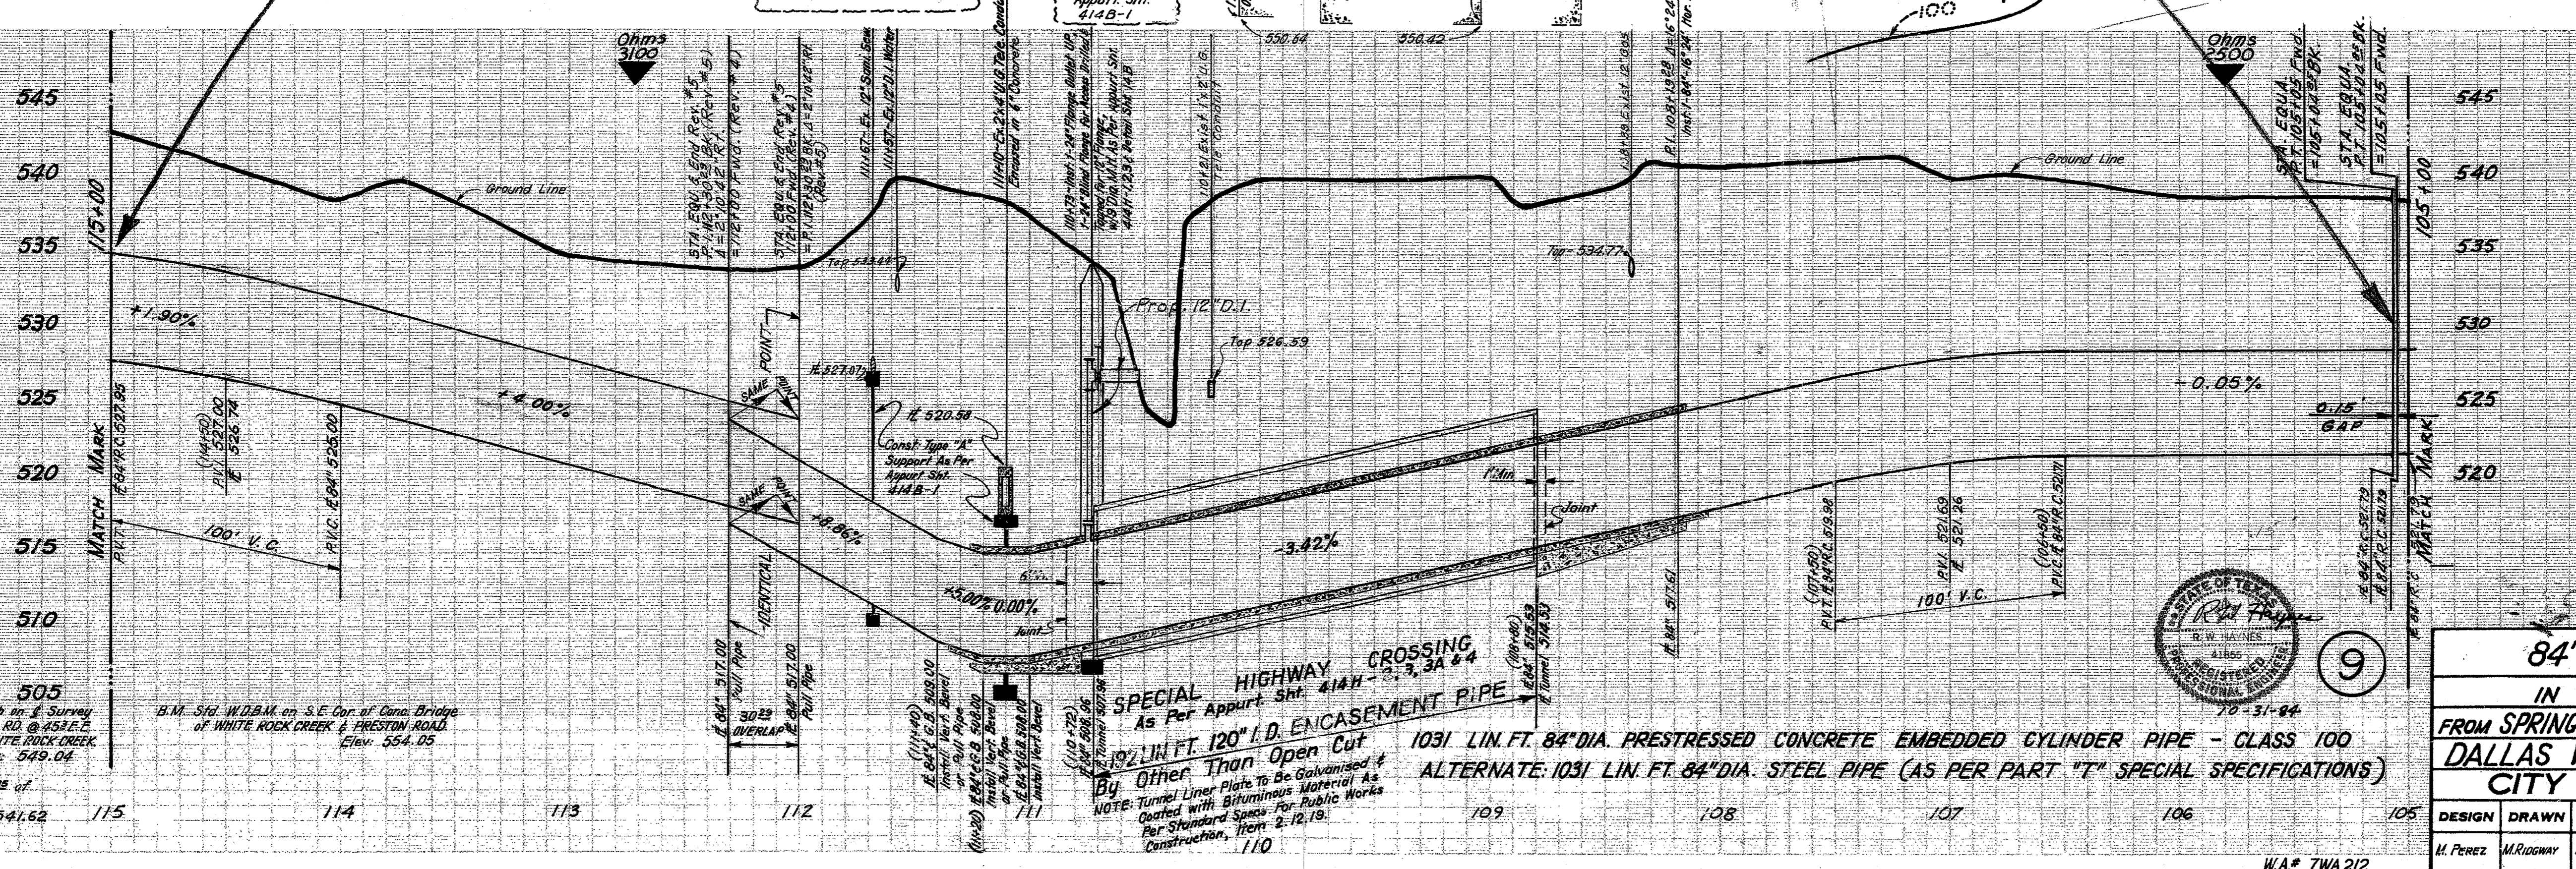

**SEWER KEY MAP F-2**      **WATER MAP 8-24W**

**84" R.C. WATER MAIN**  
**IN CELESTIAL ROAD**  
**FROM SPRING VALLEY TO DALLAS N. PKWY.**  
**DALLAS WATER UTILITIES DEPT.**  
**CITY OF DALLAS, TEXAS**

DESIGN	DRAWN	DATE	SCALE	NOTES	FILE	NO.
M. Perez	M. Rogay	Feb. 1984	1/4" = 10'		685W 660B	