

TREE LIST


No.	Sta.	Lt.	Rt.	Spec.	Description
83	140750	88	0'	6"	Hickberry
84	140750	145	0'	6"	Pine Oak
85	140750	152	0'	6"	Pine Oak
86	140750	172	0'	6"	Pine Oak
87	140750	182	0'	6"	Pine Oak
88	140750	182	0'	6"	Hickberry
89	140750	182	0'	6"	Hickberry
CONT. # 84-45
CITY OF ADDISON

NOTE!
 * Install:
 430 L.F. OF Temp. 2" Water Line Above The Ground,
 Prior To The Const. Of The 84" Water Main.
 * Conn. Ex. House Services To The Temp. Line.
 * #5505, #5510, #5434, Will Be Served From The
 2" Temp. Line During The Const. Time.
 * Cut & Plug Ex. 8" Water East Of Ex. Tee Station
 149+44.52.

JHY Corporation
 A Texas Corporation
 100' Temp. Working Space For The 84" Water Main
 From Sta. 143+20.1 To Sta. 149+57.5
 Abst. No. 157, S.H. 5102
 In The City Of Addison
 C.O.:
 Vol. 84112 Pg. 351 Date:

WATER MAP
 8 - 23 W
 SEWER KEY MAP
 F-2

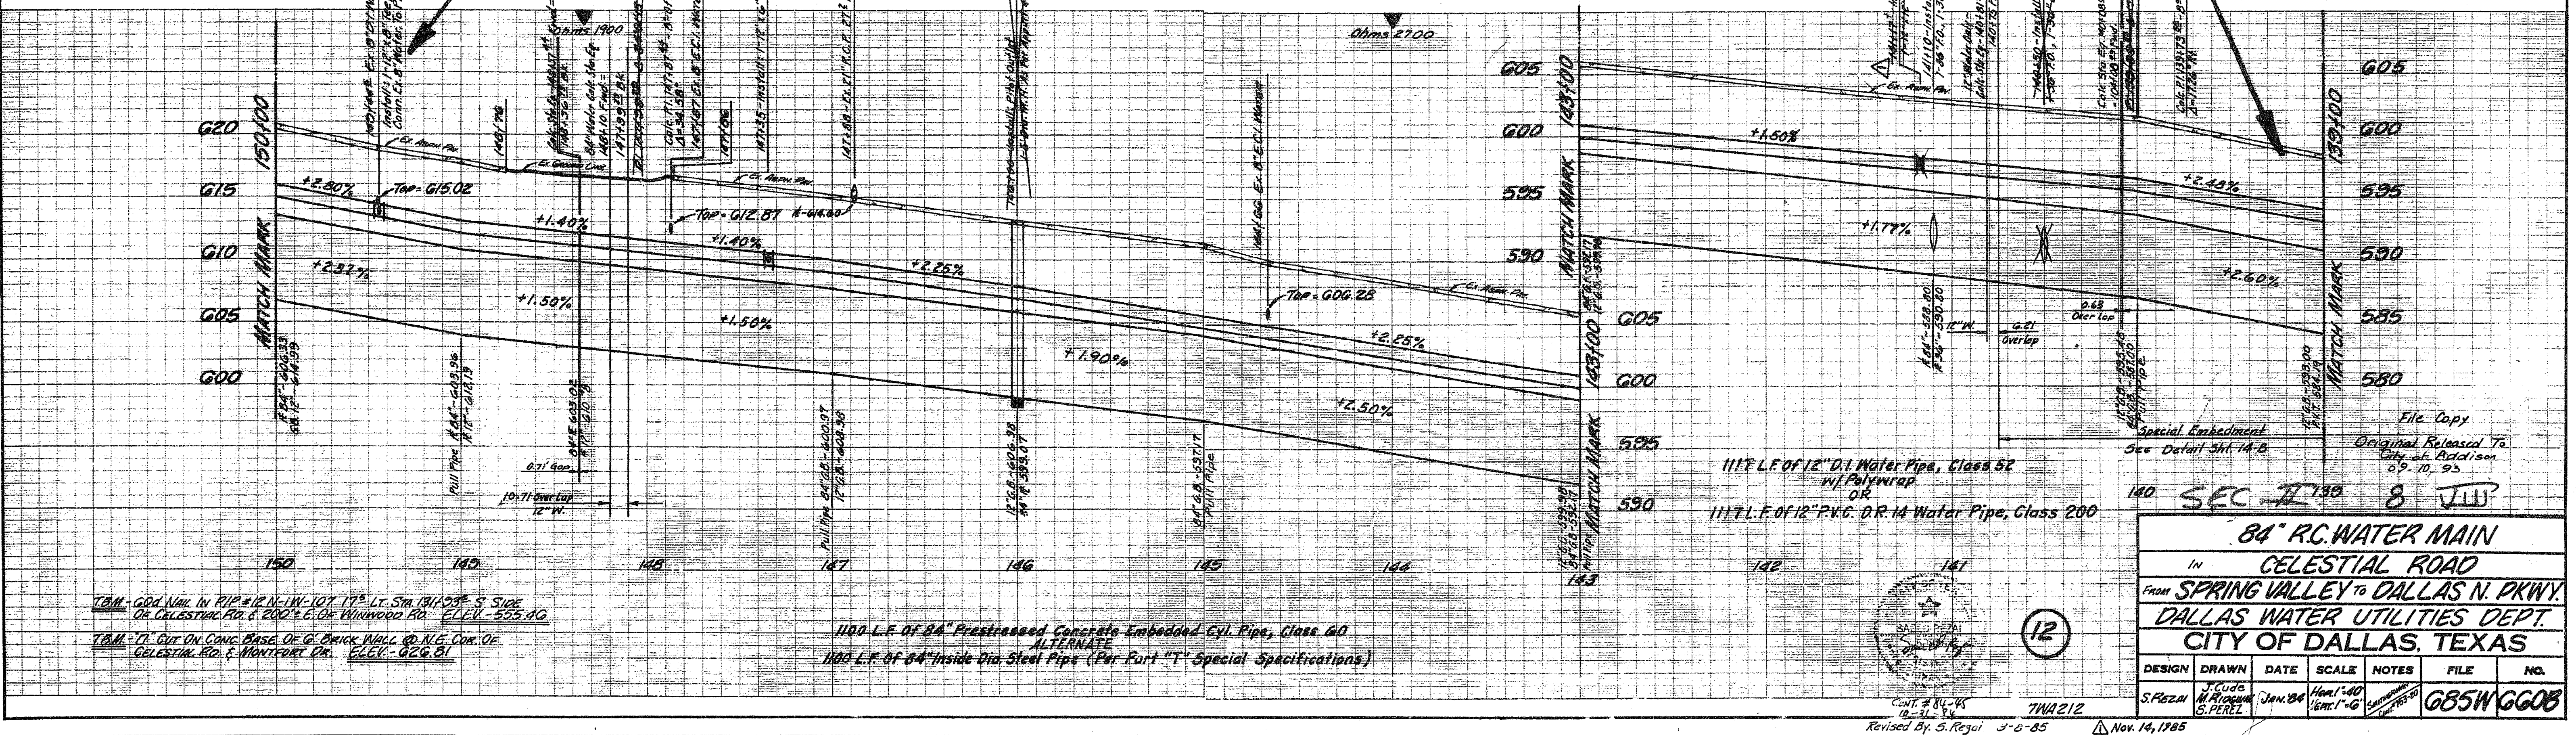

84" R.C. WATER MAIN
 IN **CELESTIAL ROAD**
 FROM **SPRING VALLEY TO DALLAS N. PKWY.**
DALLAS WATER UTILITIES DEPT.
CITY OF DALLAS, TEXAS

DESIGN	DRAWN	DATE	SCALE	NOTES	FILE	NO.

