


TREE LIST

Sta.	HT.	LT.	Size	Description
152778	50	12	12"	Bois D'Arc
152781	12	12	12"	Bois D'Arc
152782	43	12	12"	Cluster Hackberry
152783	43	12	12"	Hackberry
152784	43	12	12"	Hackberry
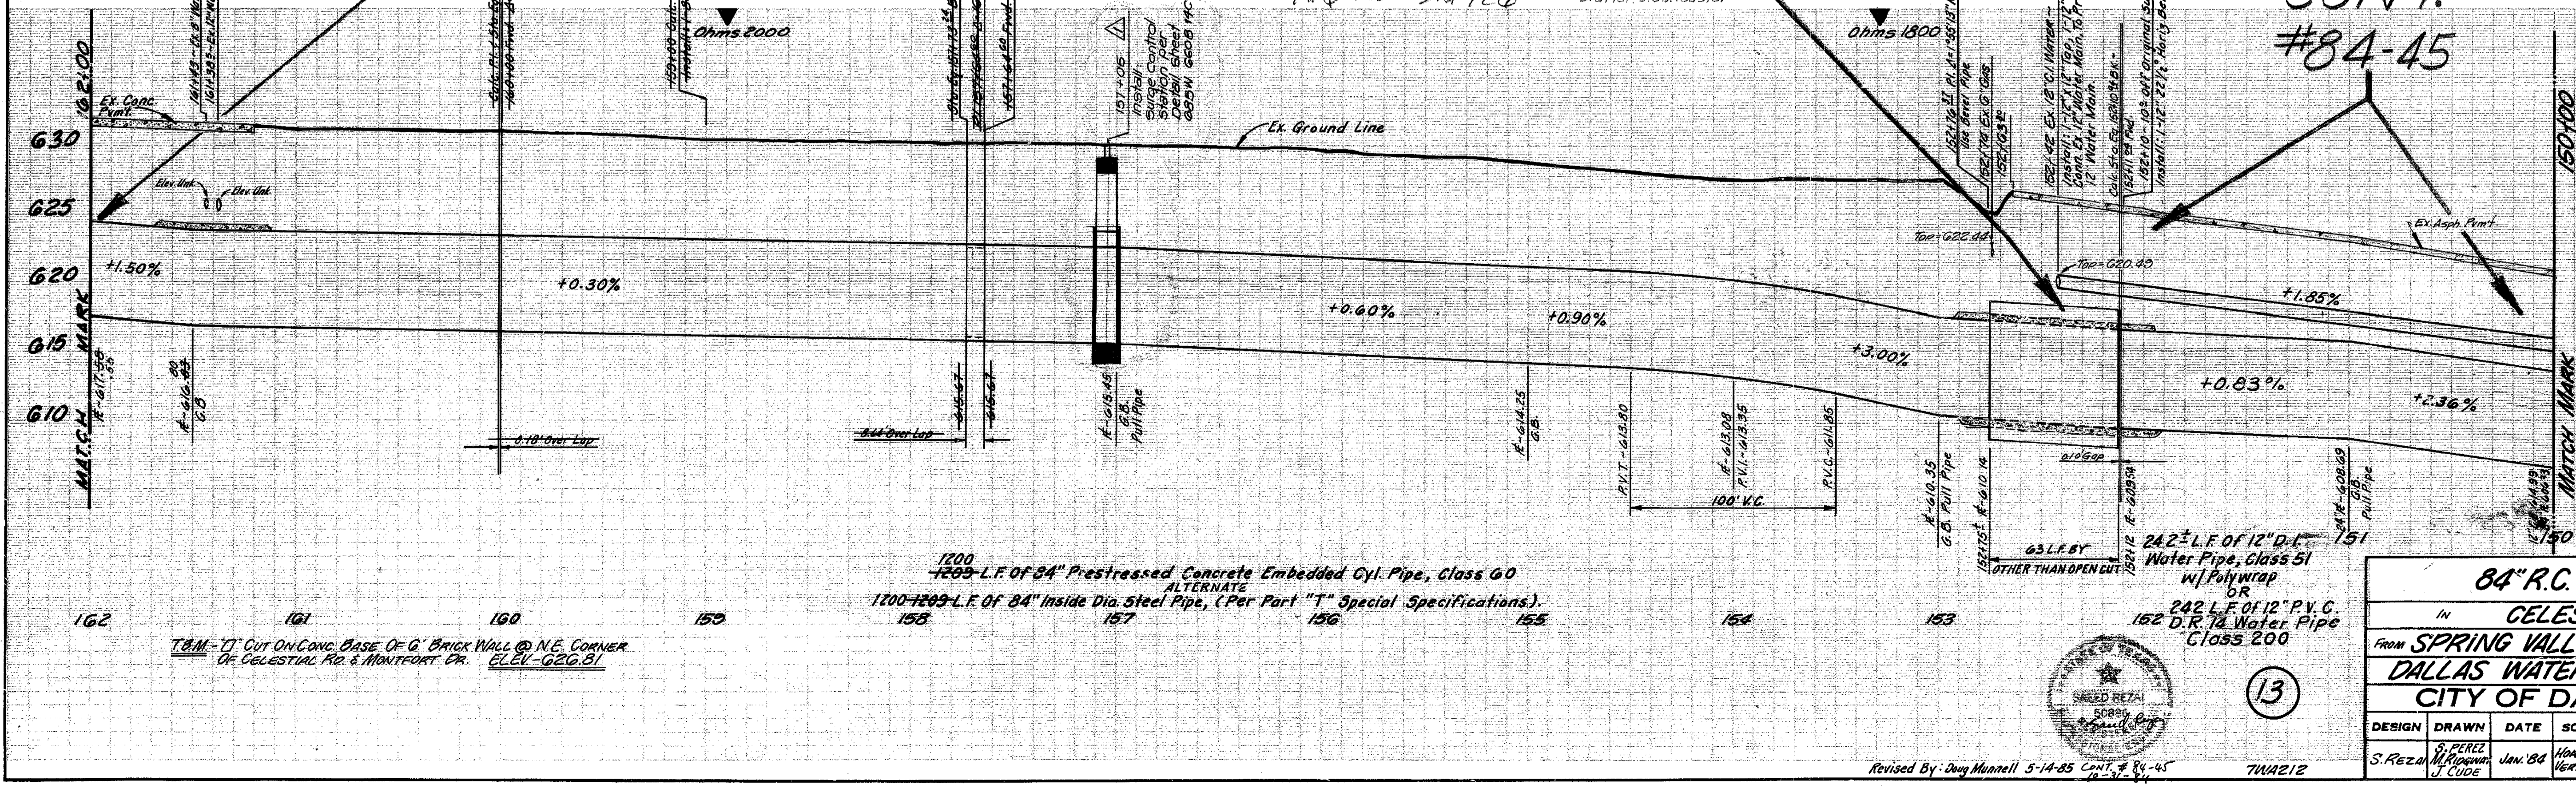

Revised June 20, 1989
 Design - George Prall
 Design - Larry
 Cont. No. 89-217

STATE OF TEXAS
REGISTERED PROFESSIONAL ENGINEER
162709

84" R.C. WATER MAIN
 IN CELESTIAL ROAD
 FROM SPRING VALLEY TO DALLAS N. PKWY.
 DALLAS WATER UTILITIES DEPT.
 CITY OF DALLAS, TEXAS

DESIGN	DRAWN	DATE	SCALE	NOTES	FILE	NO.
	J. CUDE					

Revised By: Doug Munnell 5-14-85 Cont. # 84-45
 TWA212