


Sta.	Lt.	Rt.	Size	Description	
1	99+25	201	6"	Hackberry	
2	99+37	119	8"	Hackberry	
3	99+37	291	8"	Hackberry	
4	99+37	291	8"	Hackberry	
5	99+37	291	8"	Hackberry	
6	99+35	988	12"	Hackberry	
7	101+31	580	20"	Oak	
8	101+31	21	20"	Elm	
9	102+16	20	20"	Elm	
10	102+38	31	24"	Elm	
11	102+38	31	17"	15"	Elm
12	102+64	16	31"	18"	Elm
13	102+64	16	31"	18"	Elm
14	102+64	16	31"	18"	Elm
15	102+79	15	18"	Elm	
16	102+80	40	10"	Hackberry	
17	102+91	53	10"	Elm	
18	103+18	16	20"	Elm	
19	103+36	24	15"	Elm	
20	103+36	24	15"	Elm	
21	103+56	17	20"	Pecan	
22	103+56	17	20"	Pecan	
23	103+56	17	20"	Pecan	
24	104+04	30	12"	Pecan	
25	104+09	1	20"	Elm	
26	104+23	34	8"	Elm	
27	104+30	38	20"	Elm	
28	104+38	28	8"	Elm	
29	104+45	13	18"	Elm	
30	104+45	13	18"	Elm	
31	104+50	24	10"	Elm	
32	104+51	17	15"	Elm	
33	104+63	33	32"	Oak	
34	104+72	21	32"	Oak	
35	104+72	21	32"	Oak	
 30' Easement For A 36" Water Main  
 From Sta. 100+46.59 To Sta. 104+36.12  
 Block 8178.  
 Temporary Working Space Granted  
 O.O. Vol. Pg. Date:

Blair Survey 7-5-83 Control # 753-20

CITY OF DALLAS  
 BERT FIELDS PARK

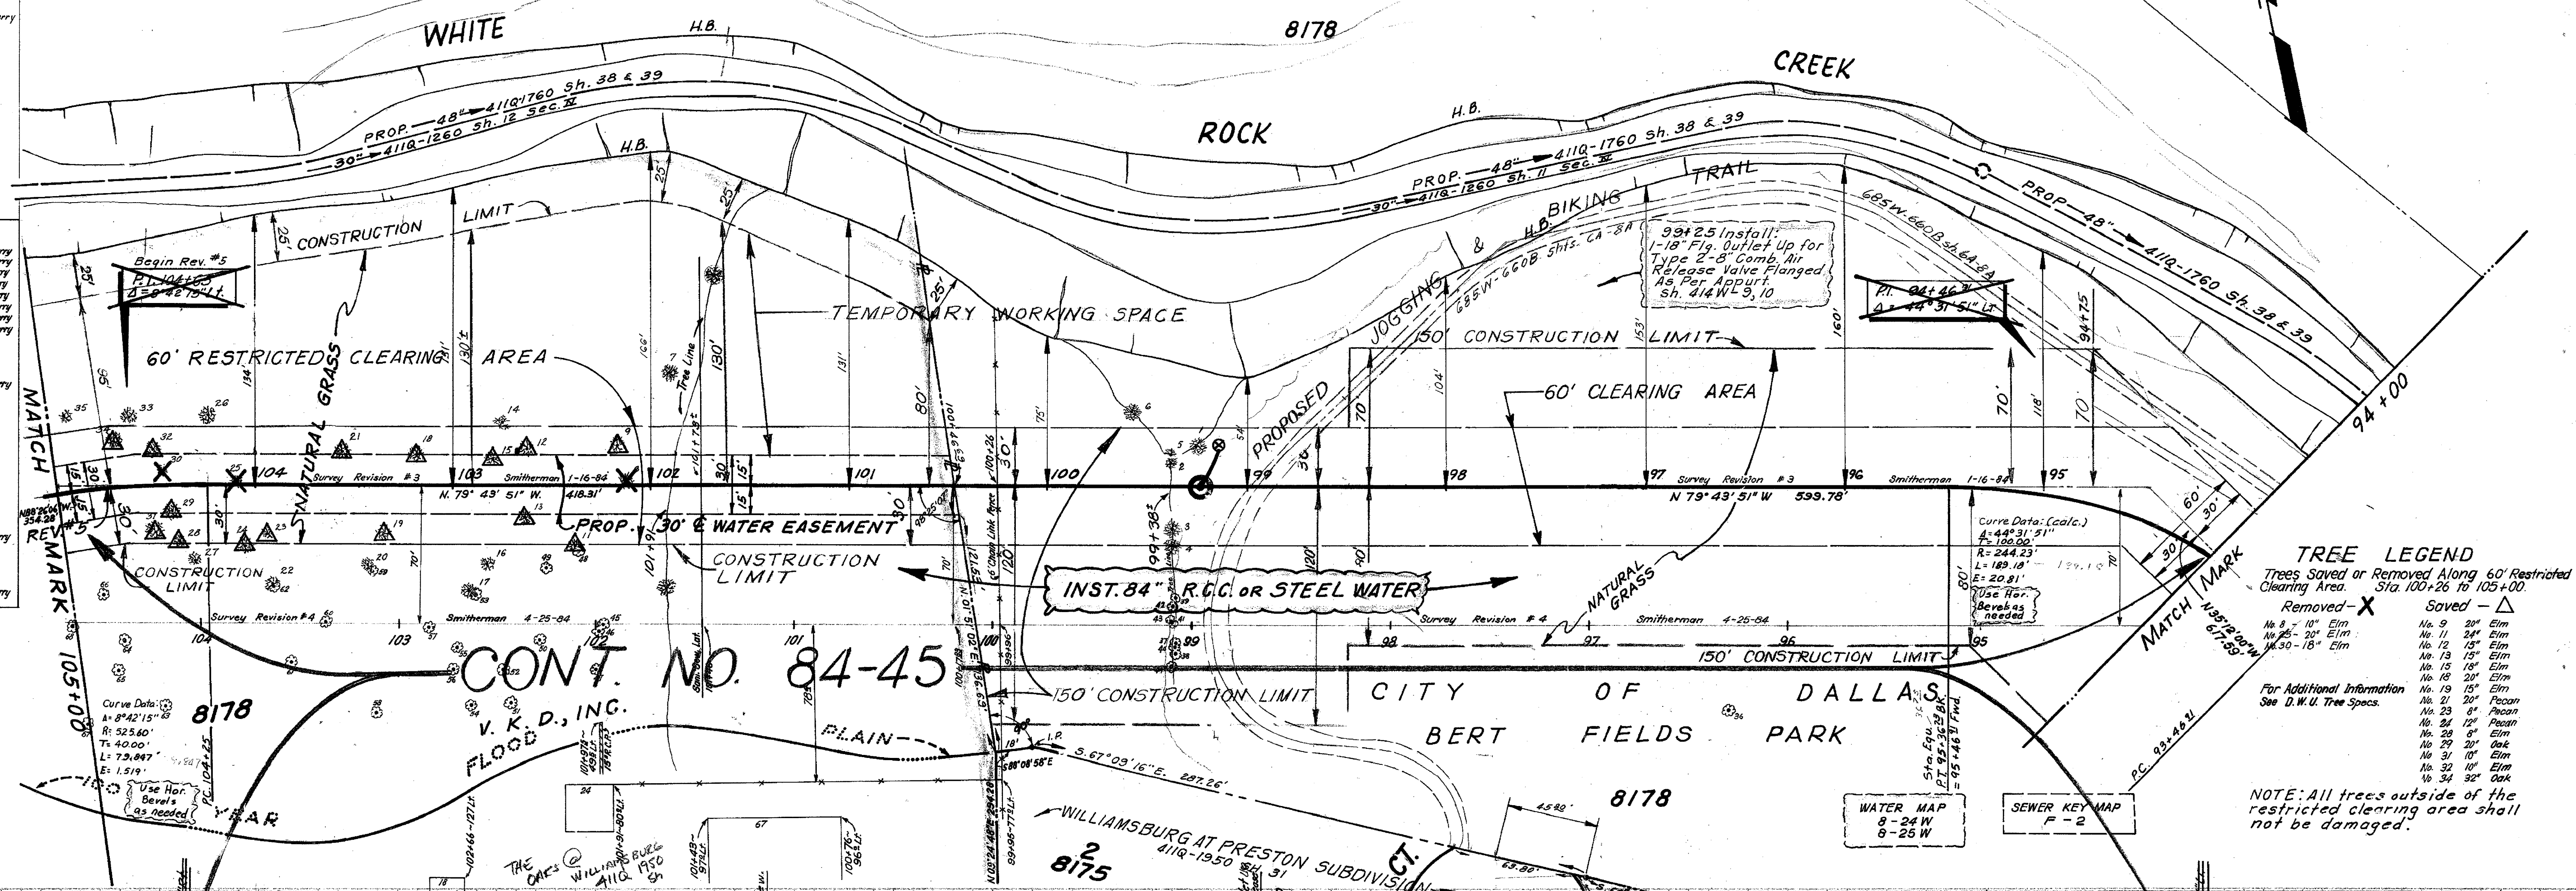

**TREE LEGEND**

Trees Saved or Removed Along 60' Restricted Clearing Area. Sta. 100+26 to 105+00.


Removed - X	Saved - Δ
No. 8 - 10' Elm	No. 9 - 20' Elm

For Additional Information See D.W.U. Tree Specs.

NOTE: All trees outside of the restricted clearing area shall not be damaged.

CONT. NO. 84-45  
 V.K.D., INC.  
 FLOOD PLAIN

WATER MAP 8-24 W 8-25 W  
 SEWER KEY MAP F-2

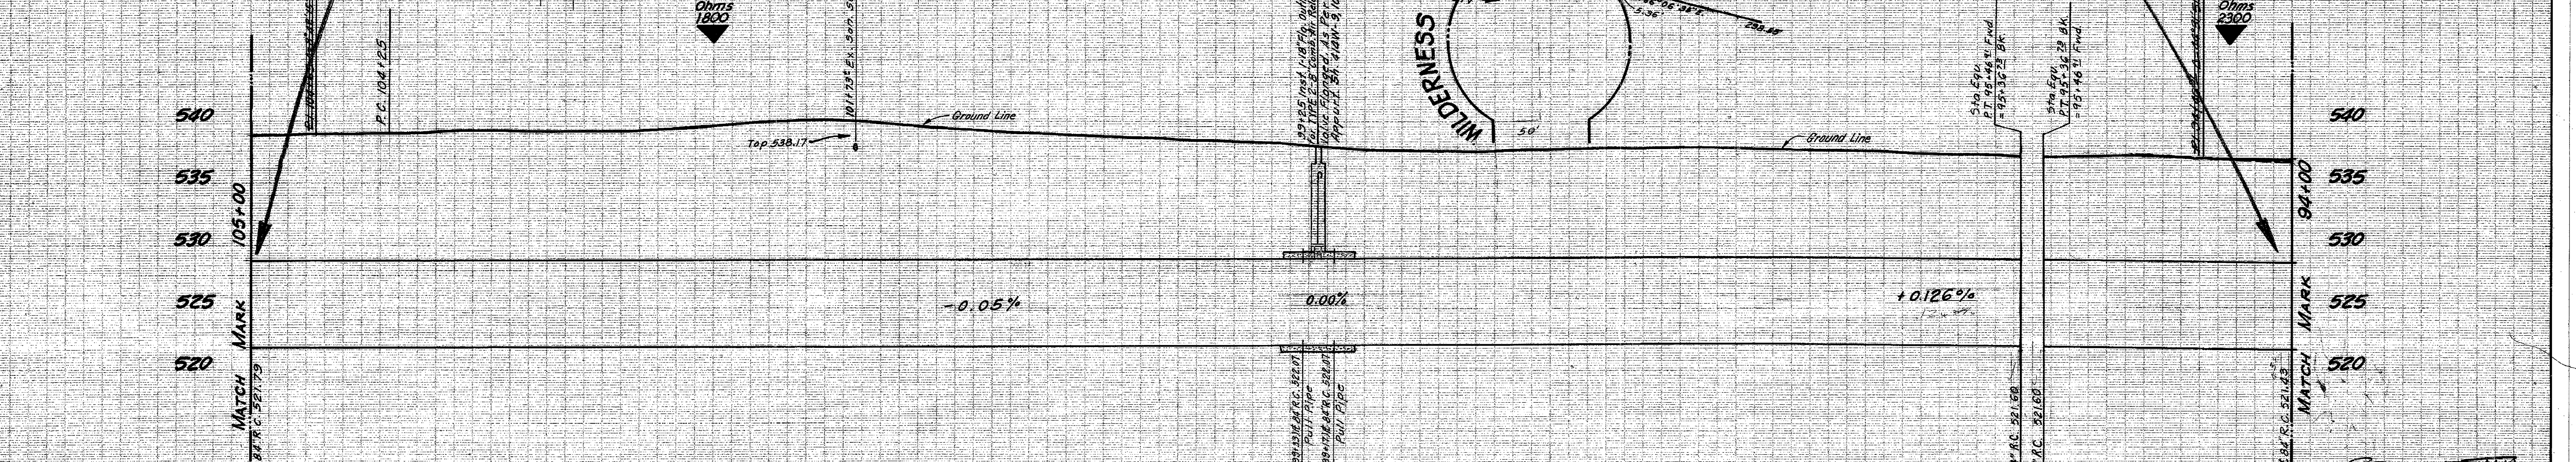


1090 LIN. FT. 84" DIA. PRESTRESSED CONC. EMBEDDED CYLINDER PIPE - CLASS 100  
 ALTERNATE: 1090 LIN. FT. 84" DIA. STEEL PIPE (AS PER PART "T" SPECIAL SPECIFICATIONS)

B.M. "X" Cut in Top Conc. Curb on S. Survey  
 N. Corner SPRING VALLEY RD on 105+00 E.L.  
 End of Bridge over WHITE ROCK CREEK  
 Elev. 549.04

B.M. Spd. 100.00 on S.E. Cor. of Corner Bridge  
 of WHITE ROCK CREEK & PRESTON ROAD  
 Elev. 554.05

T.B.M. Top I.R. of Sta. 115+94.85  
 of Original Survey  
 Elev. 541.62

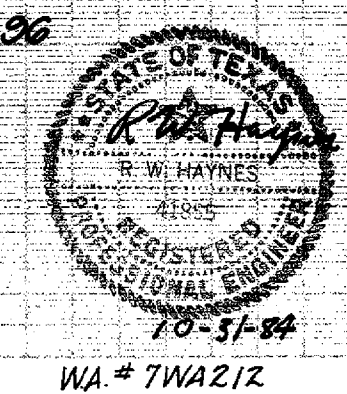

8

84" R.C. WATER MAIN					
ALONG WHITE ROCK CREEK					
FROM SPRING VALLEY TO DALLAS N. PKWY.					
DALLAS WATER UTILITIES DEPT.					
CITY OF DALLAS, TEXAS					
DESIGN	DRAWN	DATE	SCALE	NOTES	FILE NO.
M. PAREZ	H. WATTS	JAN. '84	VERT. 1"=6'		685W660B