
 
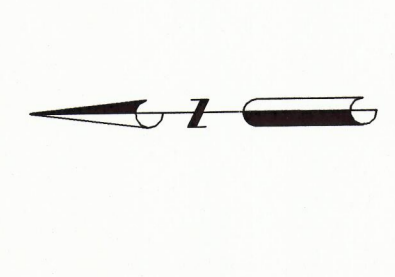


- LEGEND**
- PROPOSED PAVEMENT
 - PROPOSED BRIDGE
 - EXISTING WATERLINE EASEMENT
 - EXISTING 60" WATERLINE

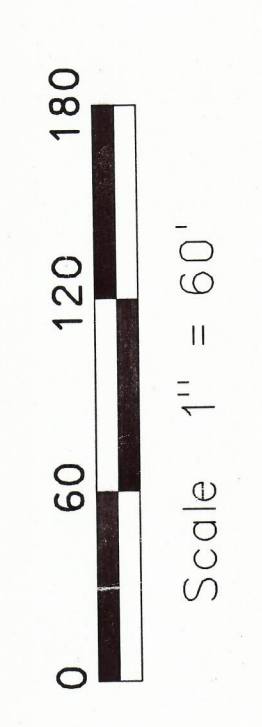

818-17

pgc

DW1 60" WA ARAPAHO R/WL Pot-holes 5/18/03