

TREE LIST

No.	Sta.	Lt.	Rt.	Size	Description
03	140170	02		6"	Hackberry
04	140180	145		6"	Pine Oak
05	140190	144		6"	Pine Oak
06	140200	172		6"	Pine Oak
07	140210	142		6"	Pine Oak
08	140220	129		6"	Hackberry
09	140230	142		6"	Hackberry
10	140240	115		6"	Hackberry
11	140250	172		10"	Box D'Arc
12	140260	242		10"	Box D'Arc
13	140270	181		10"	Box D'Arc
14	140280	191		10"	Box D'Arc
15	140290	172		6"	Hackberry
16	140300	202		6"	Hackberry
17	140310	202		6"	Hackberry
18	140320	202		6"	Hackberry
19	140330	142		6"	Hackberry
20	140340	242		6"	Hackberry
21	140350	242		6"	Hackberry
22	140360	102		6"	Hackberry
23	140370	102		6"	Hackberry
24	140380	102		6"	Hackberry
100	141140	102		6"	Hackberry


CONT. # 84-45
CITY OF ADDISON

JHY Corporation
A Texas Corporation
100' Temp. Working Space For The 84" Water Main
From Sta. 143+40.2 To Sta. 149+57.2
Abst. No. 157 Bk. 0108
In The City of Addison
C.O.
Vol. 04112 Pg. 351 Date:

NOTE!
* Install:
430 L.F. OF Temp. 2" Water Line Above The Ground,
Prior To The Const. Of The 84" Water Main.
* Conn. Ex. House Services To The Temp. Line.
* #5505, #5510, #5434, Will Be Served From The
2" Temp. Line During The Const. Time.
* Cut & Plug Ex. 8" Water East Of Ex. Tee Station
149+44.50.

WATER MAP
8 - 23 W

SEWER KEY MAP
F - 2

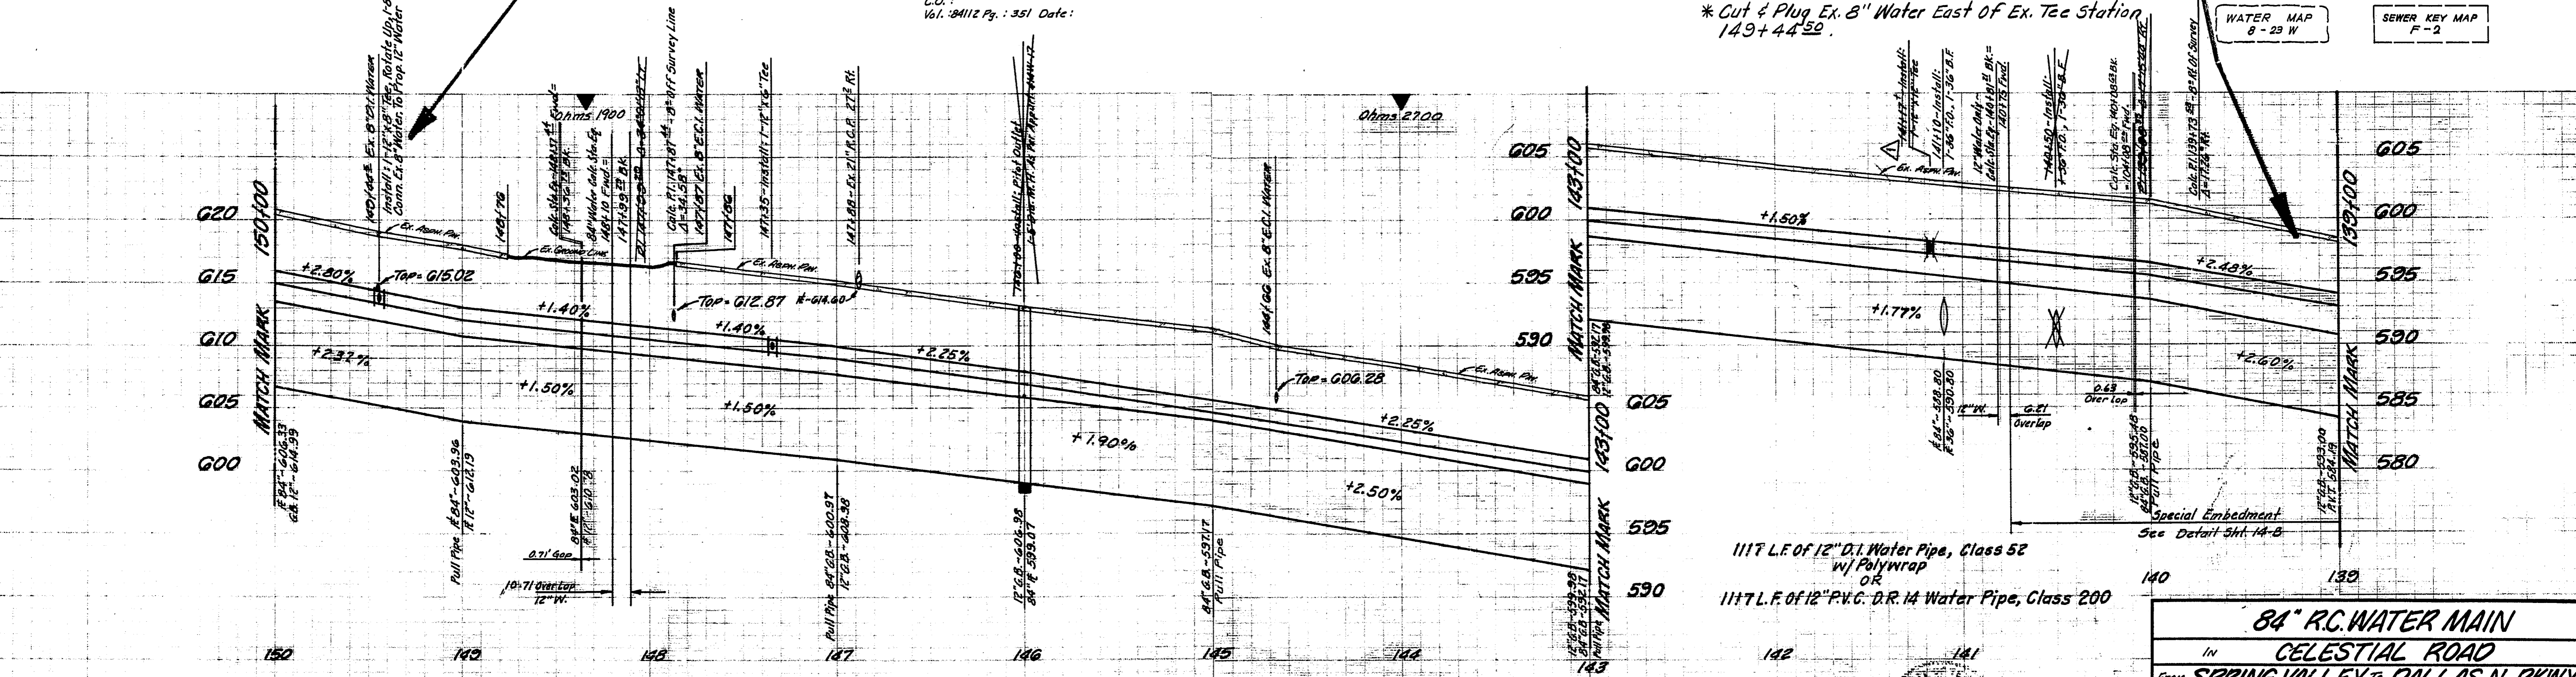

T&M - God Main in PIP #12 N-W-107 17 1/2 Lt. Sta. 131+03.5 S. Side
Of Celestial Rd. & 200' E. Of Vinwood Rd. ELEV - 555.46

T&M - 12" CUT ON CONC. BASE OF 6" BRICK WALL @ N.E. COR. OF
CELESTIAL RD. & MONTFORT DR. ELEV - 626.81

1100 L.F. OF 84" Prestressed Concrete Embedded Cyl. Pipe, Class 60
ALTERNATE
1100 L.F. OF 84" Inside Dia. Steel Pipes (Per Part "T" Special Specifications)

1117 L.F. OF 12" D.I. Water Pipe, Class 52
w/ Polywrap
OR
1117 L.F. OF 12" P.V.C. D.R. 14 Water Pipe, Class 200

84" R.C. WATER MAIN
IN
CELESTIAL ROAD
FROM **SPRING VALLEY** TO **DALLAS N. PKWY.**
DALLAS WATER UTILITIES DEPT.
CITY OF DALLAS, TEXAS

DESIGN	DRAWN	DATE	SCALE	NOTES	FILE	NO.
S. REZAI	N. REZAI	JAN. 84	1" = 40'			
	S. PEREL					

12

CON. # 84-45
Revised By: S. Rejai 3-6-85

TWA 212
Nov. 14, 1985