


Ⓐ Bench Mark:  
Top of Fire Hydrant East Line  
Dallas Parkway 315 Ft. South  
of South Line of Verde Valley  
Lane. Elev. 635.88

BENCHMARK:  
3/4" I.P. in 8" Hackberry W. Side  
Montfort Drive - 140' S. of Celestial  
Road. Elev. 626.96

BENCHMARK:  
Top of Fire Hydrant Operating Nut  
Northeast Cor. Celestial Rd. & Dallas  
Pkwy. Elev. 633.73

43

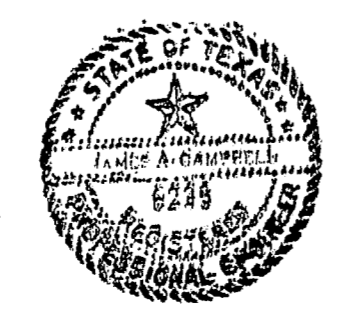

Subdivision - LHRHW Addition Ⓐ  
Designed by - James A. Campbell Date: 7-10-80  
UBA - A. Campbell, P.E.  
Checked by - V. Olmstead Date: 7-17-80  
Engineer of Design - Water Utilities Dept.  
Contract No. - 80-3977(80-395) - WHICH DMS100078 - 5-25-80

PLAN REVISIONS - JUNE 26, 1979  
1. Lateral "p" Line C changed from 6" to 8"  
2. Lateral "q" - 6" lateral added to Line B at sta. B15

Revised by:  
Donald D. Tucker 6-26-1979  
Chick Little 6-27-79  
Approved by: Dallas Water Utilities Dept.

Subdivision - LHRHW Addition  
Designed by: Small B. Tucker  
DONALD D. TUCKER - ENGINEER  
R.O.W. -  
Chris C. Maxwell, P.E. 6-5-79  
Engineer of Design - Dallas Water Utilities Dept.  
79-26779-268 WELCON CONST. CO. 5-2-79  
CONTRACT NO.



WATER & SEWER						
LHRHW ADDITION						
DONALD D. TUCKER - ENGINEER						
CITY OF DALLAS, TEXAS						
DESIGN	DRAWN	DATE	SCALE	NOTES	FILE	NO.
D. D. T.	D. D. T.	July 1978 Revised June 1979	1" = 40' H 1" = 6' V			411Q1960
Revised 8-1-79						