


Patrick Holden Architects
 Dallas Texas 75205
 214 522-5100

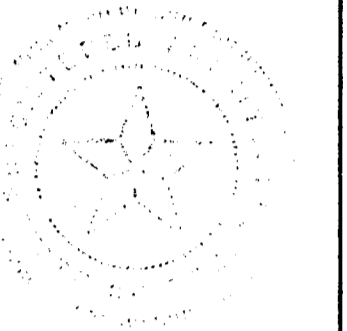

Jon-Mac Hanger Development

Dooley Road
 Addison Texas

Site Plan

Contractors shall verify all conditions and dimensions at the job site and notify the architect in writing of any dimensional errors, omissions or discrepancies before beginning or fabricating any work. Do not scale these drawings.

Revisions
 4 MAR 82 #82


Date
 12 Feb 1982

Project Number
 8203

Sheet

A1

Of 3

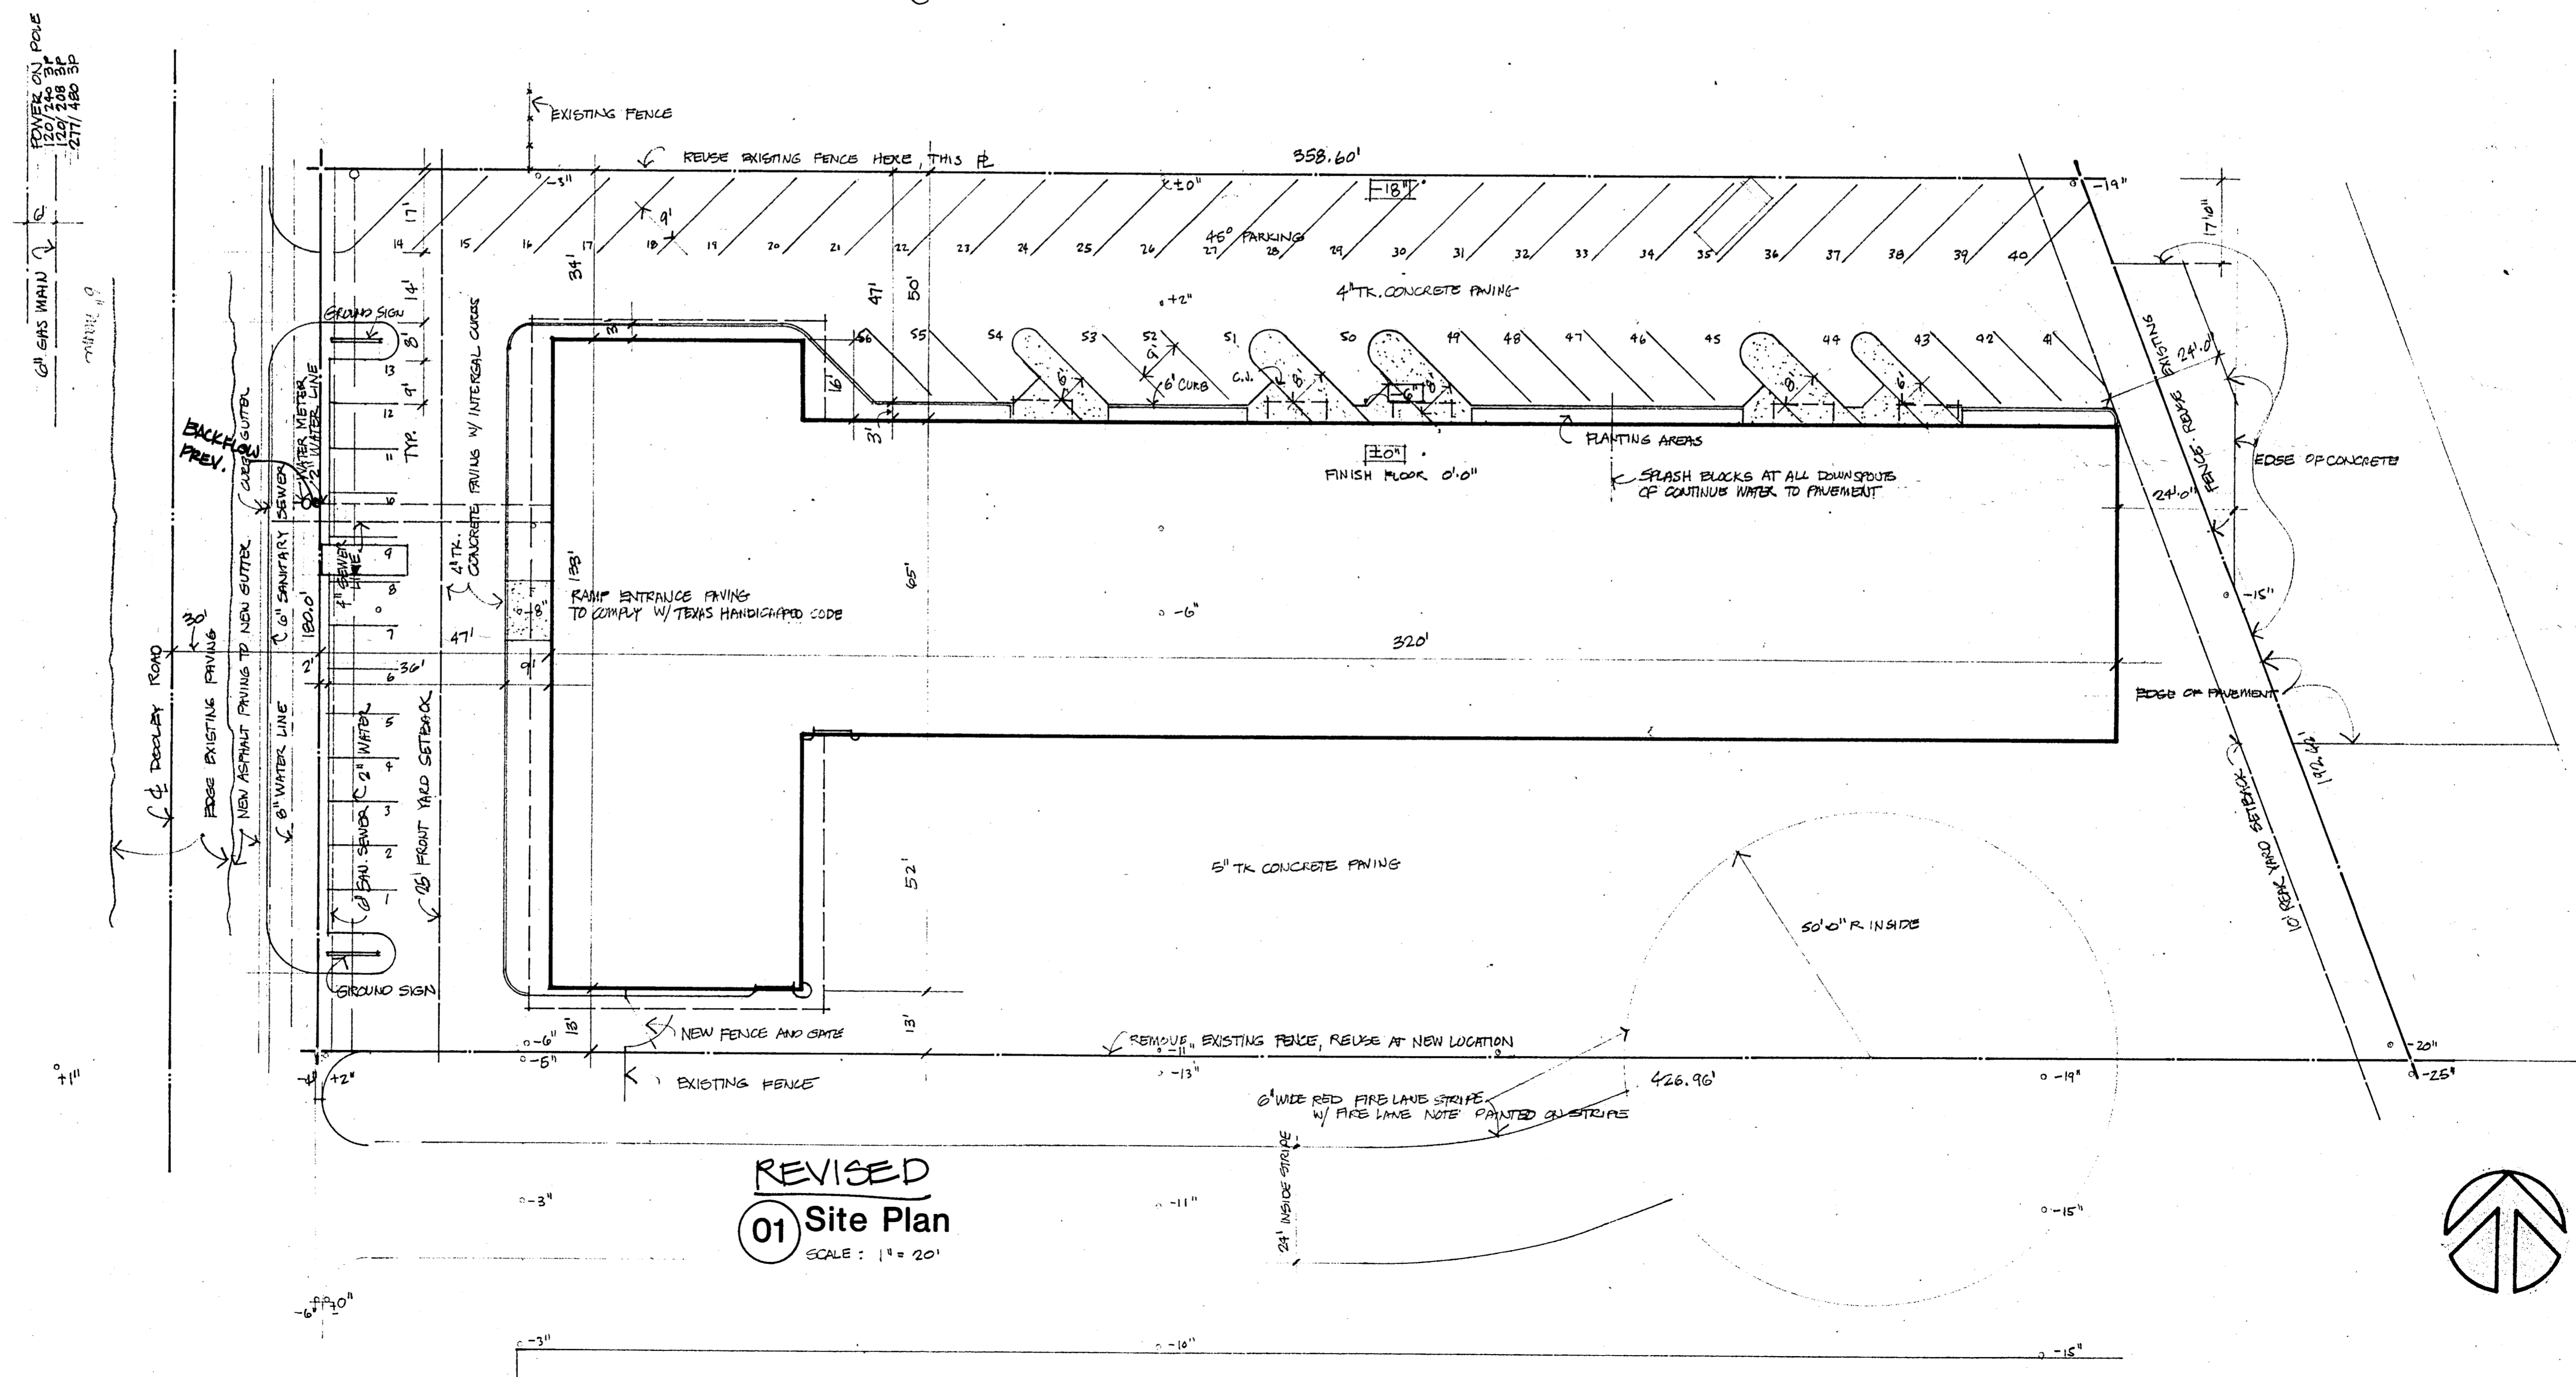

REVISED
01 Site Plan
 SCALE: 1" = 20'

