1-07-0002 1-07-0001 1-07-0005 15900 Midway Road Ltd.

Midway Park North

Addison Airport

TBM - " □ " cut on S.E. top curb corner, the back side parking lot, Building 15950 Midway Road. Elevation 637.75

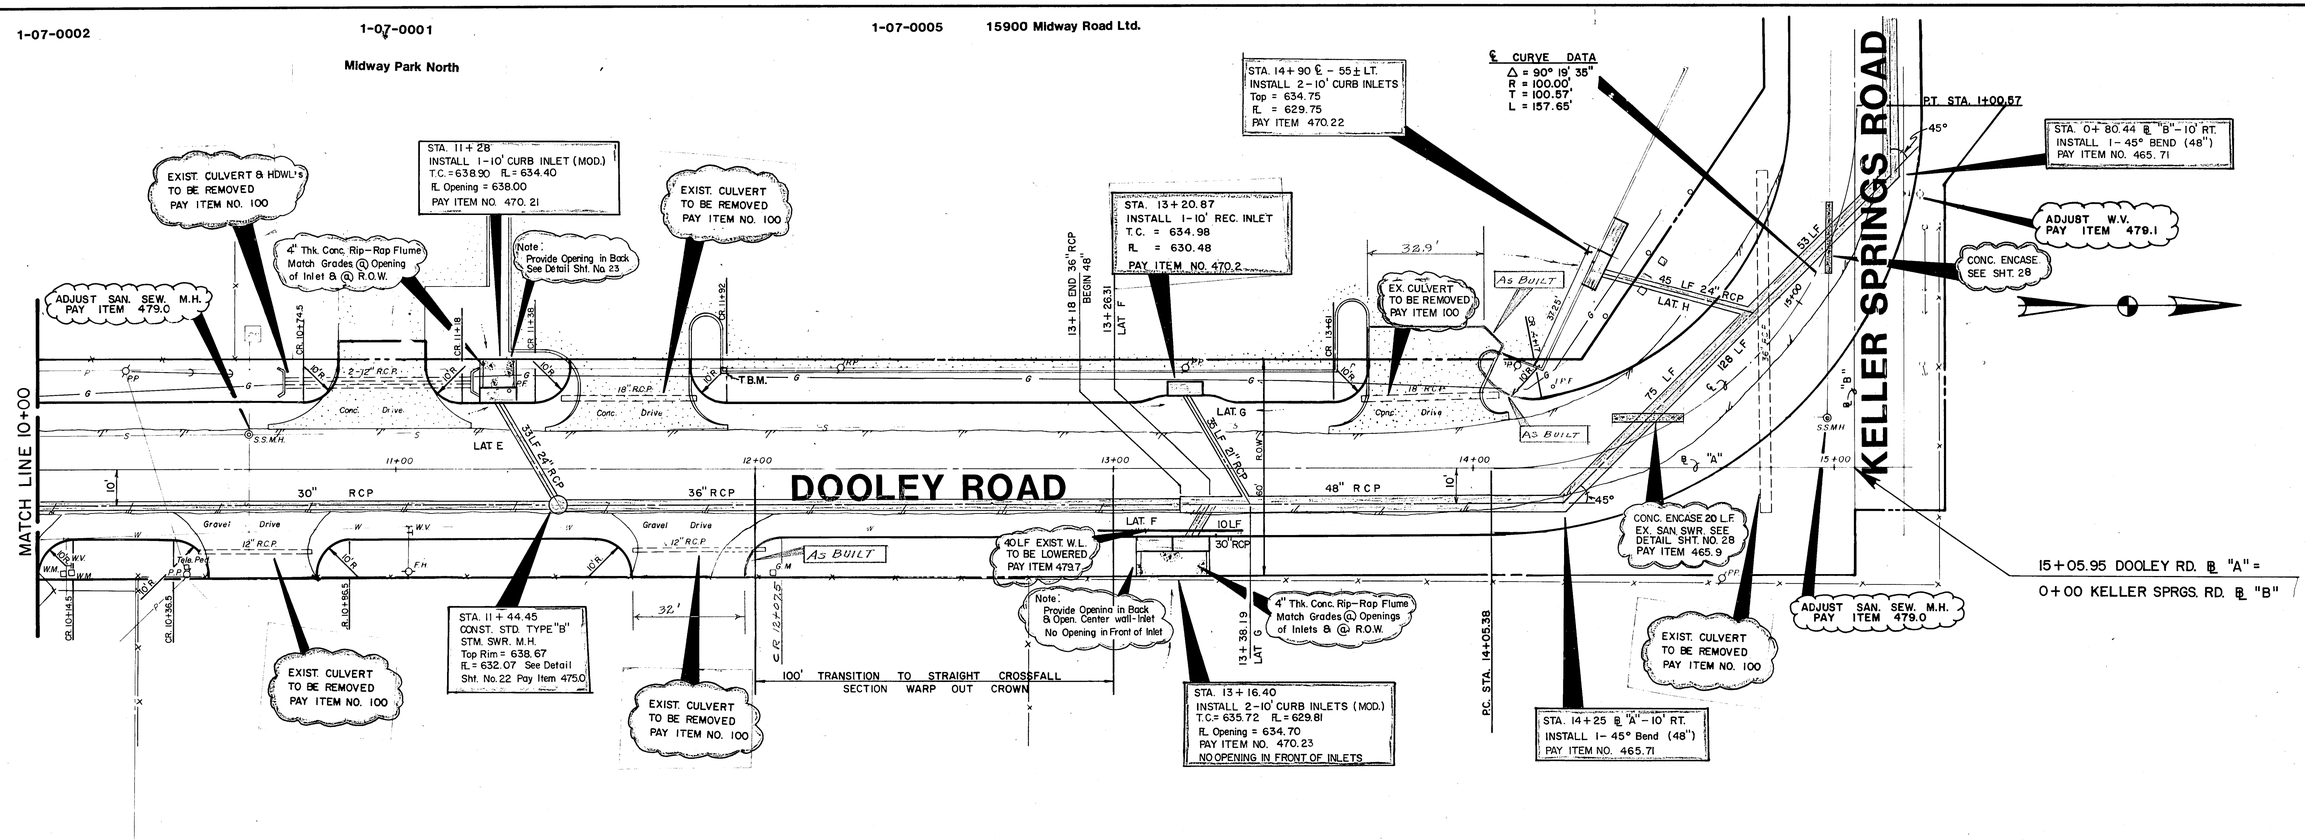

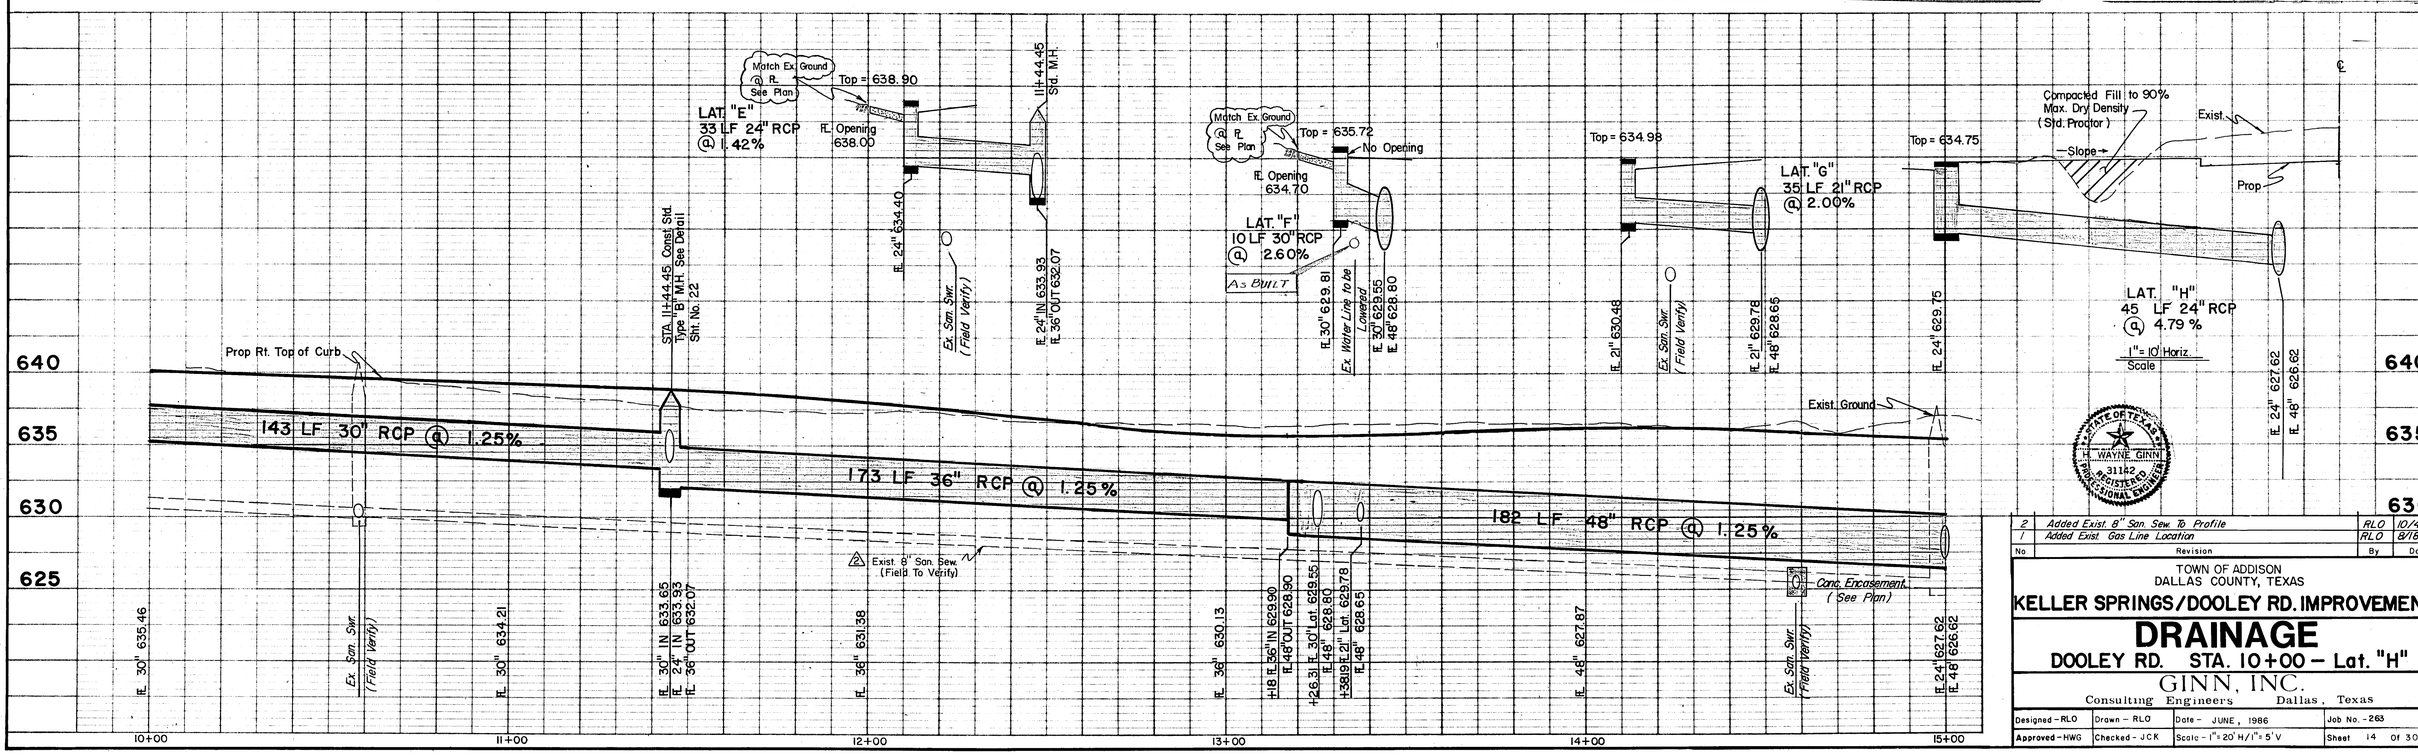

No	Revision	By	Date
2	Added Exist. 8" San. Sew. To Profile	RLO	10/4/86
1	Added Exist. Gas Line Location	RLO	8/18/86

TOWN OF ADDISON
DALLAS COUNTY, TEXAS

KELLER SPRINGS/DOOLEY RD. IMPROVEMENTS

DRAINAGE

DOOLEY RD. STA. 10+00 – Lat. "H"

GINN, INC.
Consulting Engineers Dallas, Texas

Designed - RLO	Drawn - RLO	Date - JUNE, 1986	Job No. - 263
Approved - HWG	Checked - JCK	Scale - 1"=20' H/1"=5' V	Sheet 14 Of 30

STATE OF TEXAS — WAYNE GINN — 31182 — REGISTERED PROFESSIONAL ENGINEER