

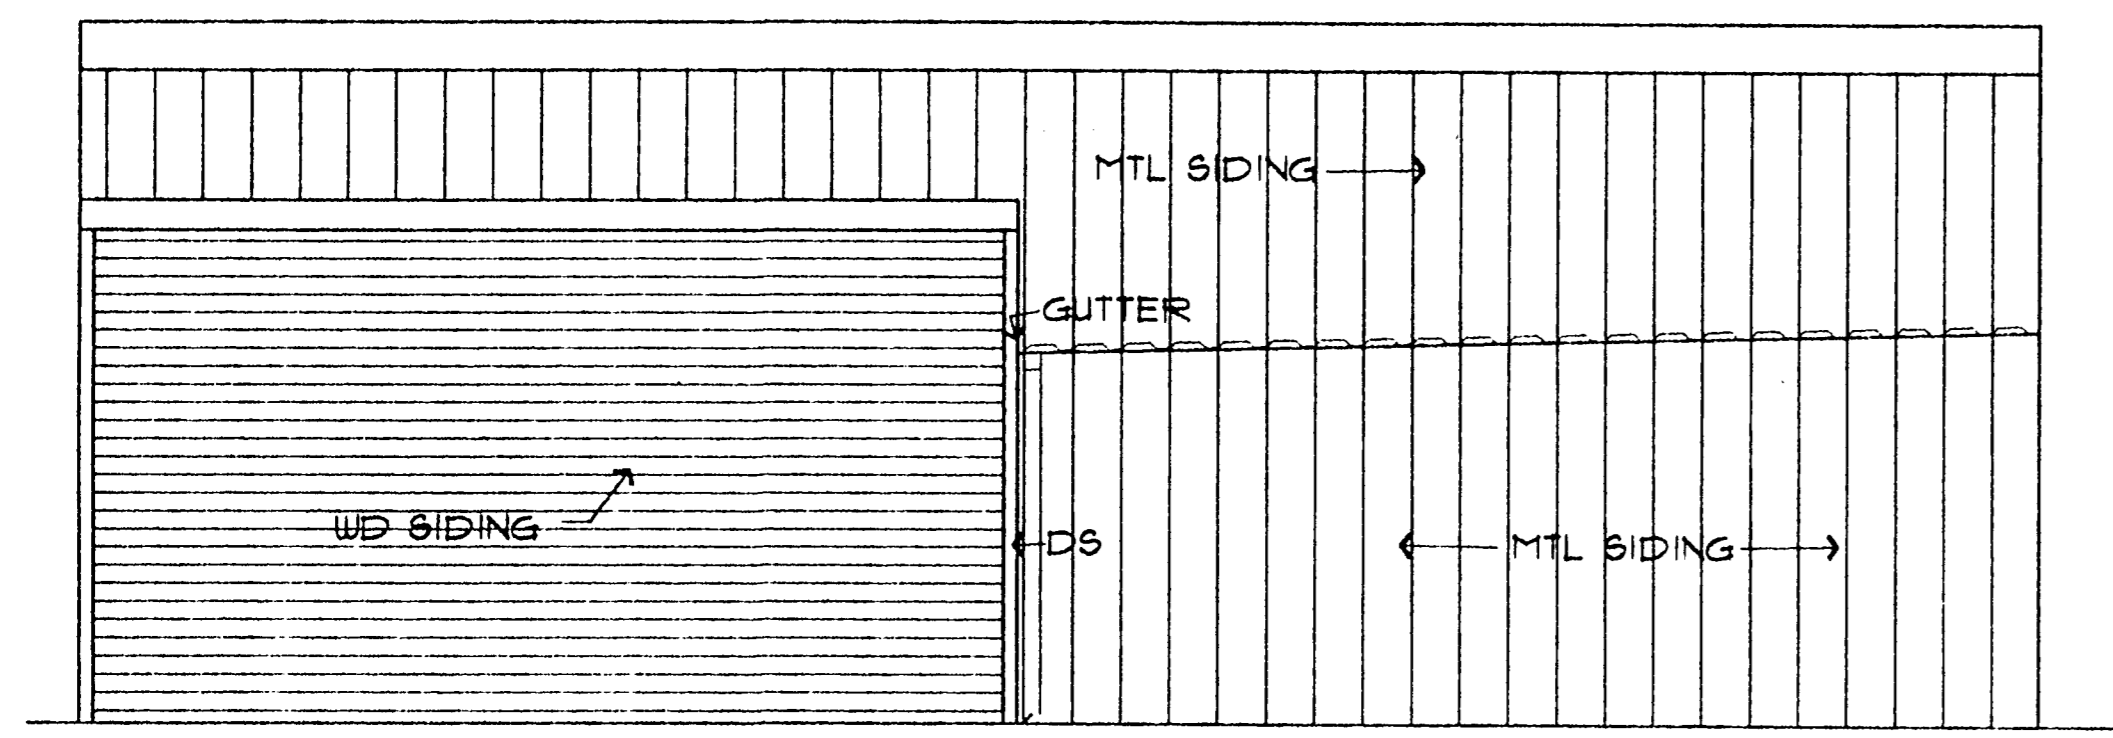


drawn by	RSL	9/1/91
checked by		date
issued		date
		9/1/91


revisions	date

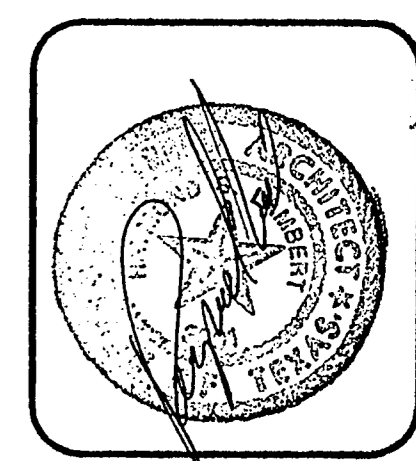


A SHOP SIDE ELEVATION
SCALE 1/4" = 1'-0"

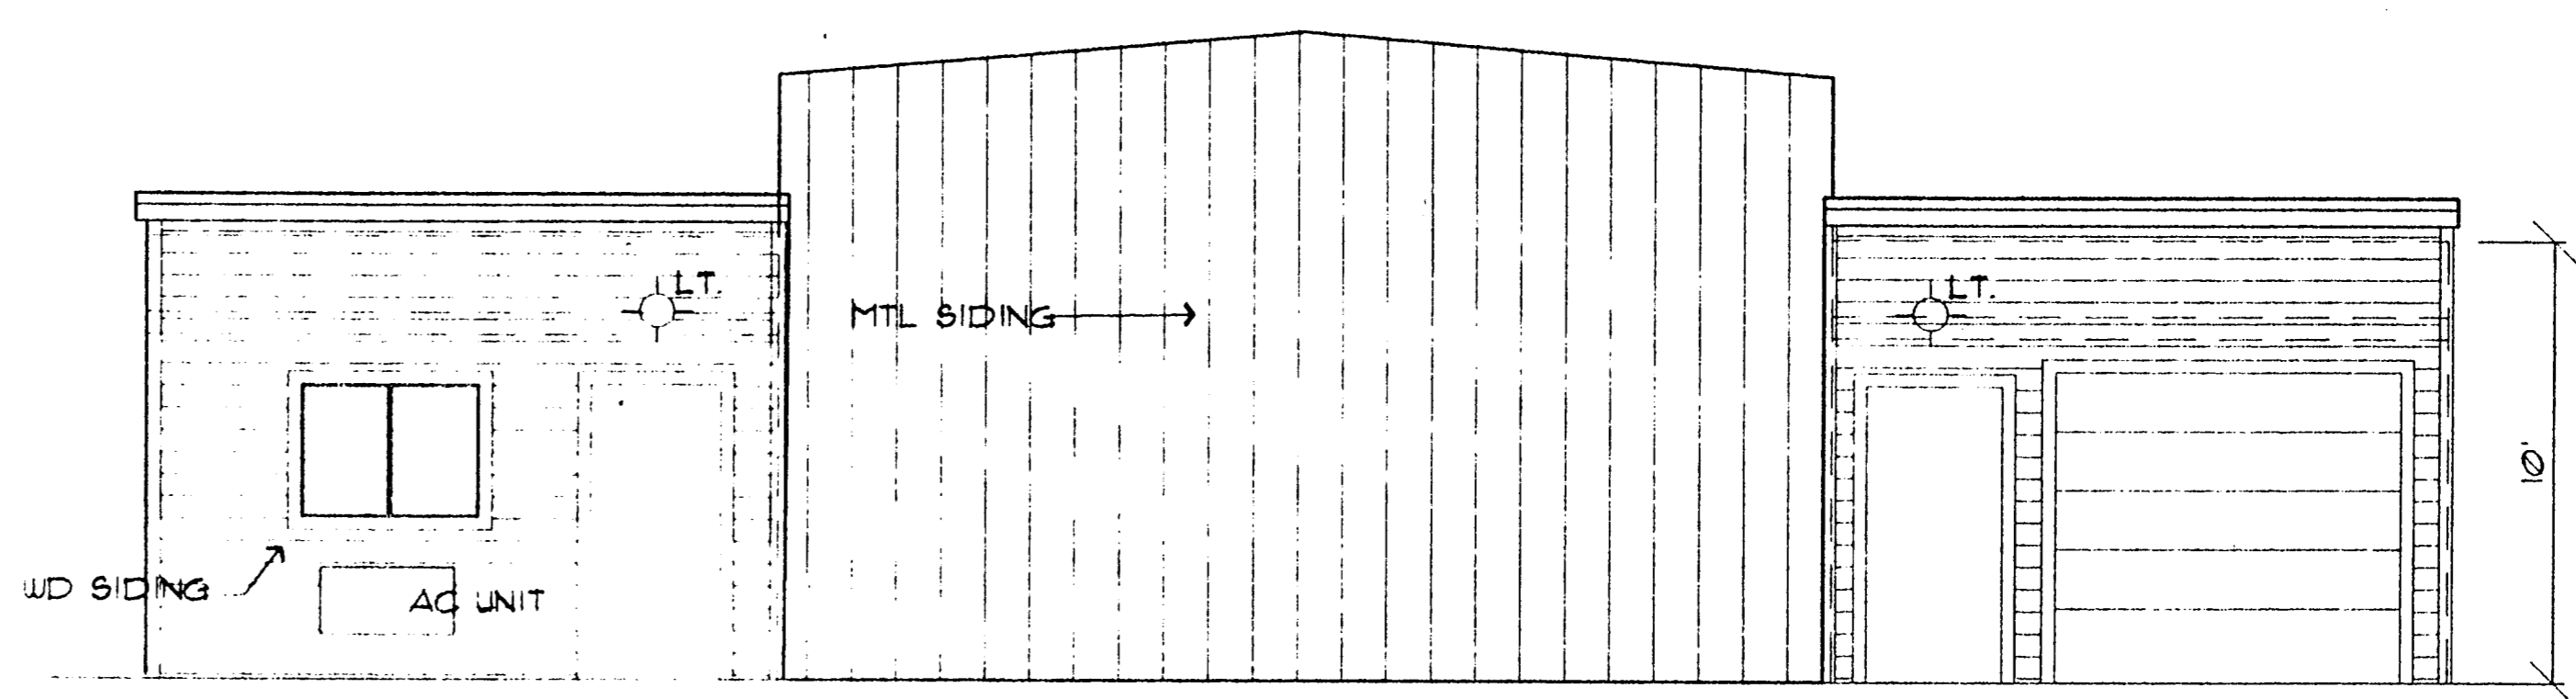


C FRONT ELEVATION
SCALE 1/4" = 1'-0"

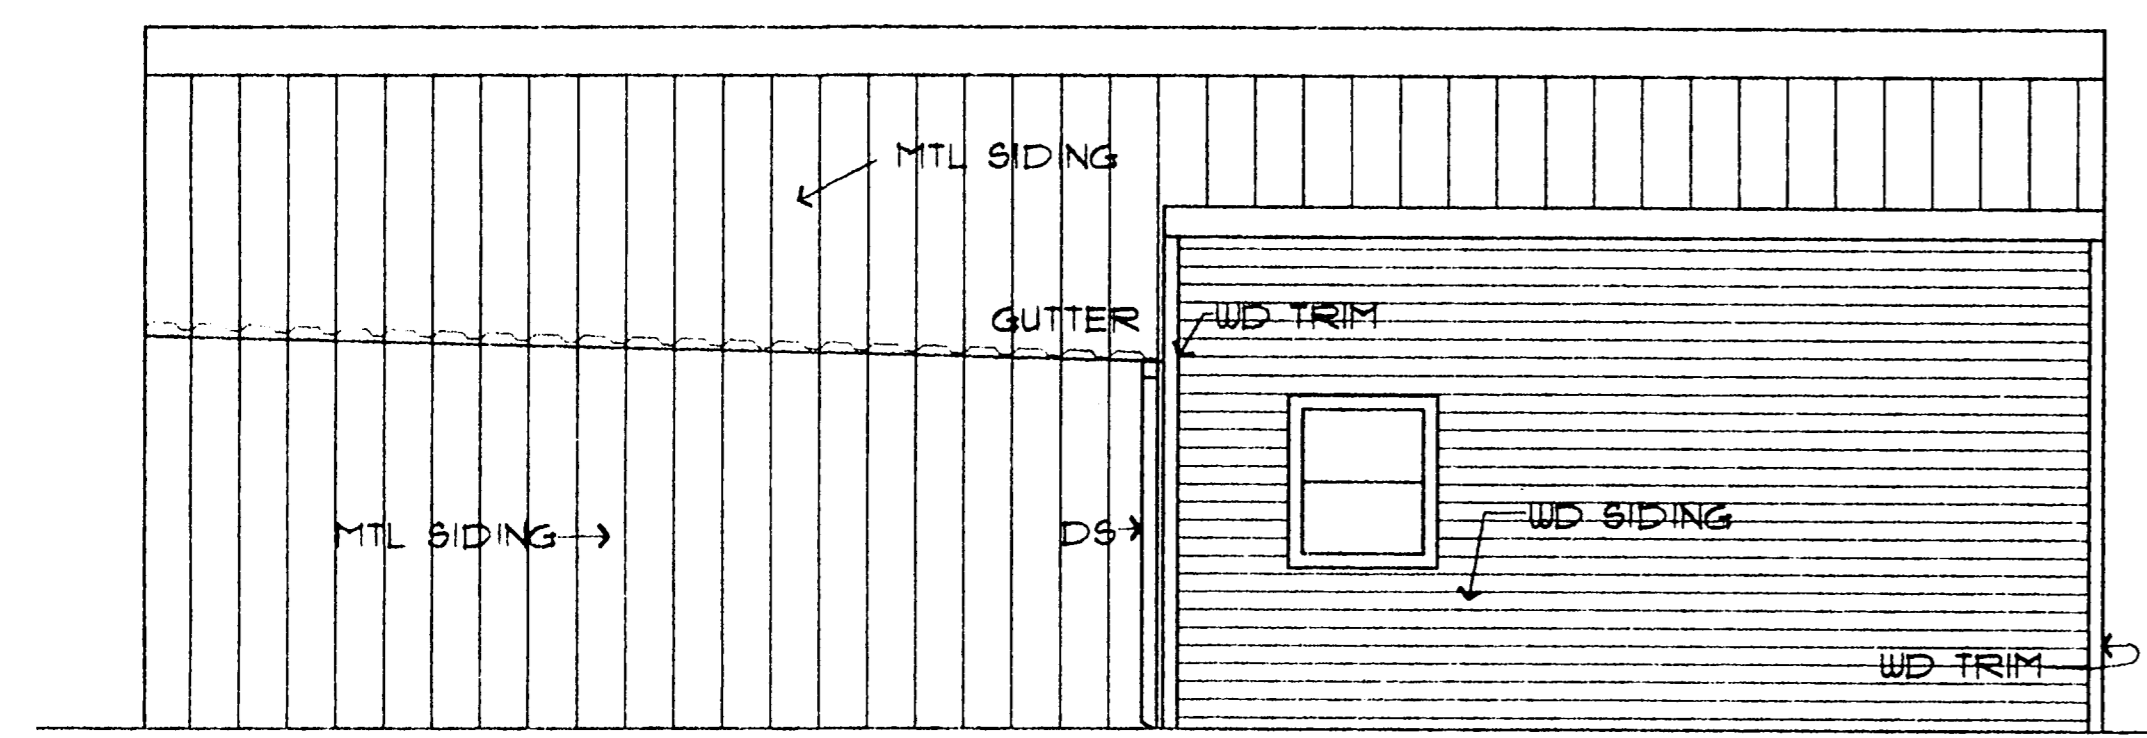


B OFFICE SIDE ELEVATION
SCALE 1/4" = 1'-0"

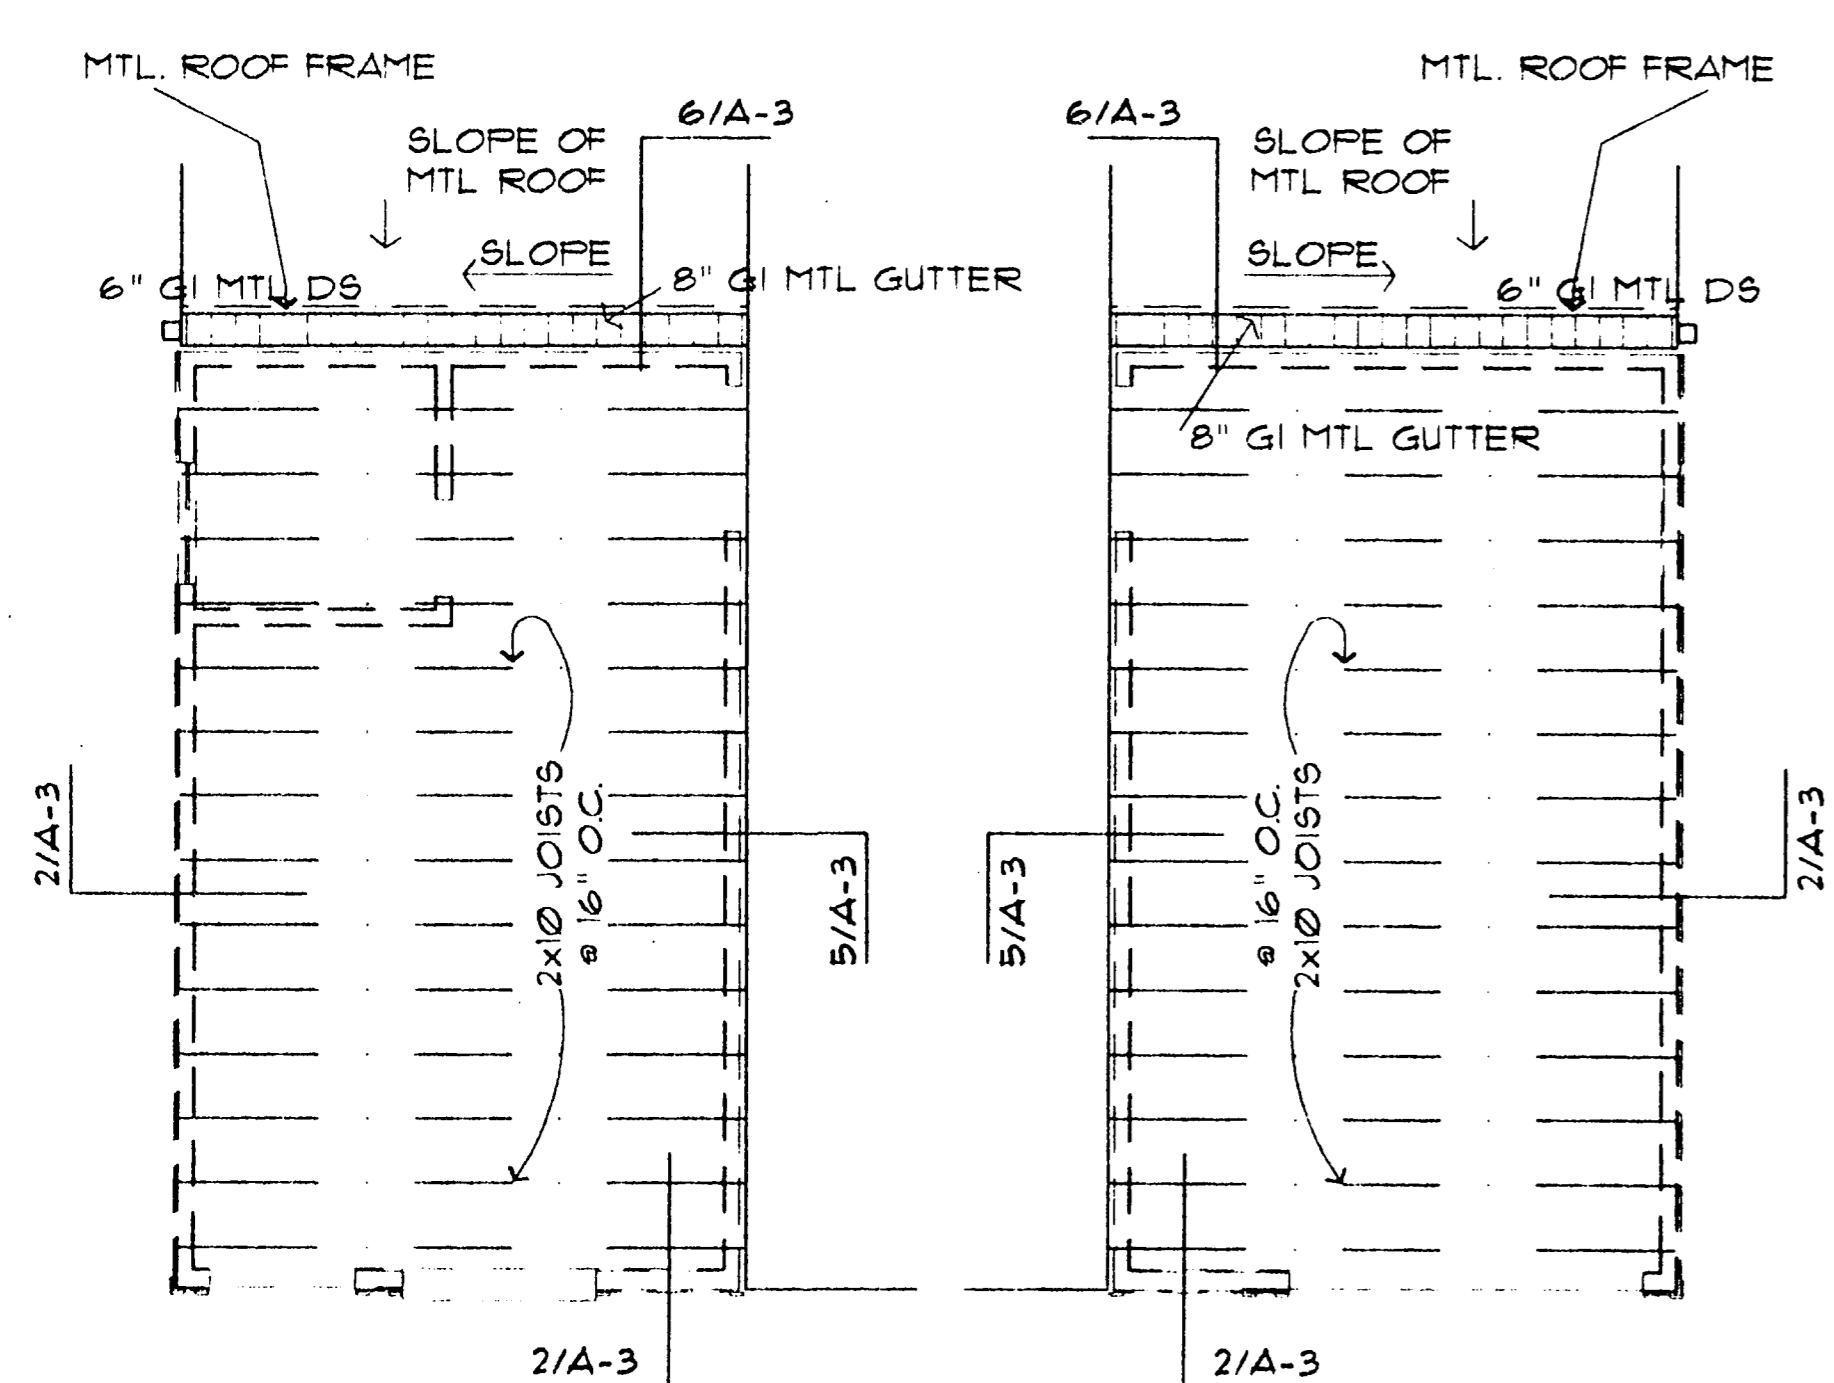

ROOF FRAMING PLAN
SCALE 1/4" = 1'-0"

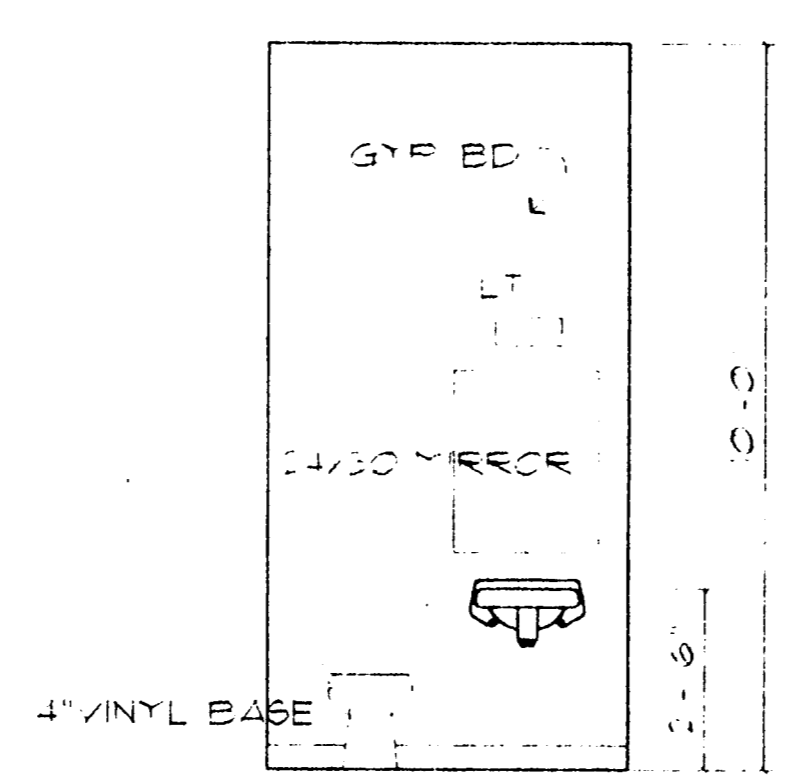

TOILET ELEV
SCALE 3/8" = 1'-0"

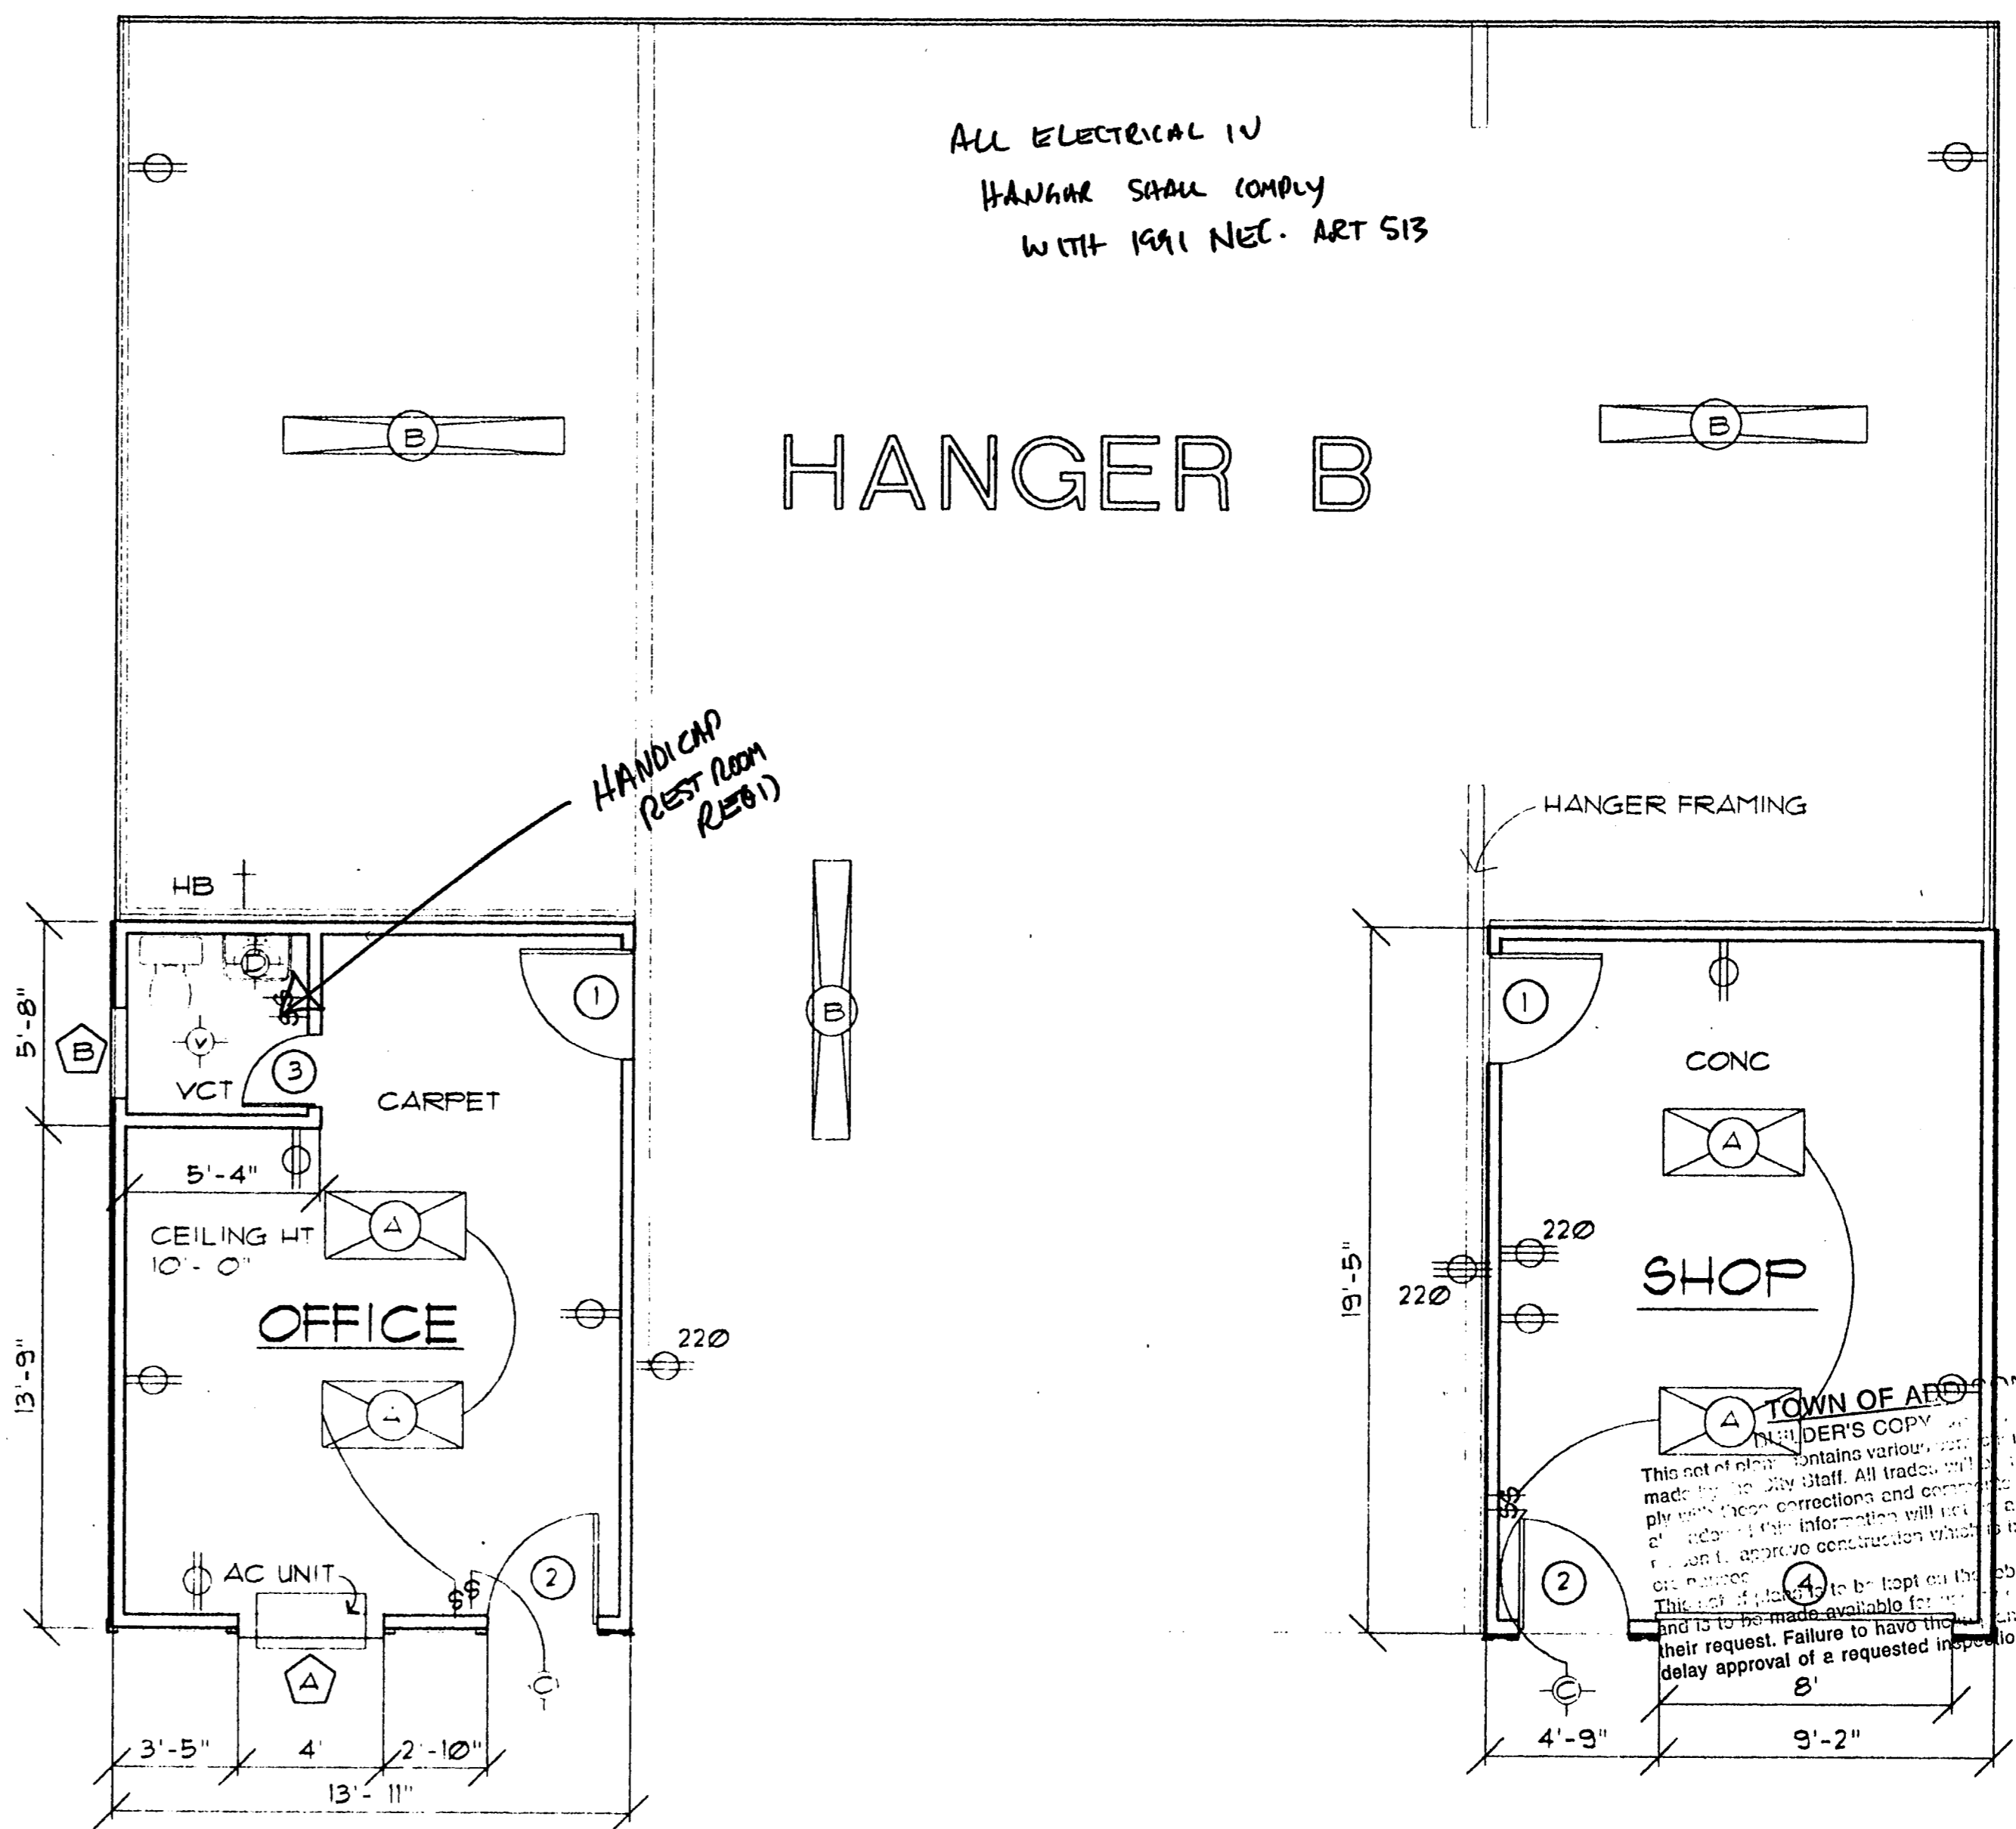

FLOOR PLAN
SCALE 1/4" = 1'-0"

HANGER MODIFICATIONS
326 NEW RICKENBACKER DRIVE
ADDISON AIRPORT
ADDISON, DALLAS COUNTY, TEXAS

raymond s. lambert & associates
architect-planners
12240 Inwood road
suite 201
dallas, texas 75244
972 387-4286

title

sheet no.
A-2