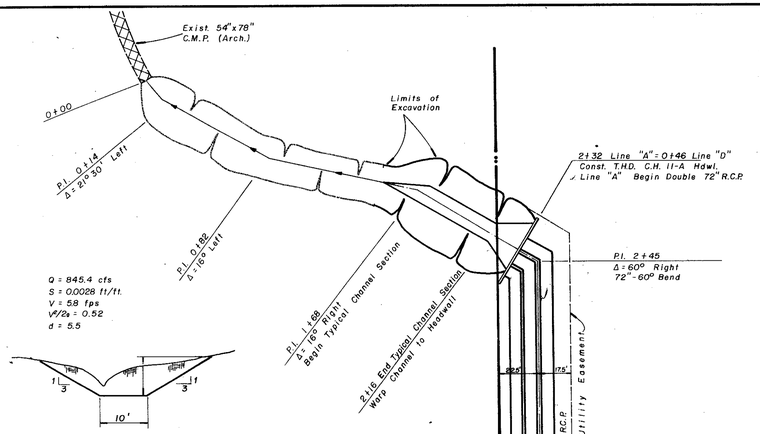

Typical Channel Section

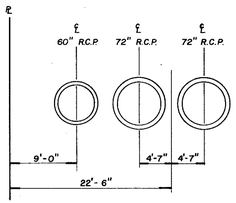

Typical Pipe Spacing
Sta. 2+32 thru Sta. 4+65

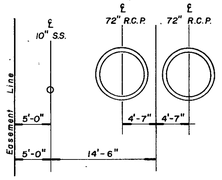

Typical Pipe Spacing
Sta. 6+33.34 thru Sta. 9+50

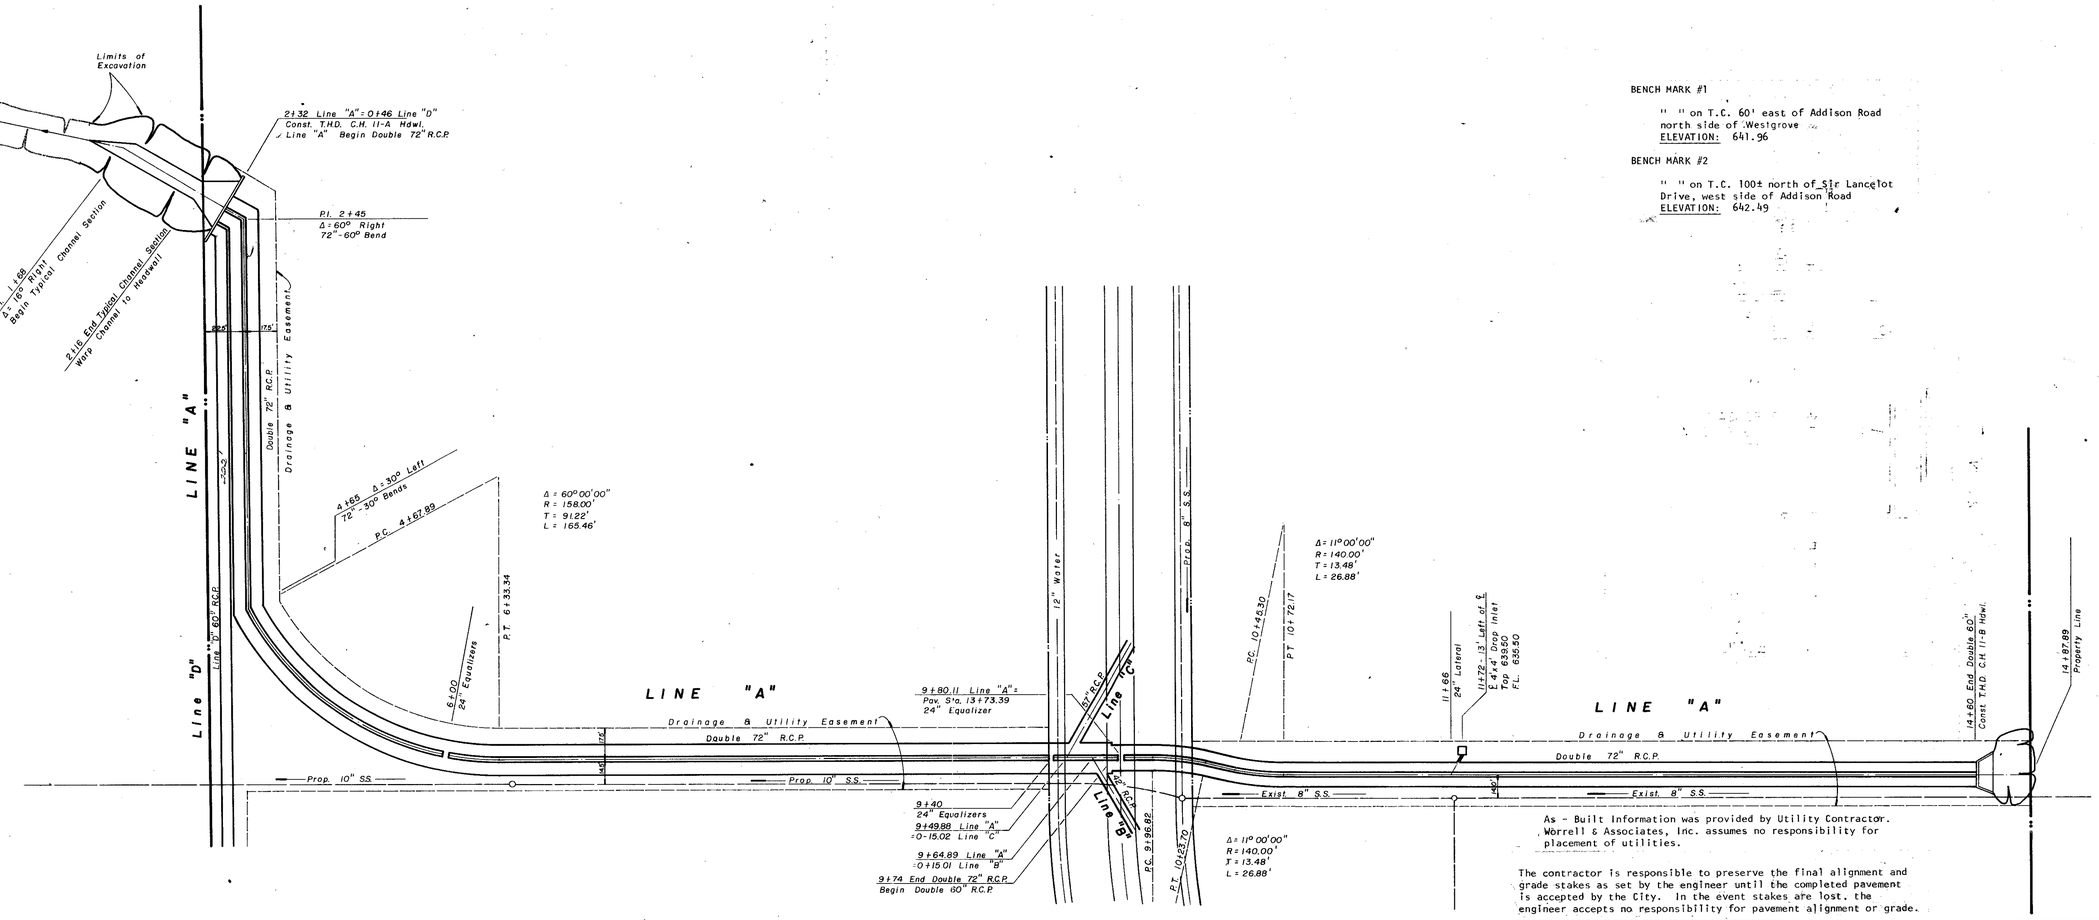

BENCH MARK #1

" " on T.C. 60' east of Addison Road north side of Westgrove
ELEVATION: 641.96

BENCH MARK #2

" " on T.C. 100± north of Sir Lancelot Drive, west side of Addison Road
ELEVATION: 642.49

As - Built Information was provided by Utility Contractor. Worrell & Associates, Inc. assumes no responsibility for placement of utilities.

The contractor is responsible to preserve the final alignment and grade stakes as set by the engineer until the completed pavement is accepted by the City. In the event stakes are lost, the engineer accepts no responsibility for pavement alignment or grade.

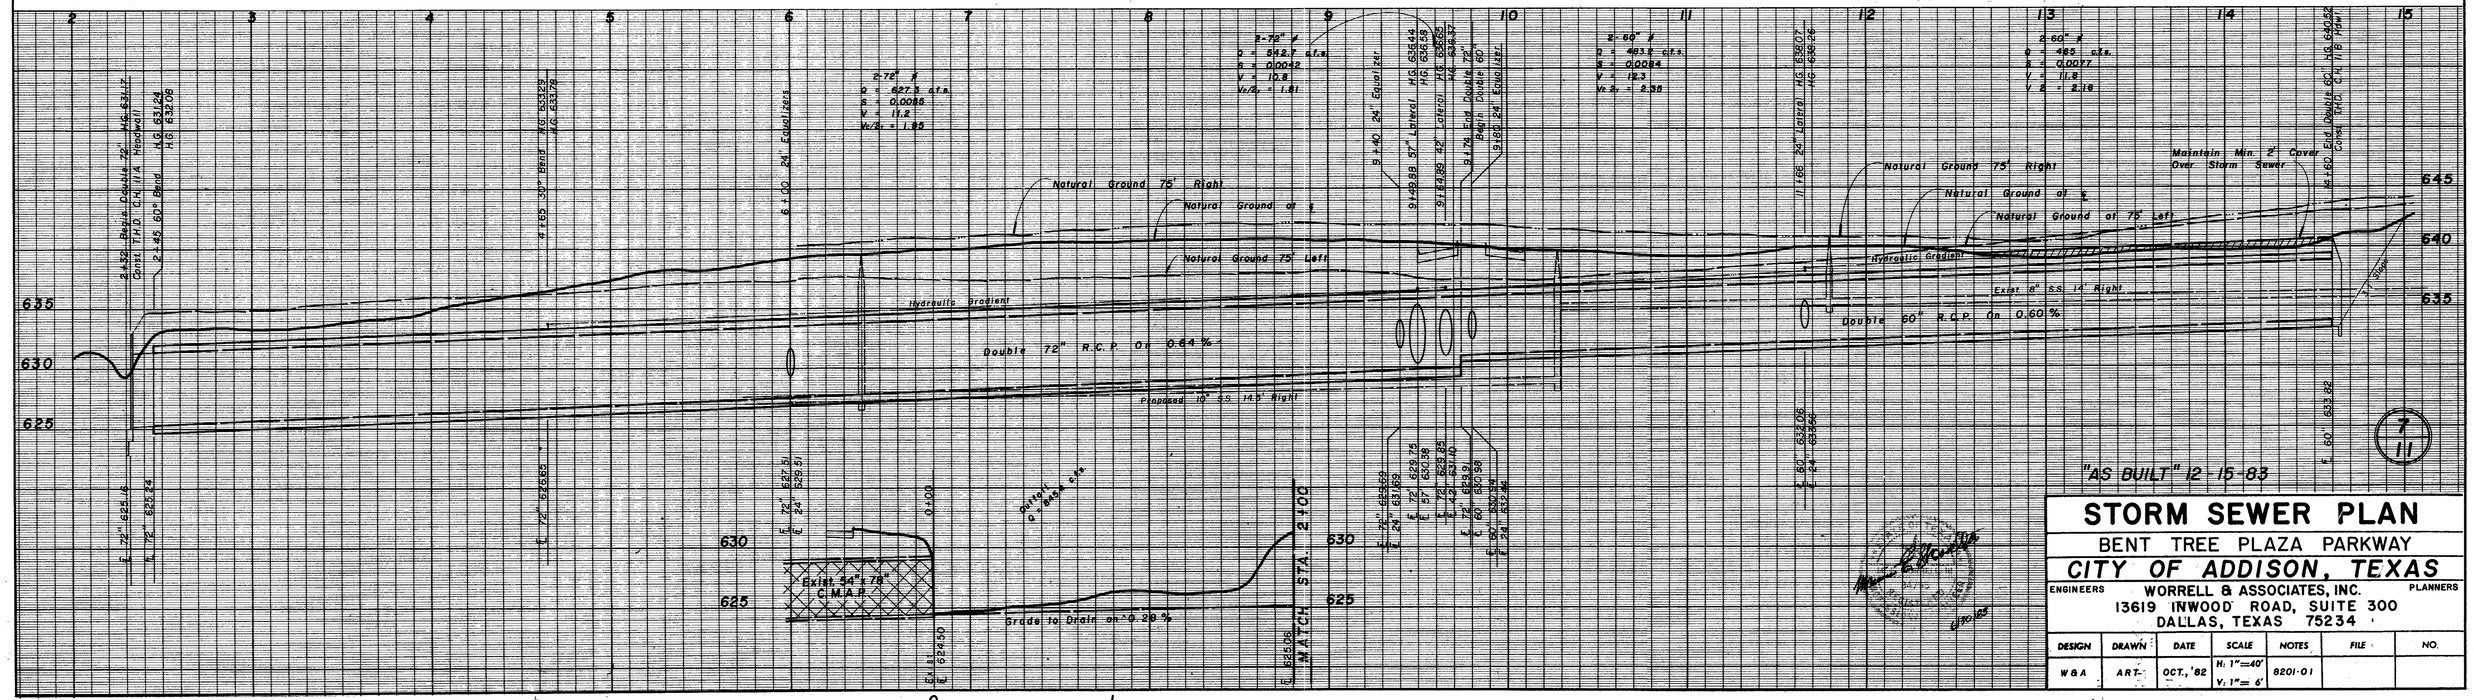

"AS BUILT" 12-15-83

STORM SEWER PLAN

BENT TREE PLAZA PARKWAY

CITY OF ADDISON, TEXAS

ENGINEERS WORRELL & ASSOCIATES, INC. PLANNERS
13619 INWOOD ROAD, SUITE 300
DALLAS, TEXAS 75234

DESIGN	DRAWN	DATE	SCALE	NOTES	FILE	NO.
W & A	ART	OCT., '82	H: 1"=40' V: 1"= 6'	8201-01		