


FAIRFIELD PARK

Town of Addison, Texas

Talley Associates

Landscape Architecture
Planning
Urban Design

1626 Stem Junction, Suite 400
Dallas, Texas 75201
Tel. 214-971-7900
Fax. 214-971-7885

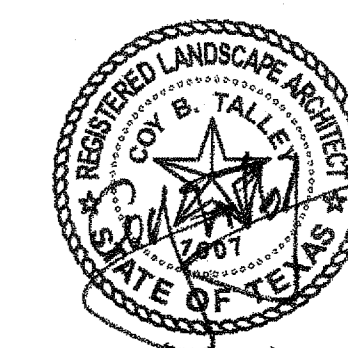

Project No. 6034

Drawn By: JW

Checked By: CT/KB

Date: 5 September 2008

Issued:

Issued:

Issued:

Revisions:

▲

▲

▲


▲

Sheet Title:


DETAILS

L5.04

Sheet No.:

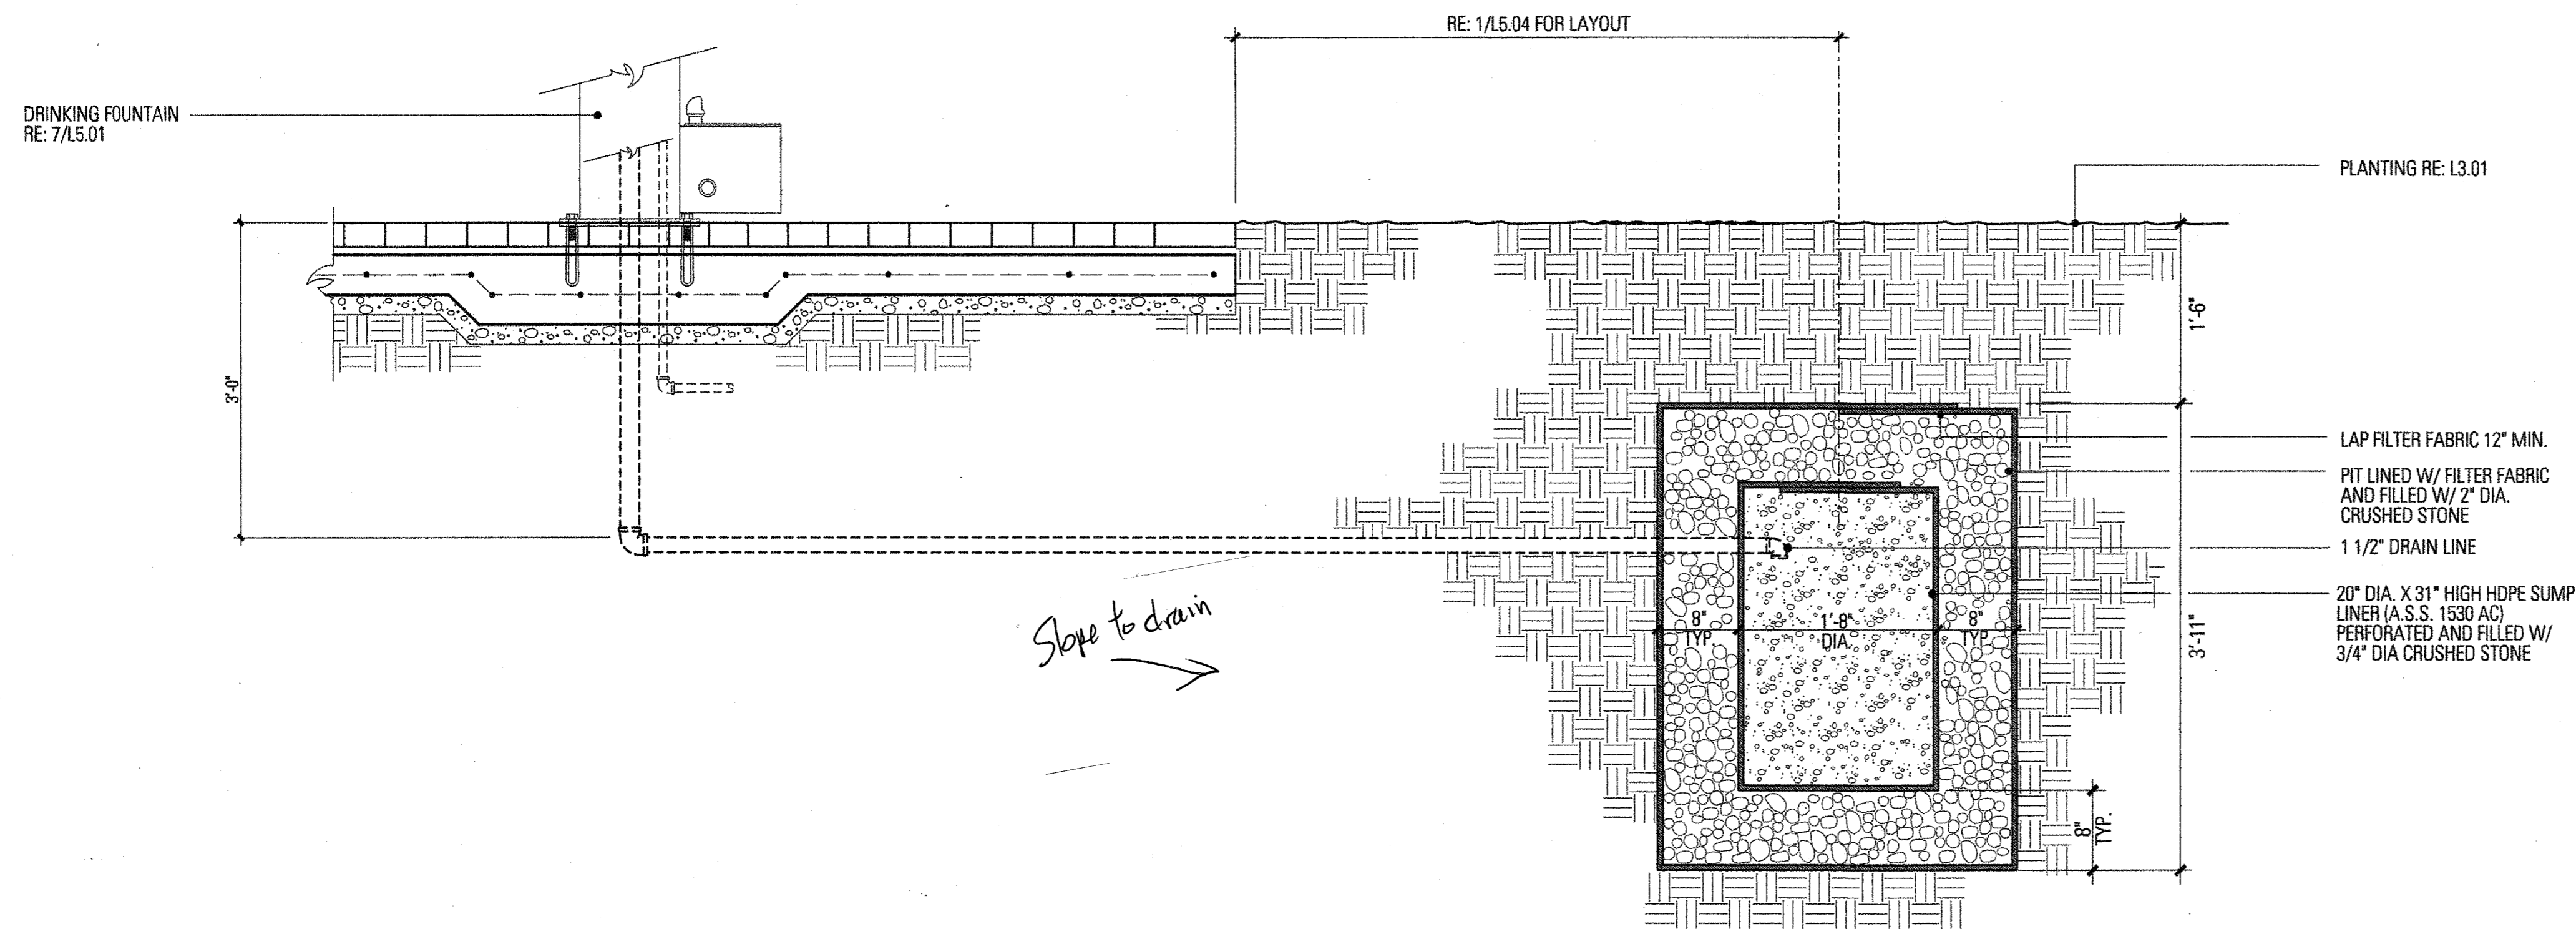

2 DRINKING FOUNTAIN SUMP
SCALE: 1" = 1'-0"

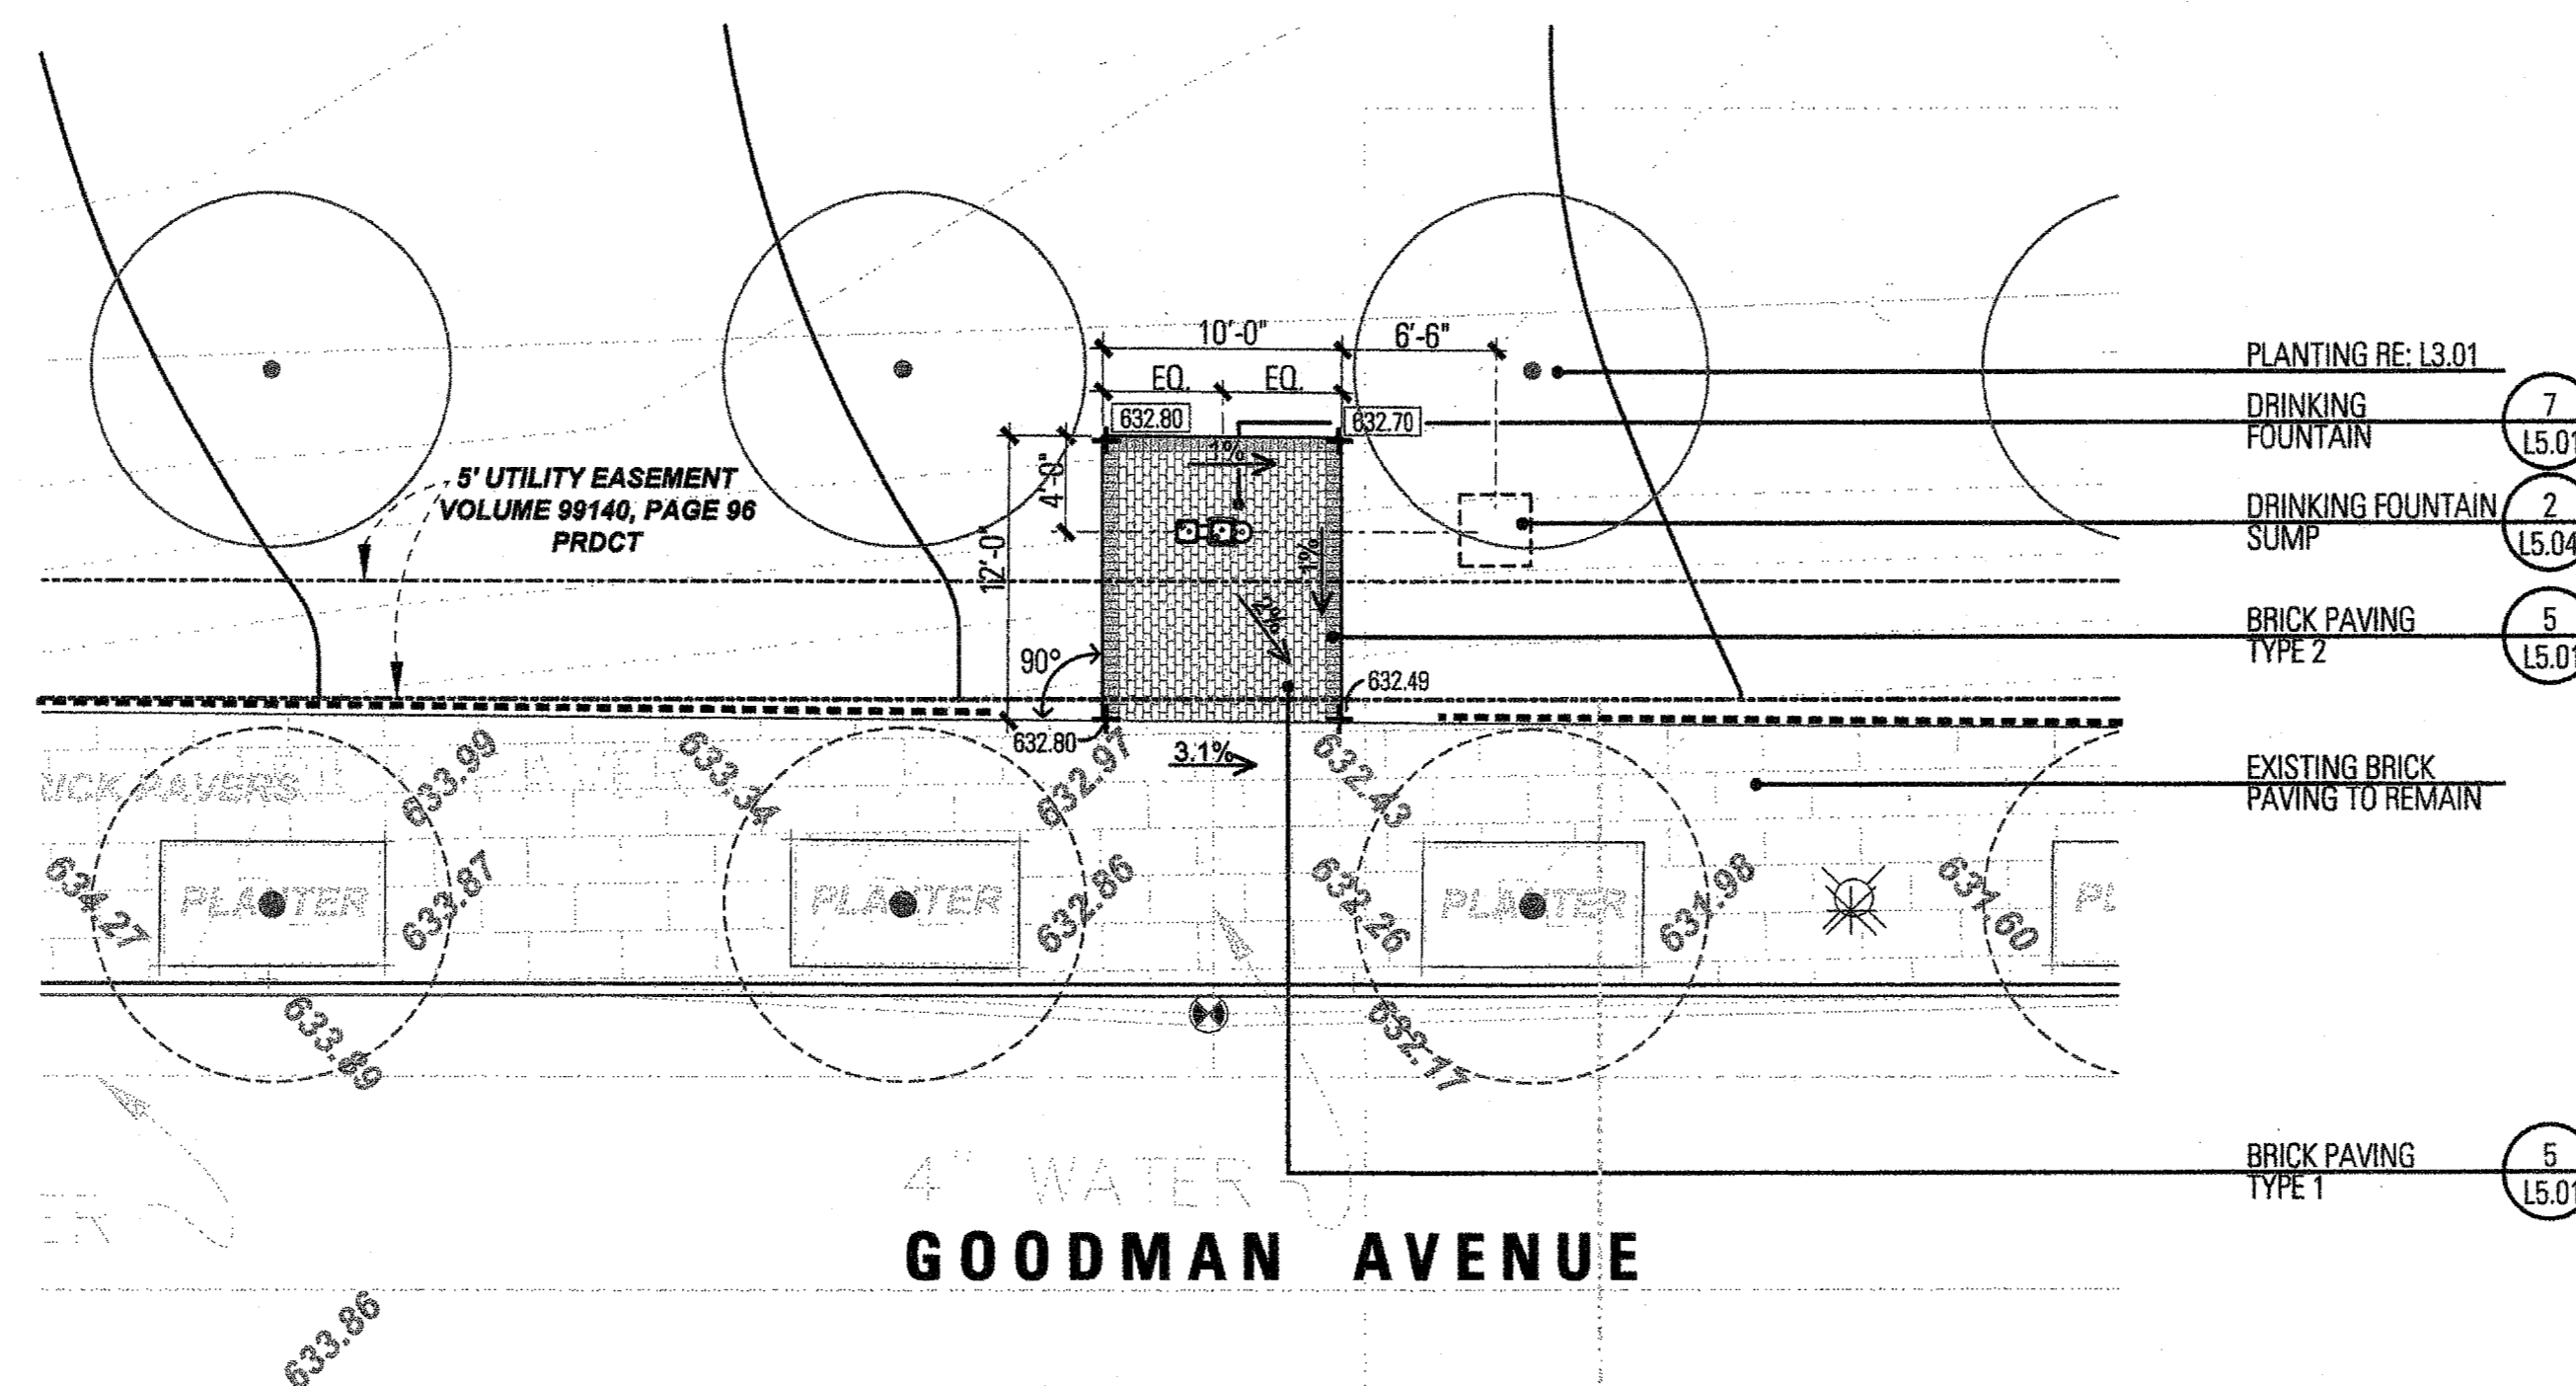

1 DRINKING FOUNTAIN/SUMP LAYOUT
SCALE: 1/8" = 1'-0"