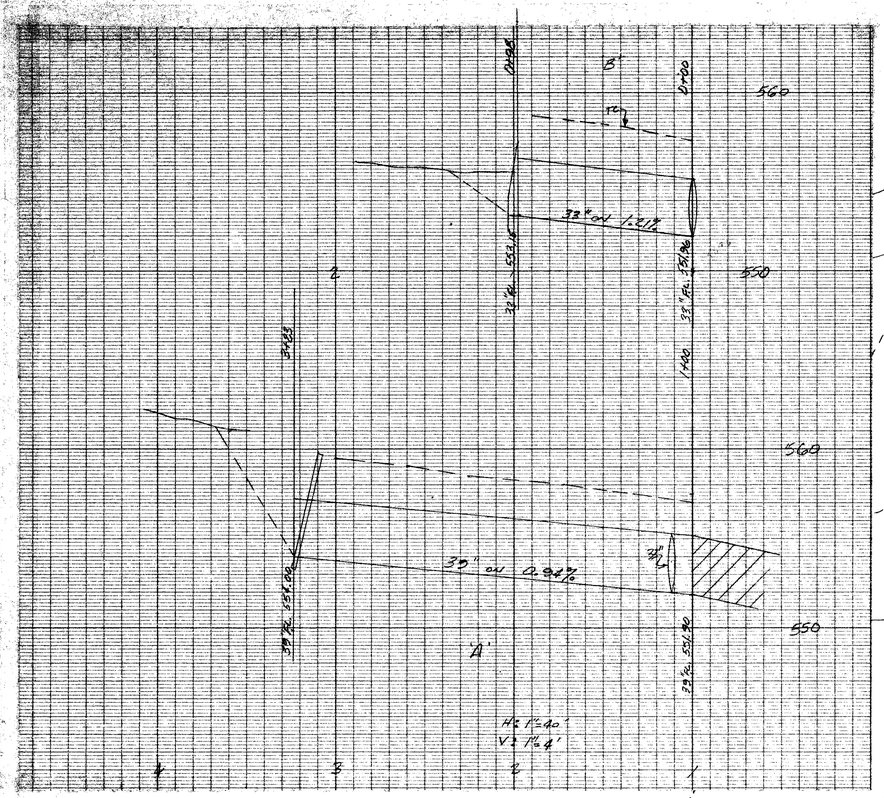

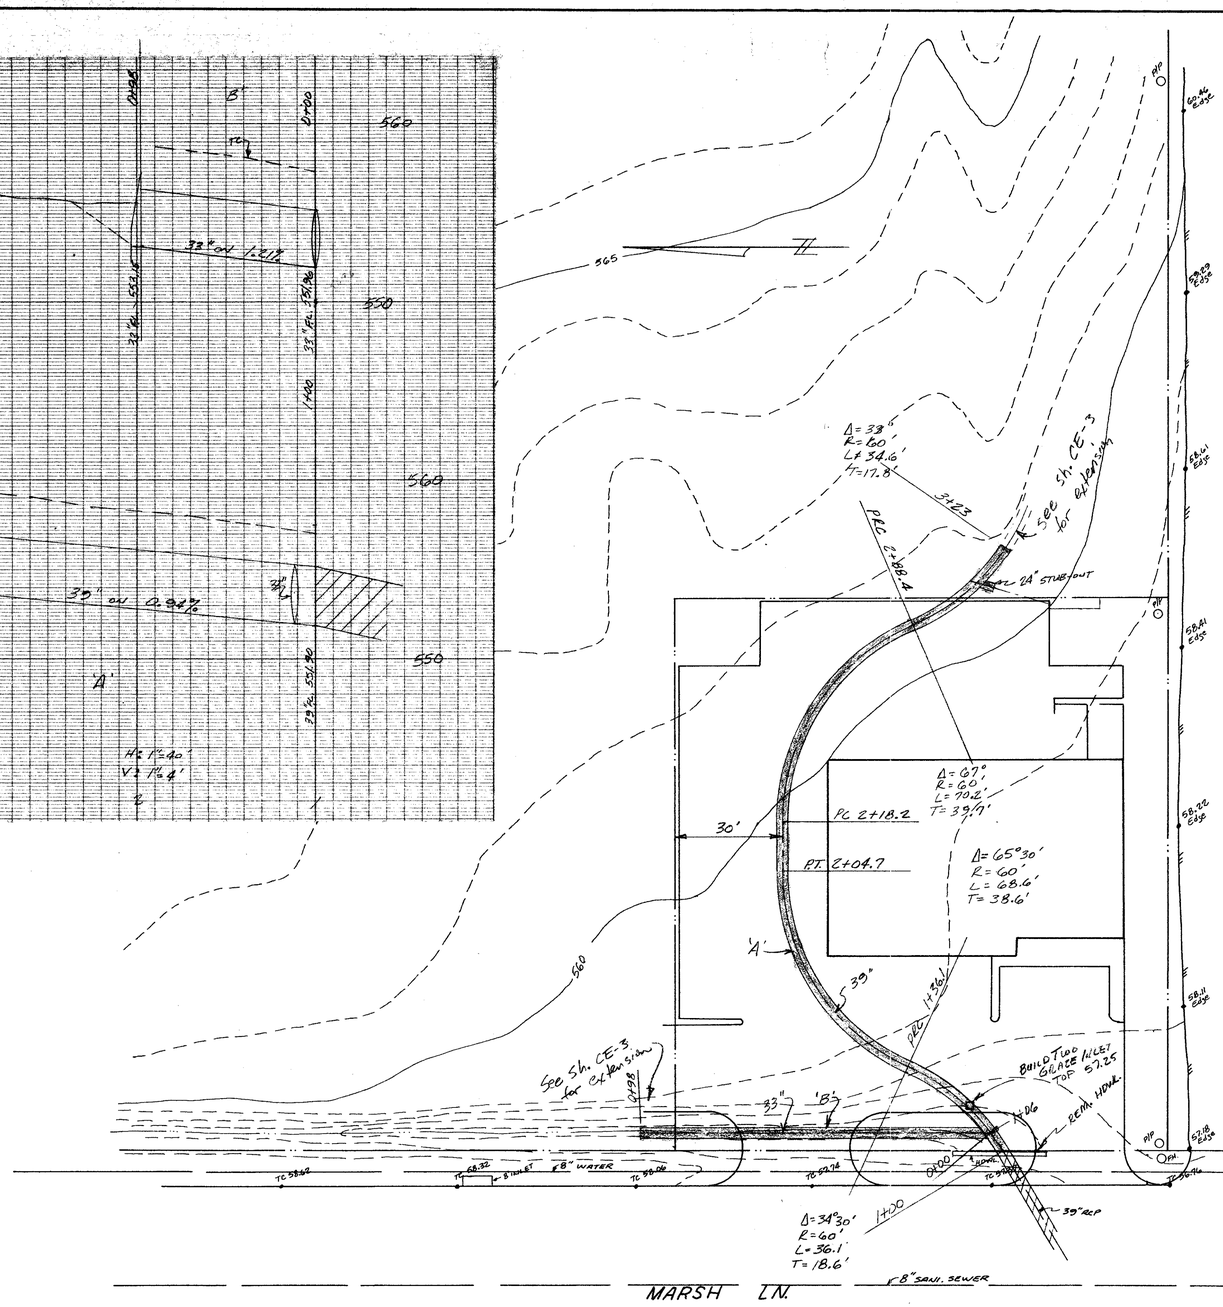

AS BUILT PLANS

THE INTENT OF THE OWNER WAS TO CONSTRUCT THE IMPROVEMENTS ACCORDING TO THESE PLANS AS APPROVED BY THE CITY. THE LINES AND GRADES WERE SET ON THE GROUND FOR CONSTRUCTION ACCORDING TO SAID PLANS. THE OWNER OR ENGINEER DID NOT VERIFY LINES OR GRADES AFTER CONSTRUCTION. WE ARE NOT AWARE OF ANY CHANGES OR REVISIONS TO THESE PLANS DURING CONSTRUCTION OTHER THAN THOSE SHOWN.

FERGUSON-DEERE, INC.
BY [signature] DATE 1/22/86

REVISED BY	DATE	COMMENT
	30 Nov 84	Rev. to incl. w/total project
	24 [illegible] 84	

FERGUSON- DEERE, INC. CONSULTING ENGINEERS 9817 KINGSLEY ROAD DALLAS, TEXAS 75238 PHONE 348-2821 DATE	UTILITY PLAN GOODYEAR STORE GREENHAVEN VILLAGE	SCALE H-1"=20' V-1" SHEET NO. CE/2

P.N. 530