E-918

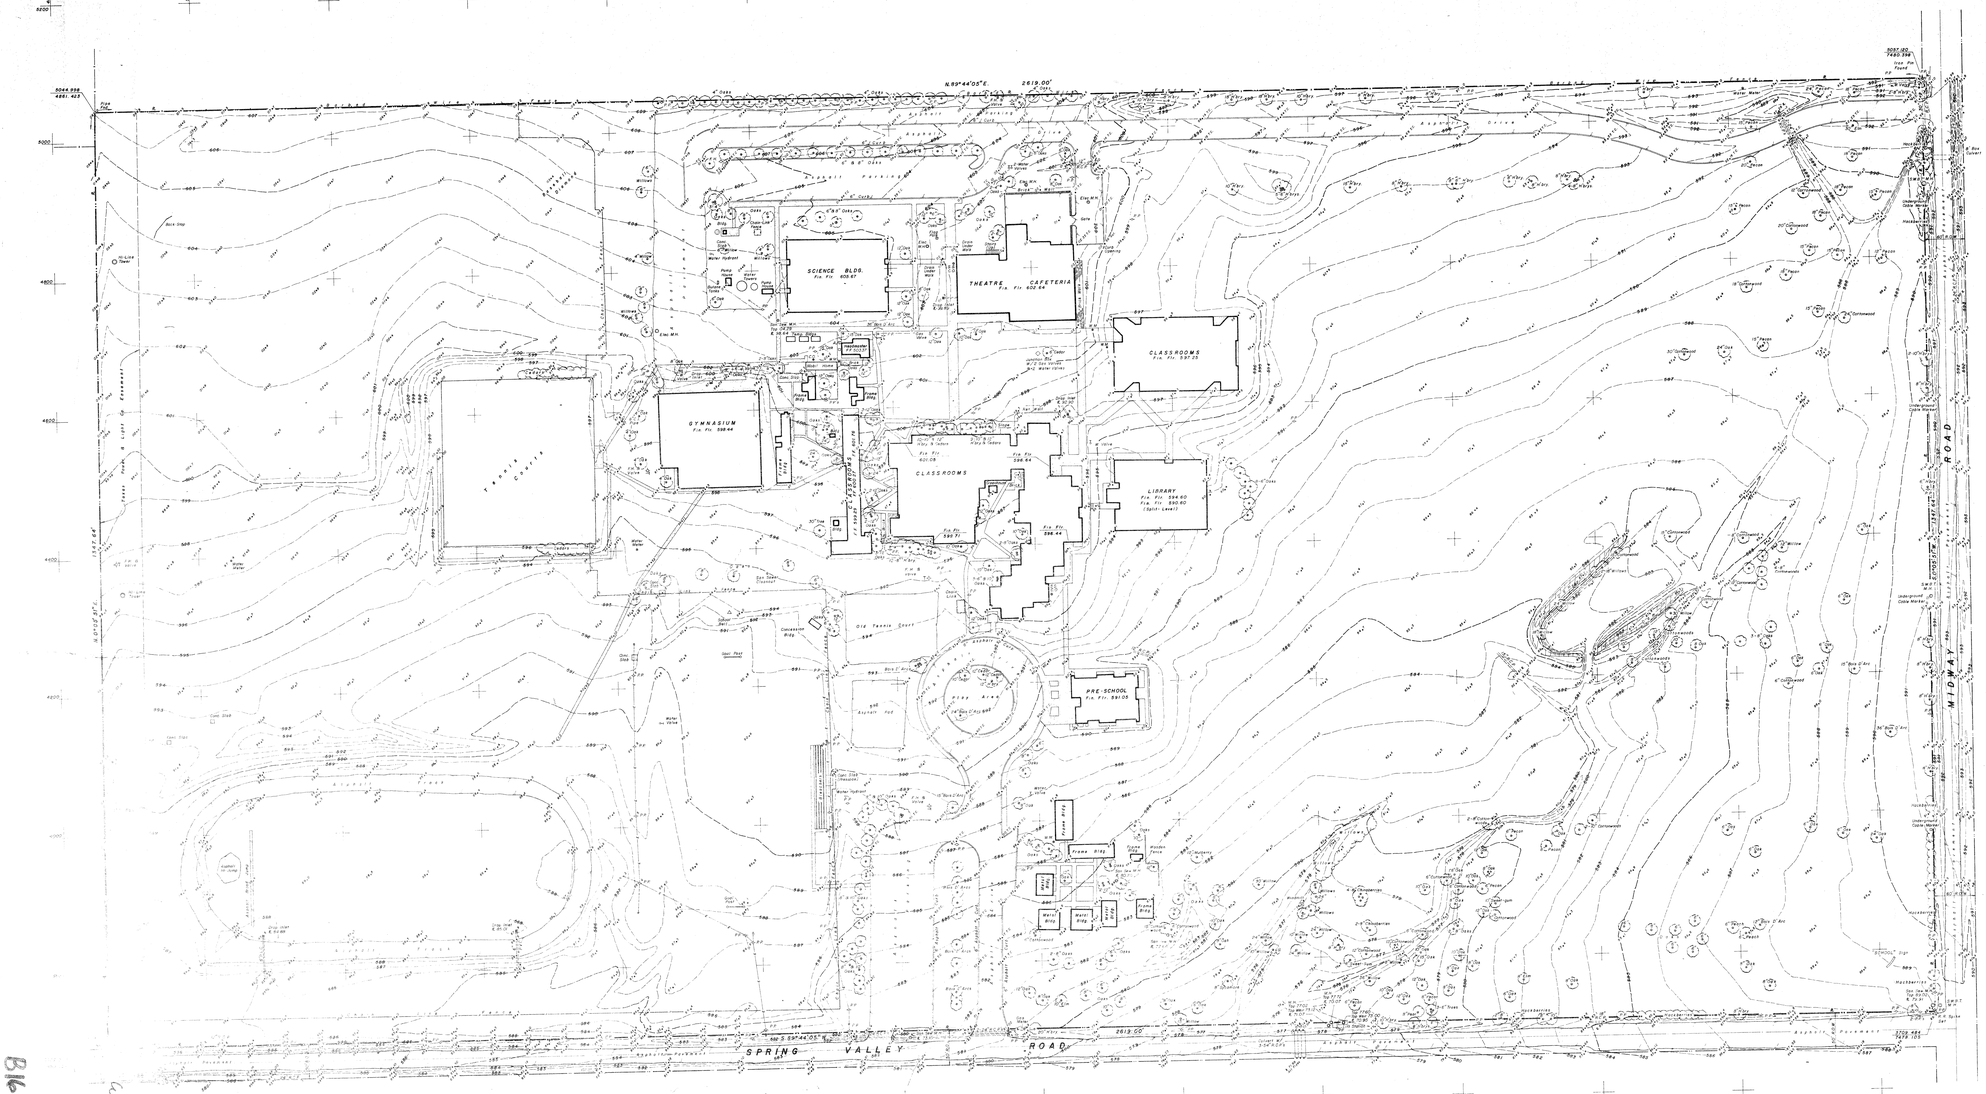

FIELD NOTES

BEING a track situated out of the Thos. L. Chenoweth Survey, Abstract No. 273, Dallas County, Texas, and being the same tract conveyed to The Greenhill School by Jeanne E. Cassidy, Inc. by deed recorded in Volume 5330, Page 453, Deed Records, Dallas County, Texas, and being more particularly described as follows:

BEGINNING at the intersection of the centerline of Midway Road (60' right-of-way) and the north line of Spring Valley Road (50' right-of-way);

THENCE S 89°44'05" W, along the north line of Spring Valley Road a distance of 2619.00 feet to a point for a corner;

THENCE N 00°05'51" W, along an old fence line 1347.64 feet to a point for a corner;

THENCE N 89°44'05" E, along an old fence line 2619.00 feet to a point for a corner, said corner being in the west line of Midway Road;

THENCE S 0°05'51" W, along the west line of Midway Road a distance of 1347.64 feet to the place of beginning, and containing 81.0108 acres of land.

I hereby certify that this survey was made on the ground to a hypothetical boundary line and does not represent a boundary survey. But that this plat correctly represents the facts as found at the time of survey.

Maurice T. Worrell, III, P.E.
Registered Professional Engineer
Registration No. 24790

NORTH

SCALE: 1" = 50'

Bench Mark:
Northwest Corner Of Tennis Courts
ELEV. 594.00

BOUNDARY & TOPOGRAPHIC SURVEY

GREENHILL SCHOOL

OUT OF THE
THOMAS L. CHENOWETH SURVEY, ABST. No. 273
DALLAS COUNTY
CITY OF ADDISON, TEXAS

PREPARED BY:
Worrell & Associates
Planners - Engineers
11500 Stemmons Fwy - Suite 116
Dallas - Texas
214/241-1467 Dec. 1977

GREENHILL SCHOOL
topographic survey

B16-3

B16-3