
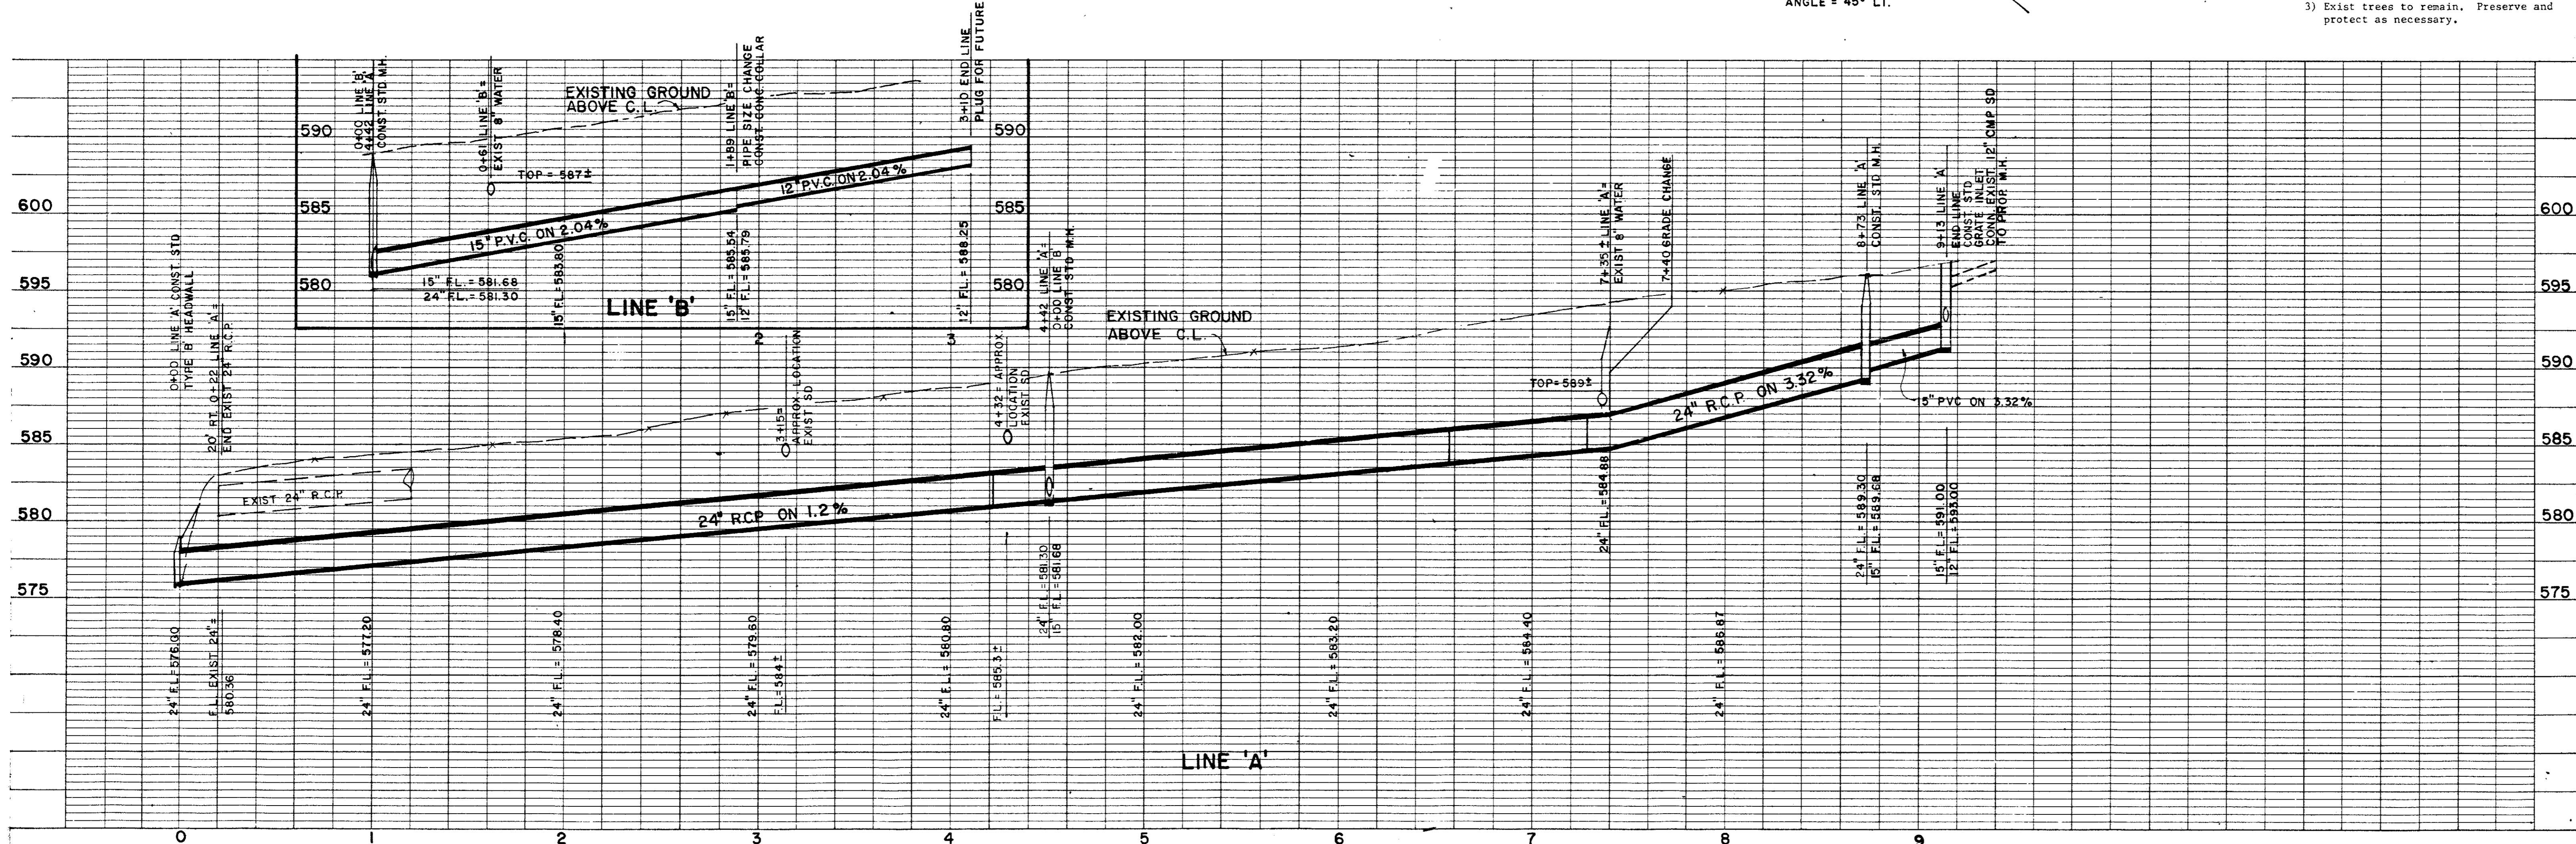


**GREENHILL
UPPER
SCHOOL**

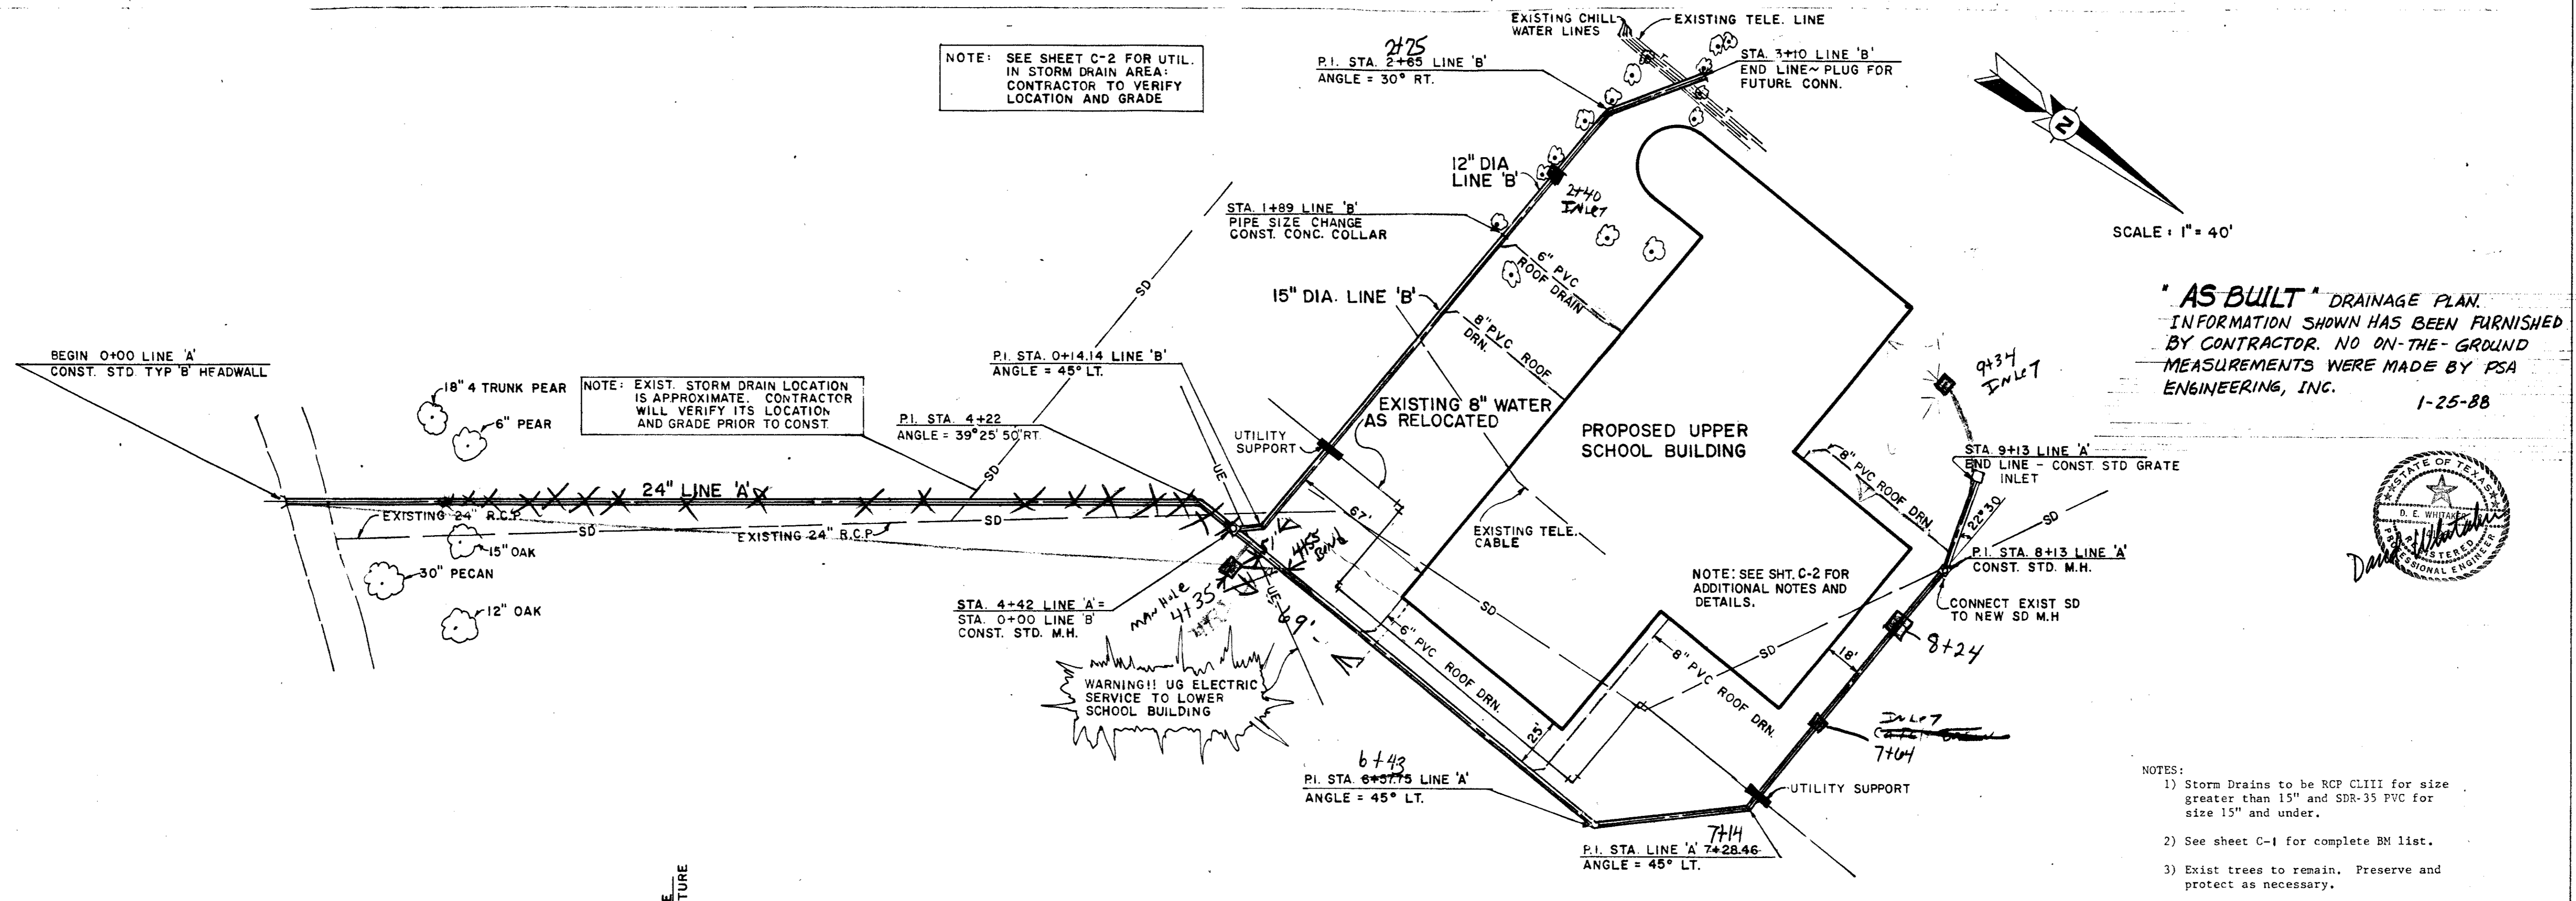

- NOTES:
- 1) Storm Drains to be RCP CLIII for size greater than 15" and SD-35 PVC for size 15" and under.
 - 2) See sheet C-1 for complete BM list.
 - 3) Exist trees to remain. Preserve and protect as necessary.

DRAINAGE PROFILE

HIDELL

ARCHITECTS

2811 MCKINNEY AVENUE, SUITE 207
DALLAS, TEXAS 75204 (214) 855-0335

David Whitaker 7-27-87

PSA ENGINEERING
CIVIL ENGINEERS
13747 MONTFORT DR.
DALLAS, TEXAS 75240 214 960-1137

Revisions

Job No. 87005

Issue Date: August 15, 1987

Drawn By: PSA

Checked By: _____

Sheet No. C-3

of: _____