


# CITY OF ADDISON DALLAS COUNTY, TEXAS

## CONSTRUCTION PLANS FOR: INWOOD ROAD SEWER LINE AND DOOLEY ROAD WATER LINE EXTENSION

**RECORD  
DRAWINGS**

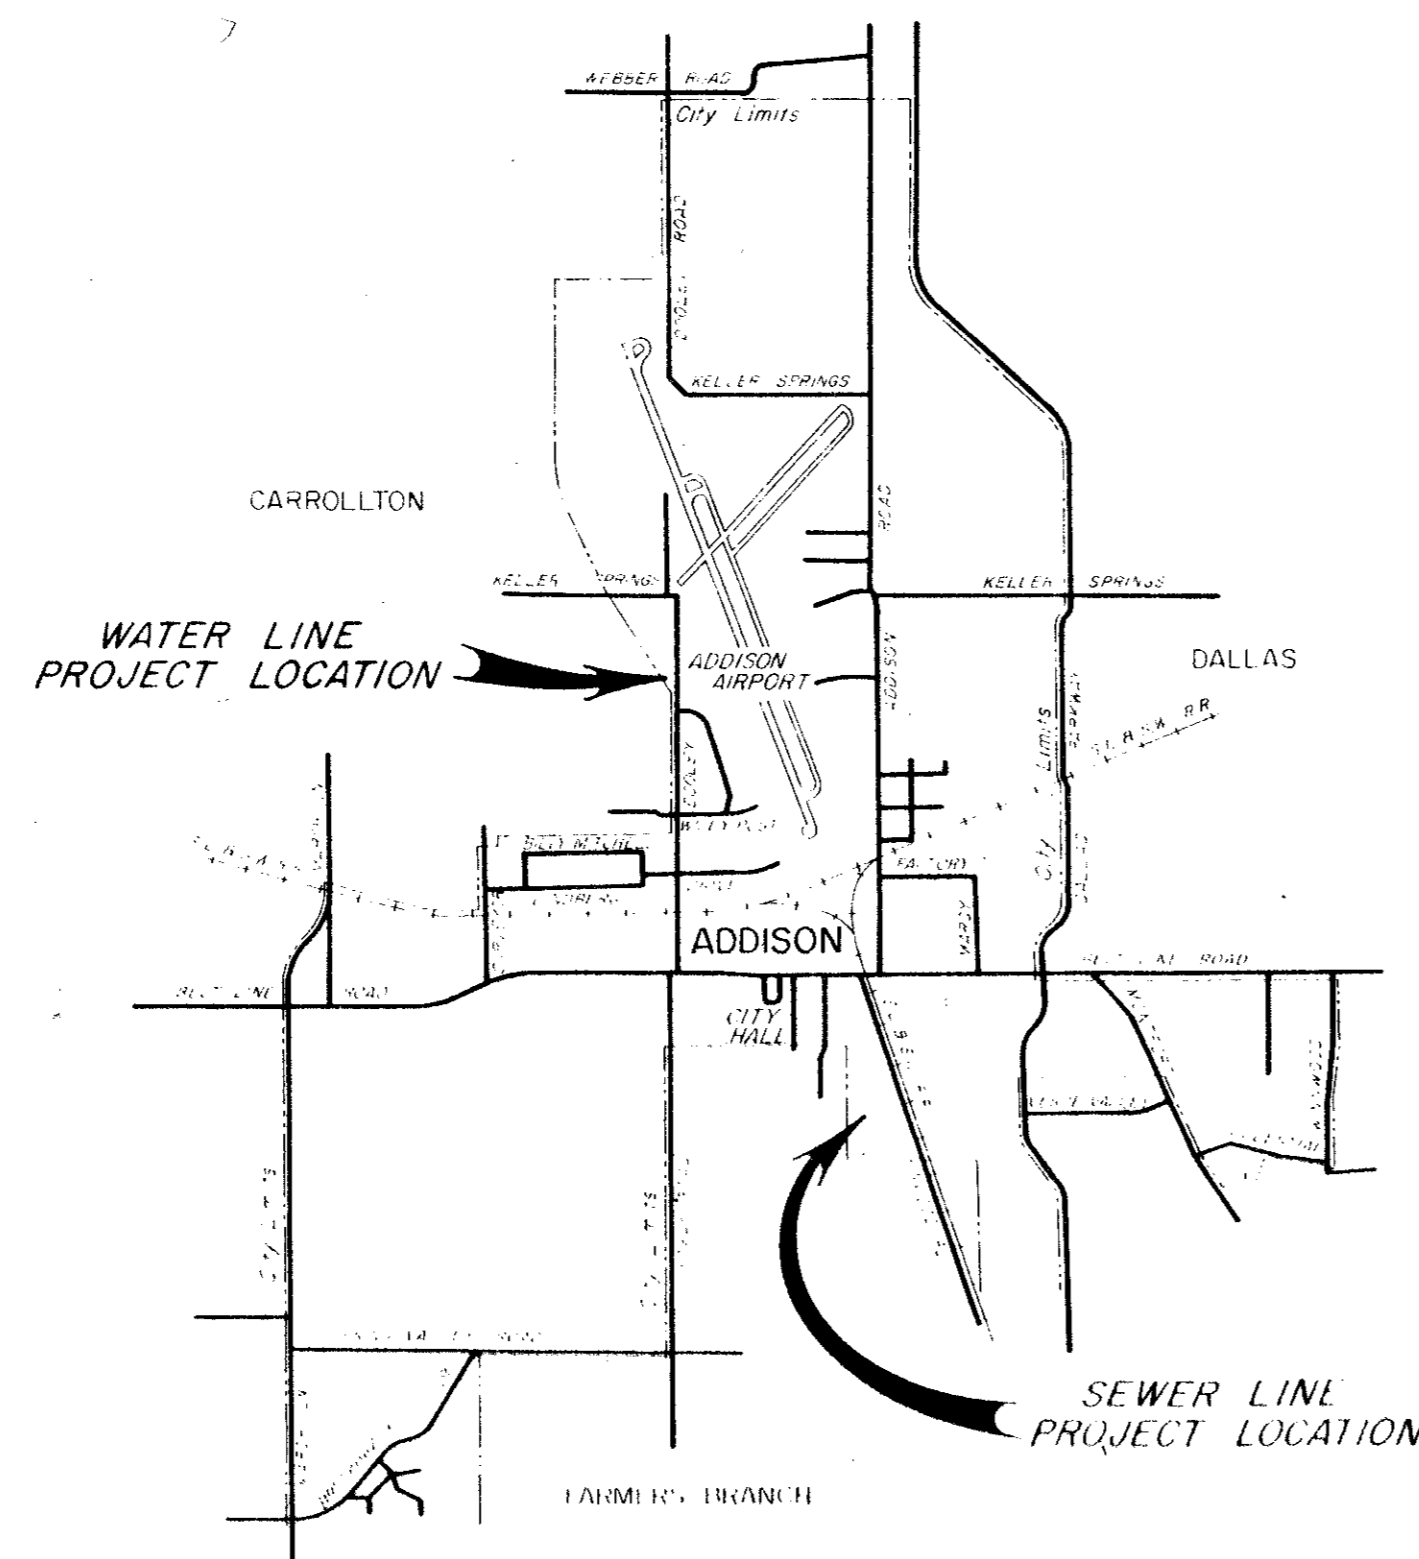

**JERRY J. REDDING - MAYOR  
COUNCILMEN:**

**JOHN B. ALLEN  
FAYE EDMISTON  
LEON HENDERSON  
A. E. MARCY  
TERRY ROBERTS**

**C. J. WEBSTER - CITY ADMINISTRATOR**

**GINN & STACY, INC.**  
CONSULTING ENGINEERS  
DALLAS, TEXAS  
1976

*Drawn 3  
# 2*