



DATE: _____ BY: _____
 PLAN
 NOTE BOOK GRADES CHECKED: _____
 ALIGNMENT CHECKED: _____
 # OF WAYS CHECKED: _____
 No. _____

DATE: _____ BY: _____
 PROFILE
 NOTE BOOK GRADES CHECKED: _____
 ALIGNMENT CHECKED: _____
 # OF WAYS CHECKED: _____
 No. _____

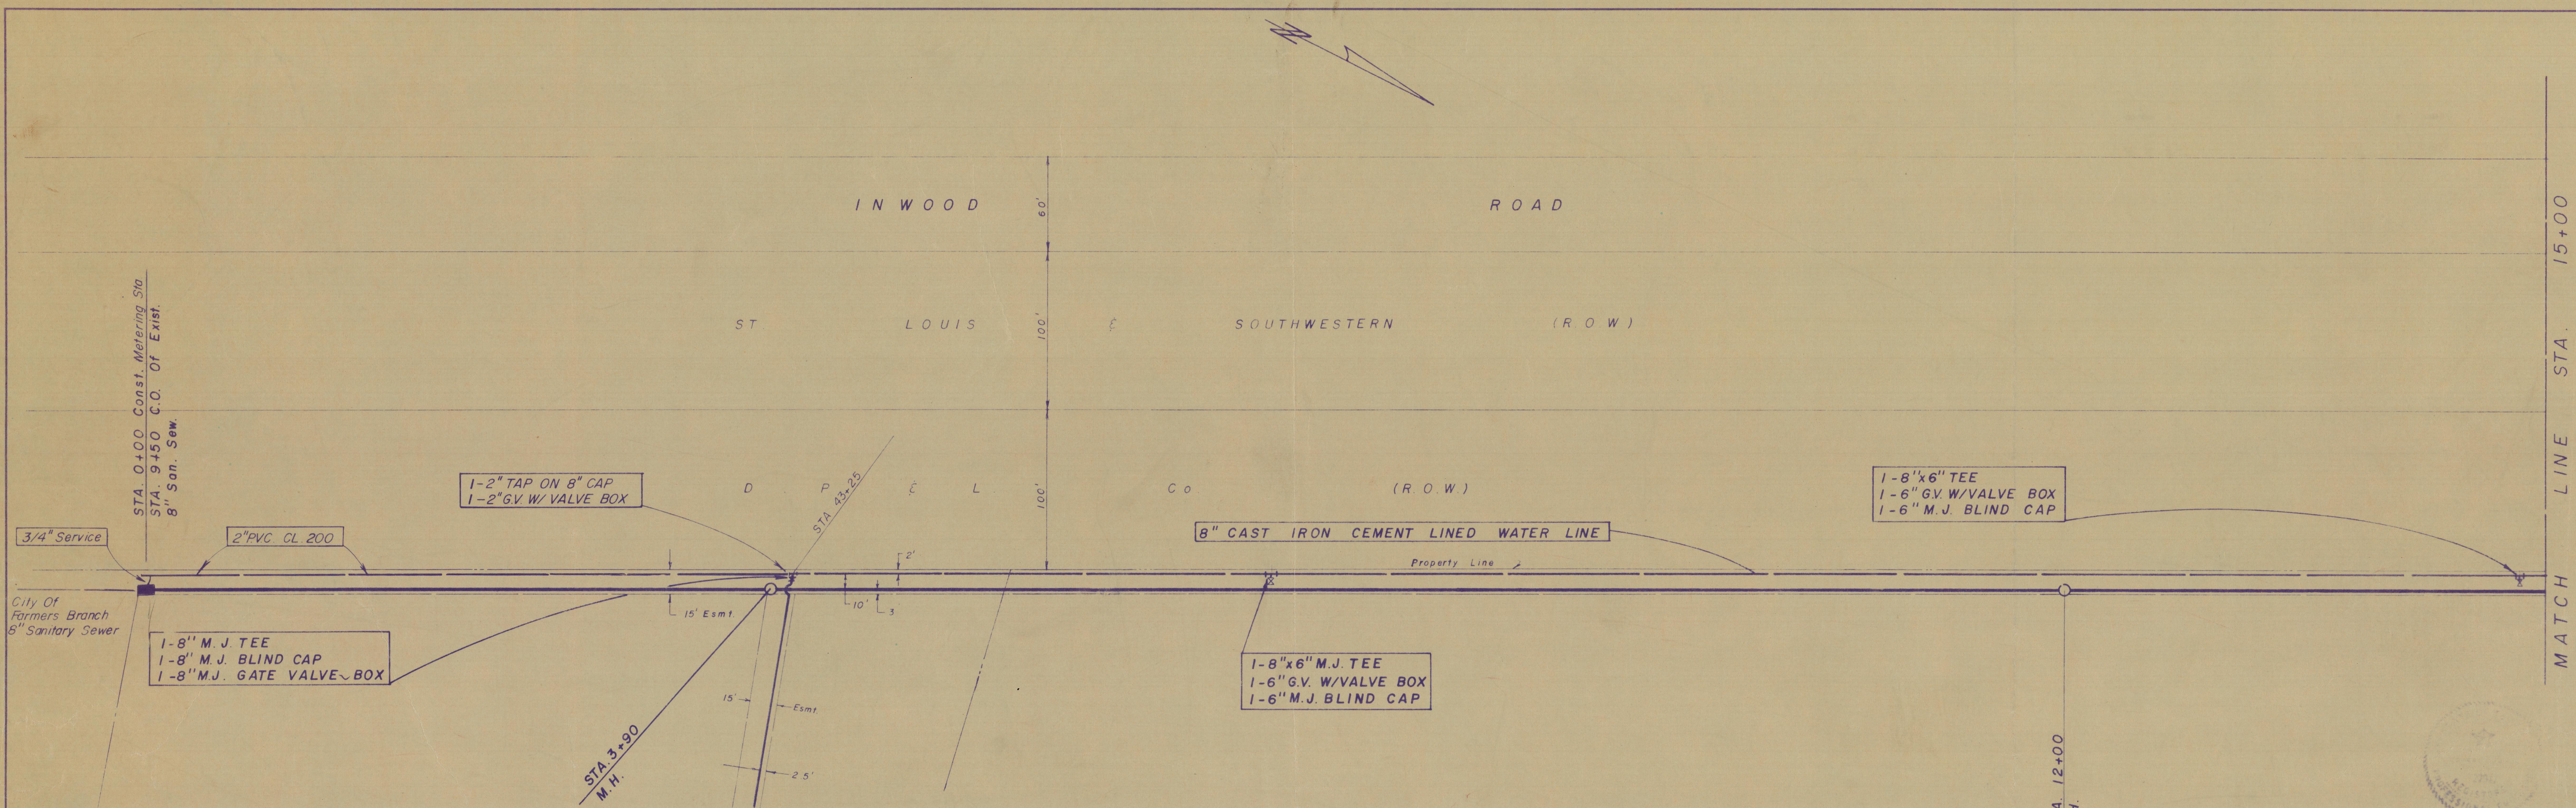

CITY OF ADDISON, TEXAS - SANITARY SEWER IMPROVEMENTS

CHANGE ORDER #1

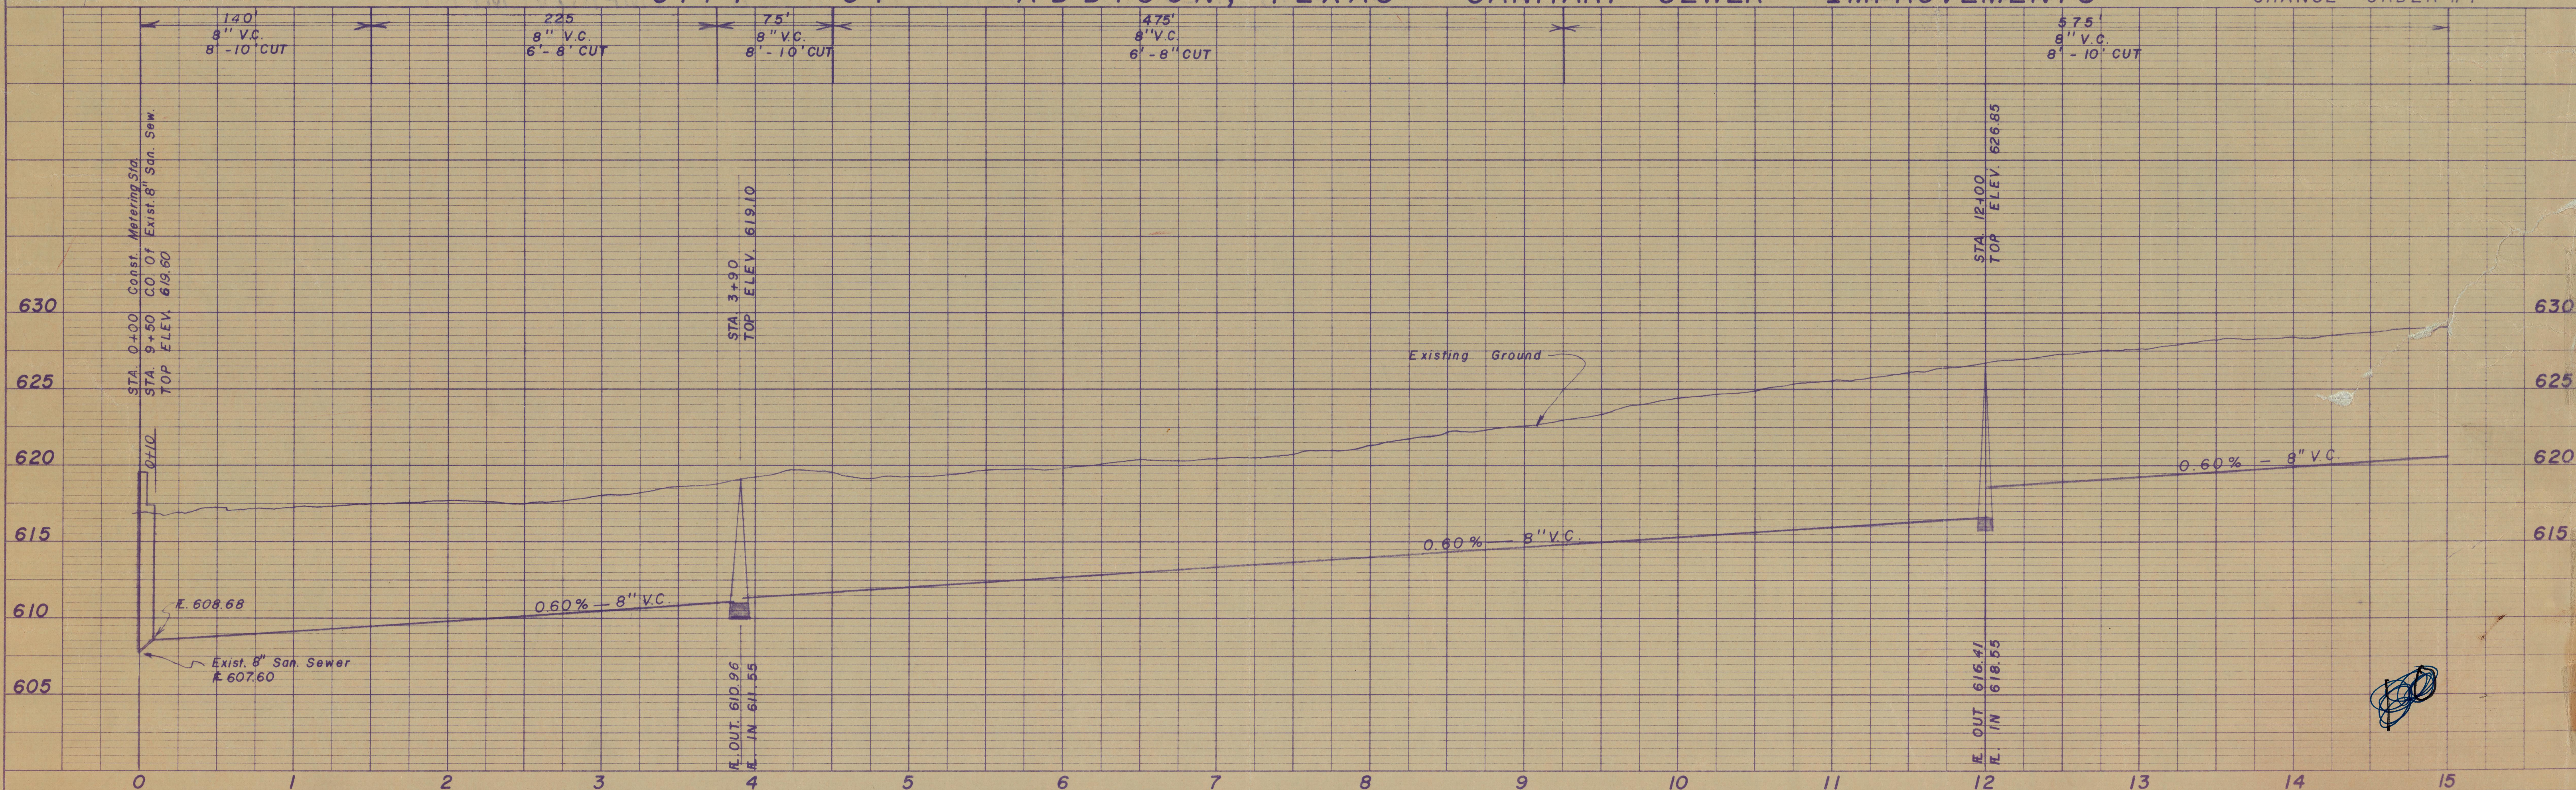

Drawer 7
 #2

Drawer 7
 #2