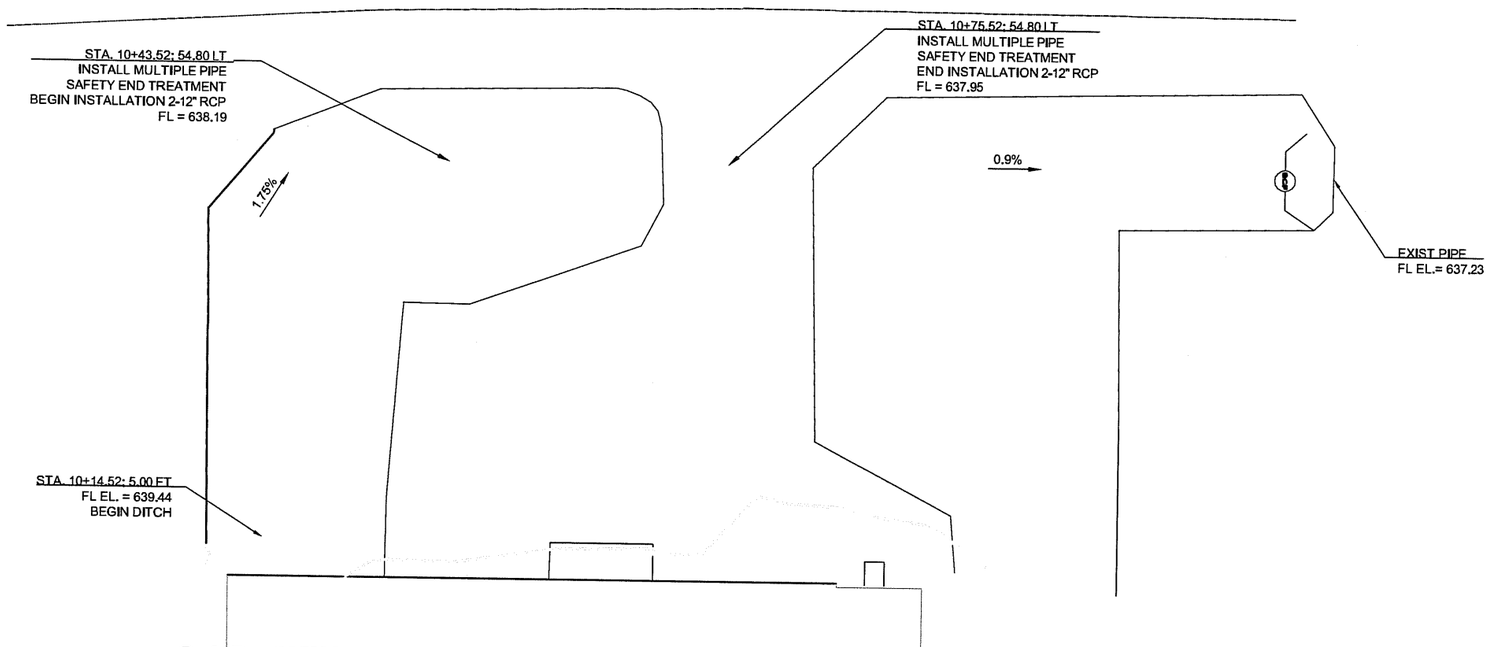

S-1 PARKING LOT DRAINAGE AND EROSION CONTROL PLAN

NO SCALE

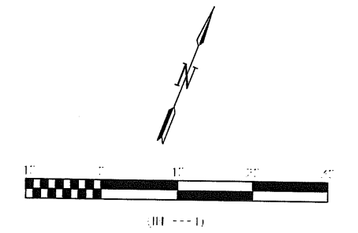

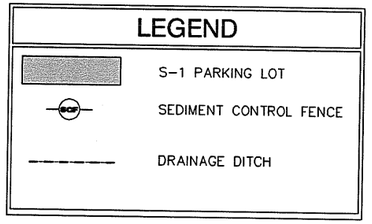

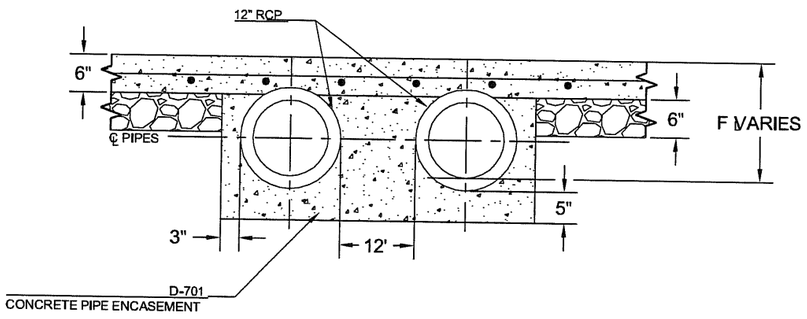

CONCRETE PIPE ENCASEMENT DETAIL

NO SCALE

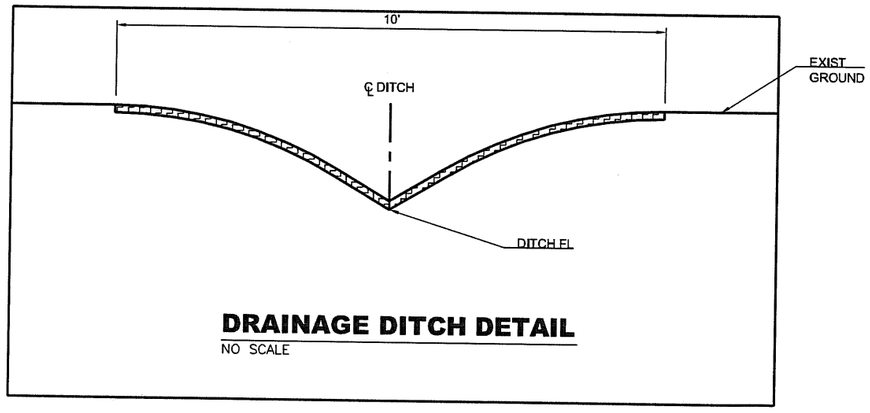

DRAINAGE DITCH DETAIL

NO SCALE

RECORD DRAWINGS
10-30-2012

GARVER

REGISTRATION NO. F-5713

STATE OF TEXAS
FRANK O. MCILLWAIN
93229
LICENSED PROFESSIONAL ENGINEER

REV.	DATE	DESCRIPTION	BY

ADDISON AIRPORT
ADDISON, TX

S-1 PARKING LOT IMPROVEMENTS

DRAINAGE AND STORMWATER POLLUTION PREVENTION PLANS

JOB NO.: 12081100
DATE: JULY, 2012
DESIGNED BY: MRM
DRAWN BY: EGC

BAR IS ONE INCH ON ORIGINAL DRAWING
0 1"
IF NOT ONE INCH ON THIS SHEET, ADJUST SCALES ACCORDINGLY.

SHEET NUMBER
G-105

File: I:\2012\20812100\Design\PAVING\S-1\Drawings\PAVING DETAILS.dwg, 10/30/2012 10:39 AM, Last saved by: Mrmconolly
Last Modified by: Mrmconolly, Plotted by: Mrmconolly, Plotter used: DWG To PDF.pc3