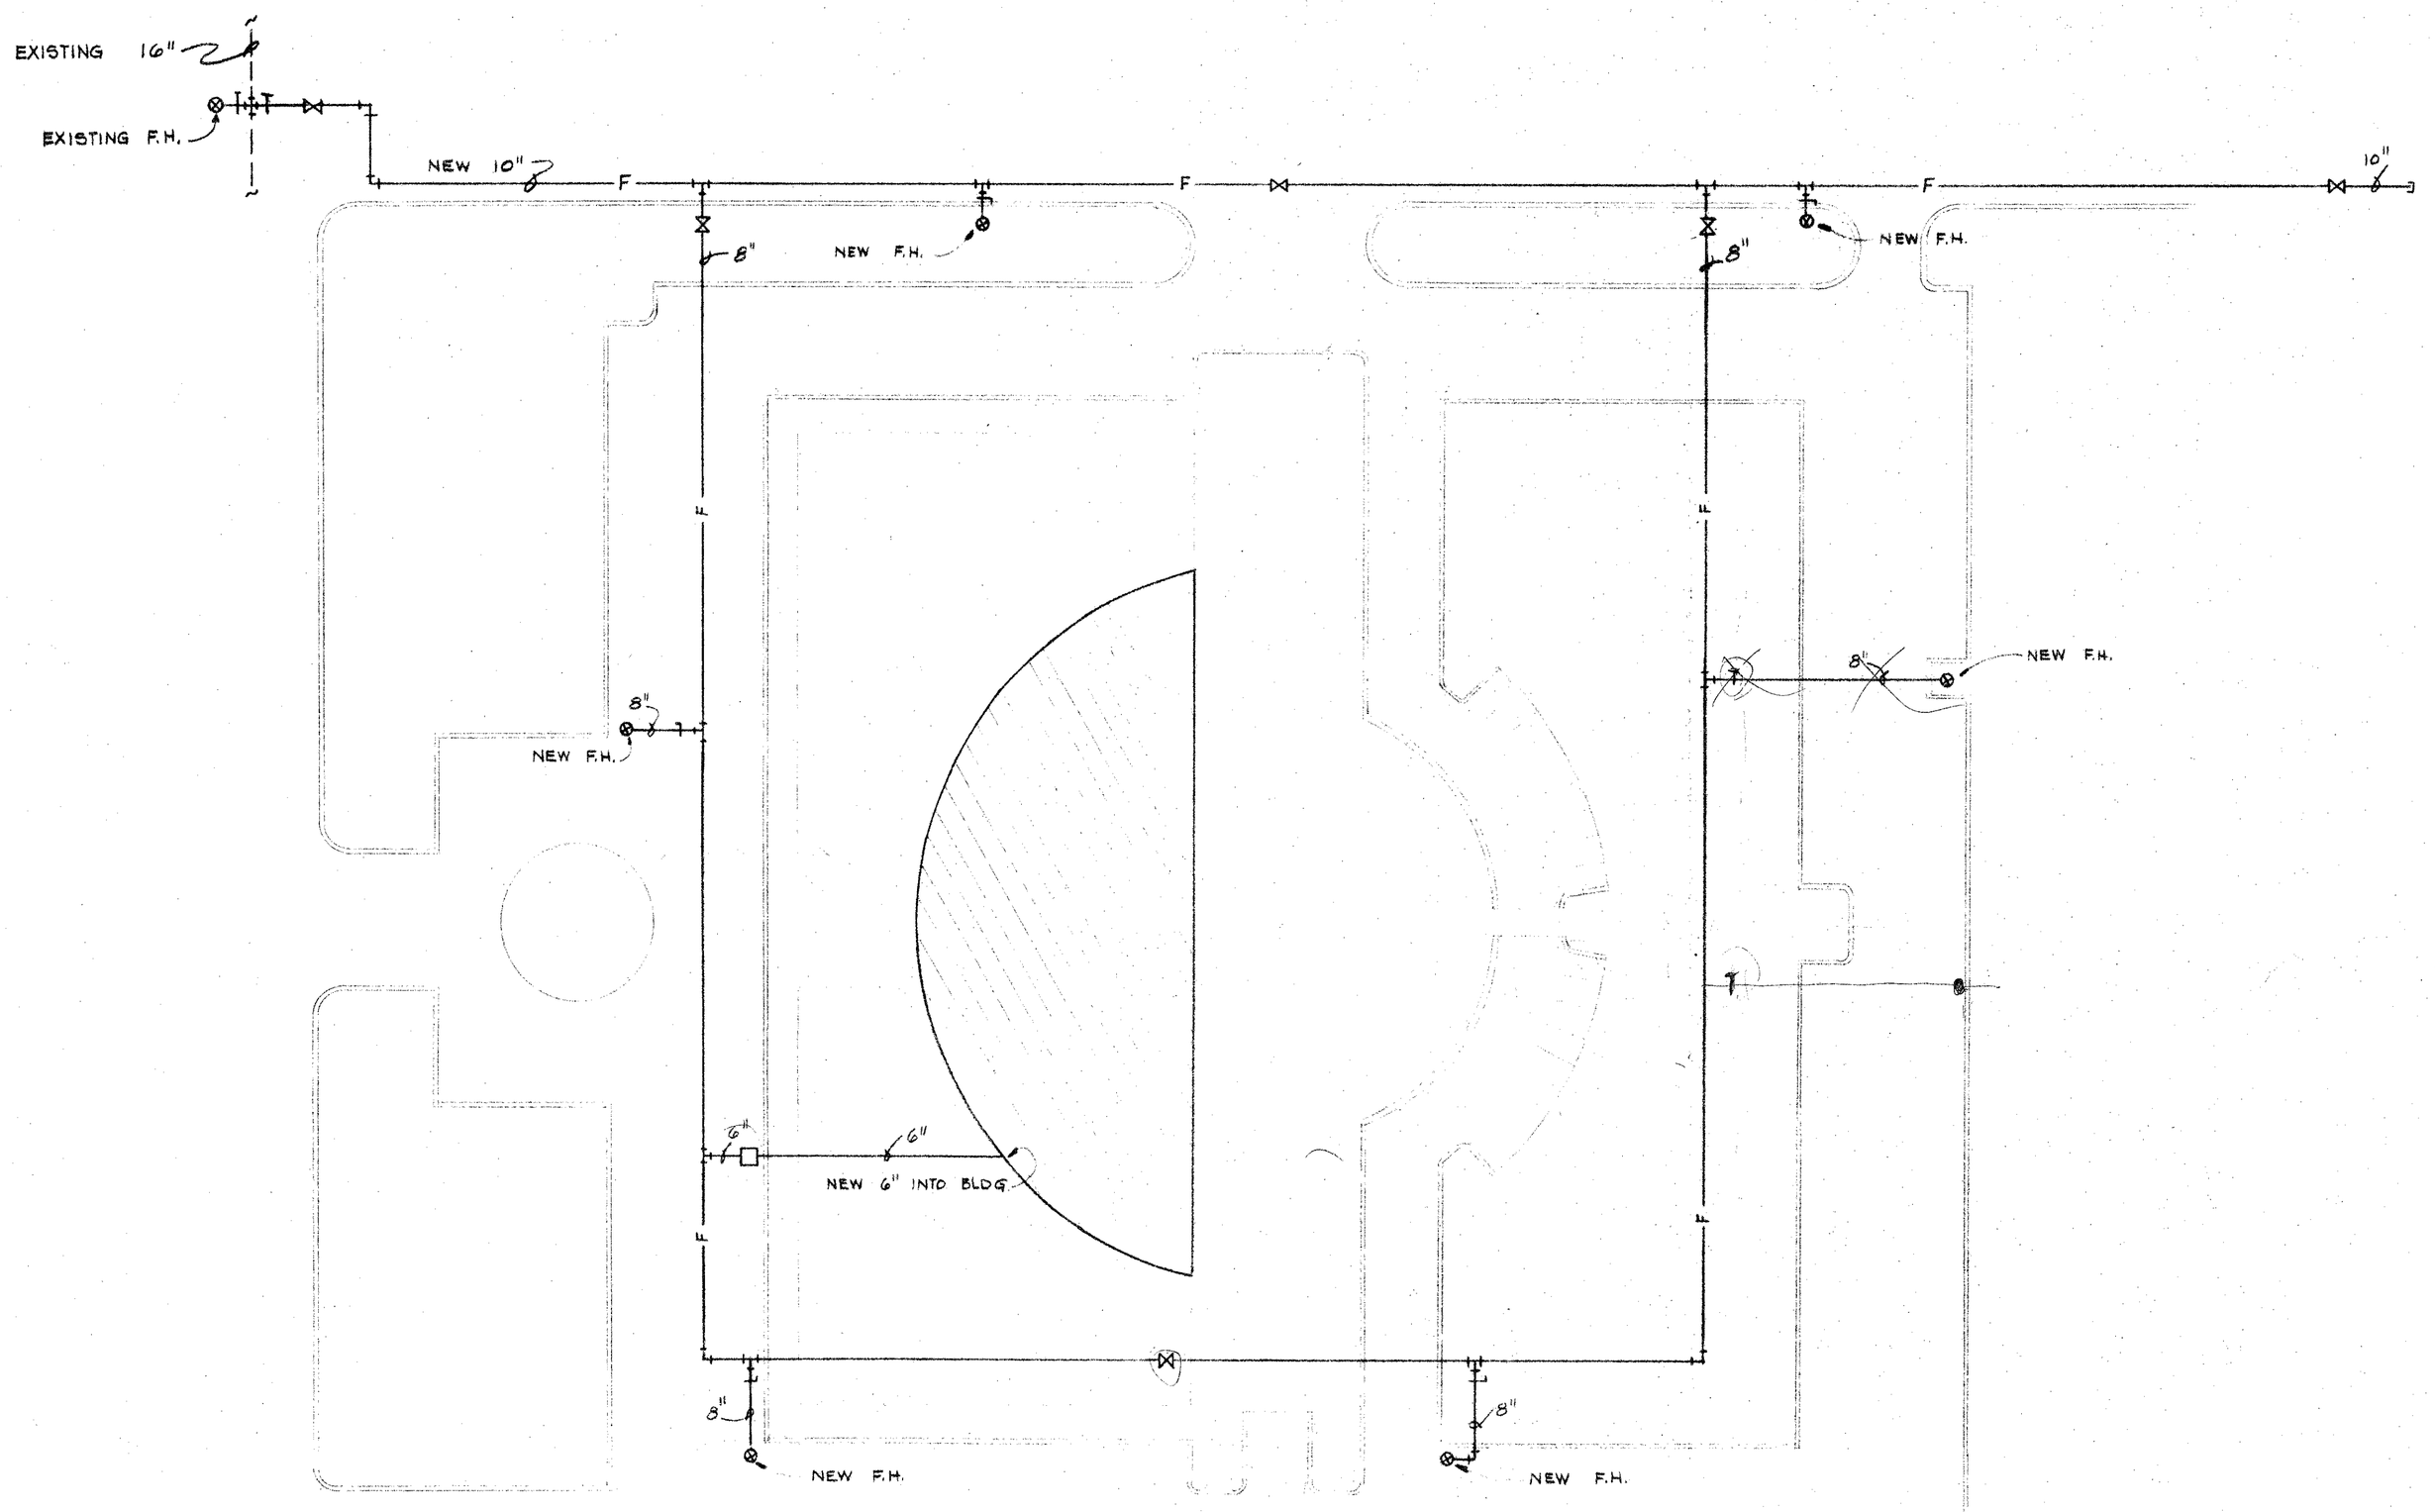

SITE PLAN - FIRE LOOP

SCALE 1" = 40'-0"

STATE OF TEXAS
WALTER E. CASH
21393
REGISTERED PROFESSIONAL ENGINEER

REV. NO.	DATE	DESCRIPTION	REV. BY

NATIONAL MECHANICAL CORPORATION
P. O. Box 402325
Dallas, Texas 75240
(214) 386-5200

JOB NAME: LIBERTY CORPORATION

DESCRIPTION: SITE PLAN - FIRE LOOP

DRAWN BY	SCALE	JOB NO.	DRWG. NO.
RD	AS SHOWN	8005	F-1
APPROVED BY	DATE		
RD	4/14/81		