LIGHT FIXTURE SCHEDULE

AA	STERNER #NI-19-F-49-840-I-120-D/RSA08-R-D-N, BLACK FINISH WITH DIODE FOR EACH LAMP, 10 FOOT TILTING POLE.	32-40 WATT INCANDESCENT
BB	KIM #81-202/BL-E/PB14-3188HB/BL-E/BMV-233, FOURTEEN FOOT TILTING POLE.	250 WATT BRIGHT WHITE DELUXE MERCURY VAPOR
CC	STERNER #NI-19-F-N-840-I-120-D/RSA07-R-D-N, BLACK FINISH WITH DIODE FOR EACH LAMP, 10 FOOT TILTING POLE.	8-40 WATT INCANDESCENT
DD	LIGHTOLIER #LCG-5316, 42" HIGH BOLLARD, BLACK FINISH.	100 WATT A-23 MERCURY VAPOR BRIGHT WHITE DELUXE
EE	SAME AS TYPE 'BB', EXCEPT TWELVE FOOT TILTING BLACK POLE. PIER SHALL EXTEND 24" UP ABOVE PAVEMENT.	250 WATT BRIGHT WHITE DELUXE MERCURY
FF	HUBBELL #309-8/1338, LOCATED AS DIRECTED ON THE JOB SITE, BLACK FINISH.	100 WATT PAR 38 BLACKLIGHT MERCURY

EXISTING 10" WATER

NOTES BY SYMBOL "⬡"

1. STUB CONDUITS OUT AT PROPERTY LINE TO TELEPHONE CO. REQUIREMENTS.
2. UNDERGROUND PRIMARY BY ELECTRIC UTILITY COMPANY. VERIFY EXACT LOCATION.
3. 2-4" PVC FOR TELEPHONE COMPANY.
4. 6-3½" CONDUITS, EACH WITH 3-500 MCM AND 1-#3/0 NEUTRAL.
5. PAD MOUNTED TRANSFORMER BY ELECTRIC UTILITY CO.
6. INSTALL WP DUPLEX RECEPTACLES IN POLE BASE OF THIS FIXTURE & EXTEND 2#12 TO 20/1 CIRCUIT BREAKER IN PANEL 'L'. USE EXISTING CONDUIT WHERE FEASIBLE.
7. INSTALL WP DUPLEX RECEPTACLE ADJACENT TO LIGHT FIXTURE & EXTEND 2#12 IN EXISTING CONDUIT TO 20/1 CIRCUIT BREAKER IN PANEL 'L'

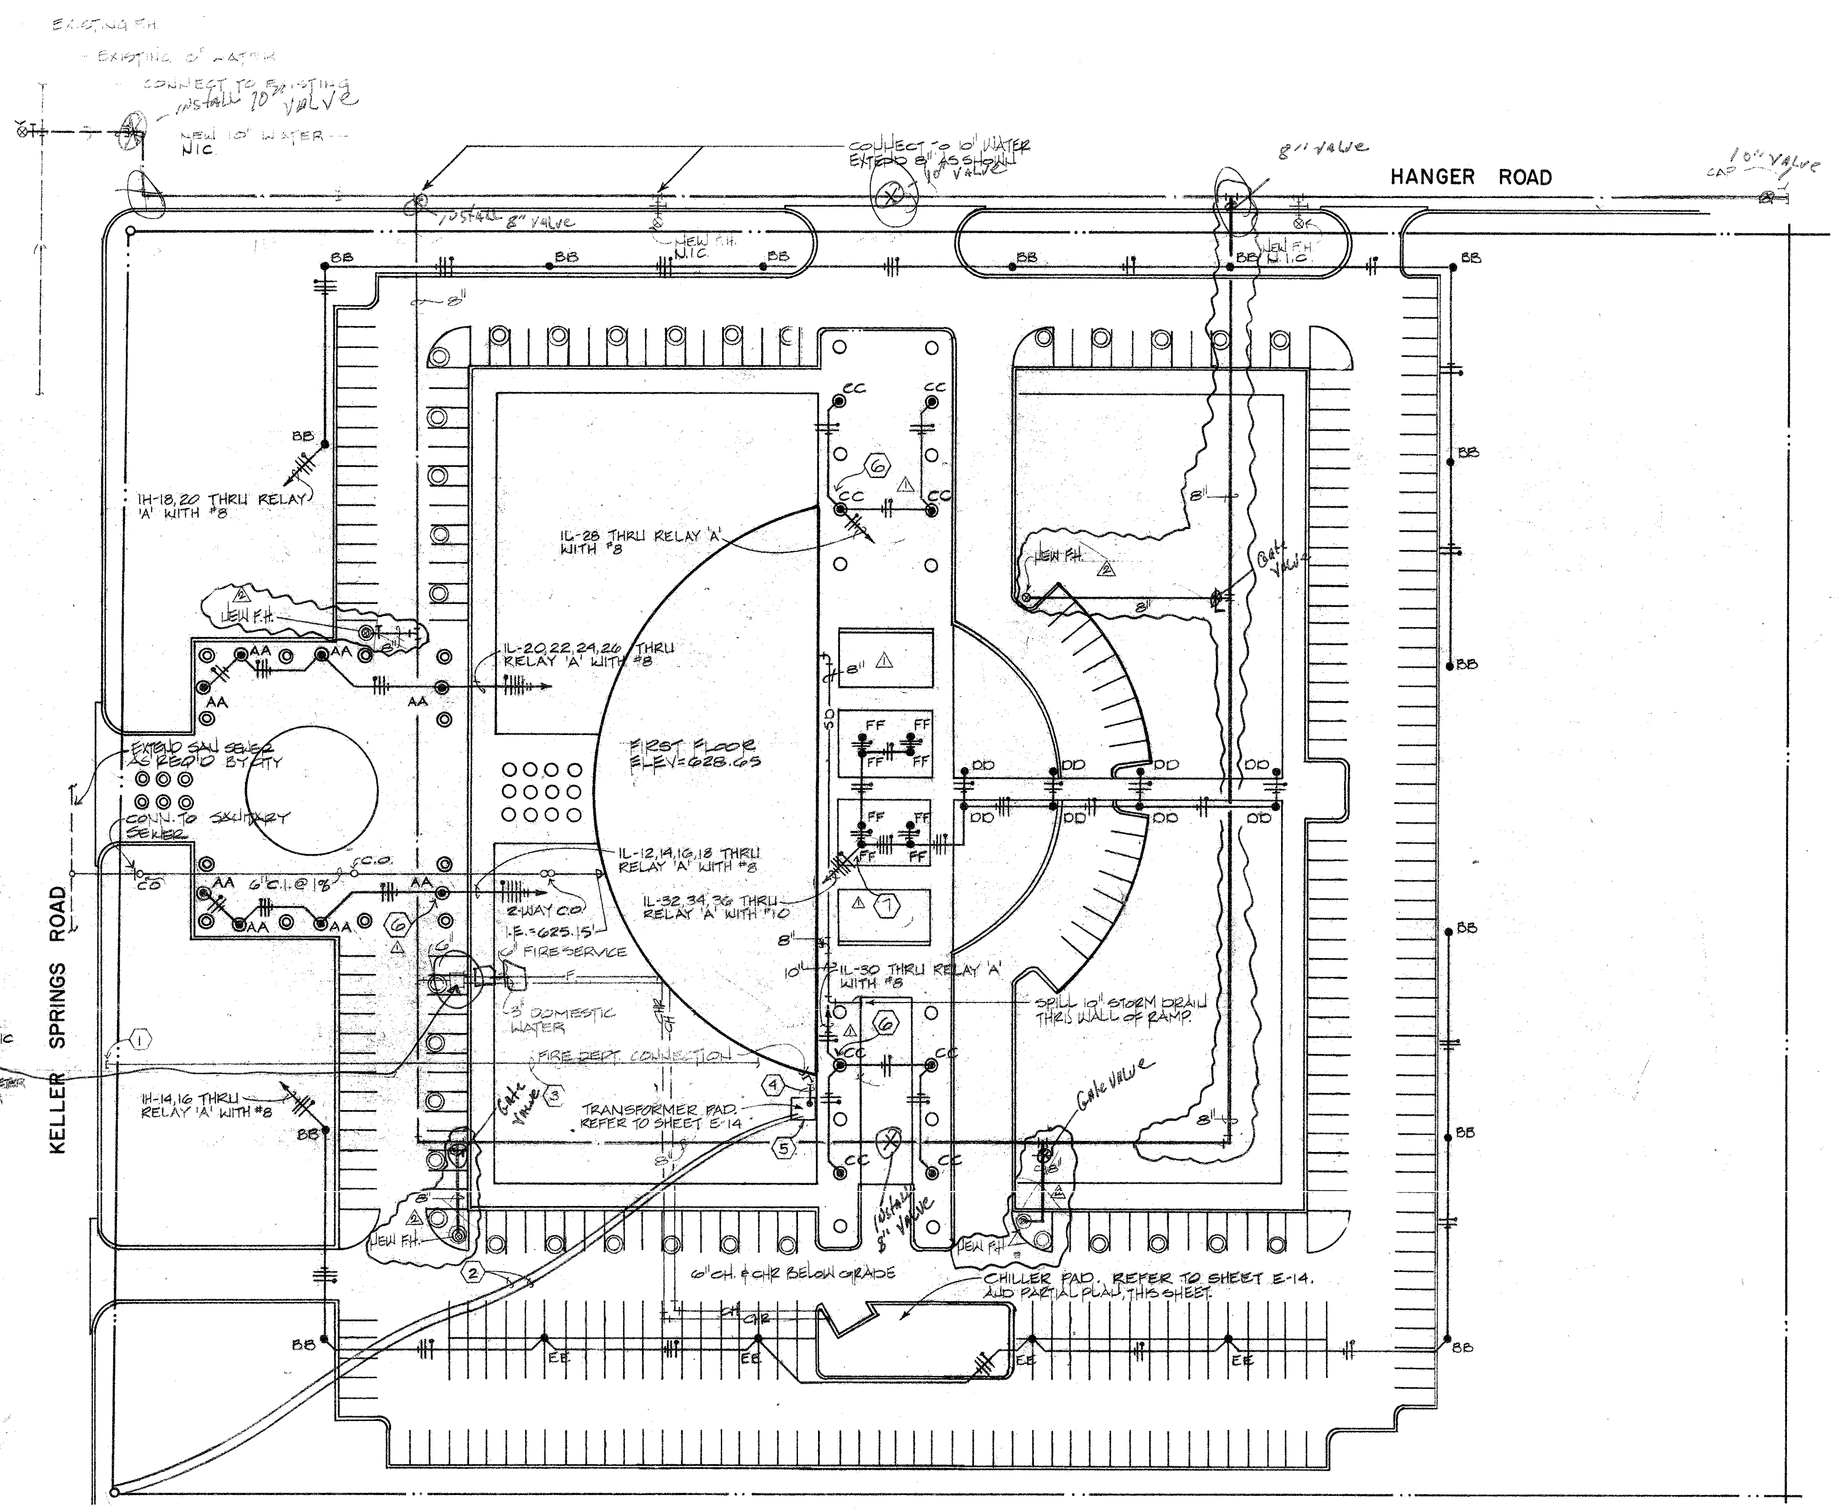

SITE PLAN
SCALE: 1"=40

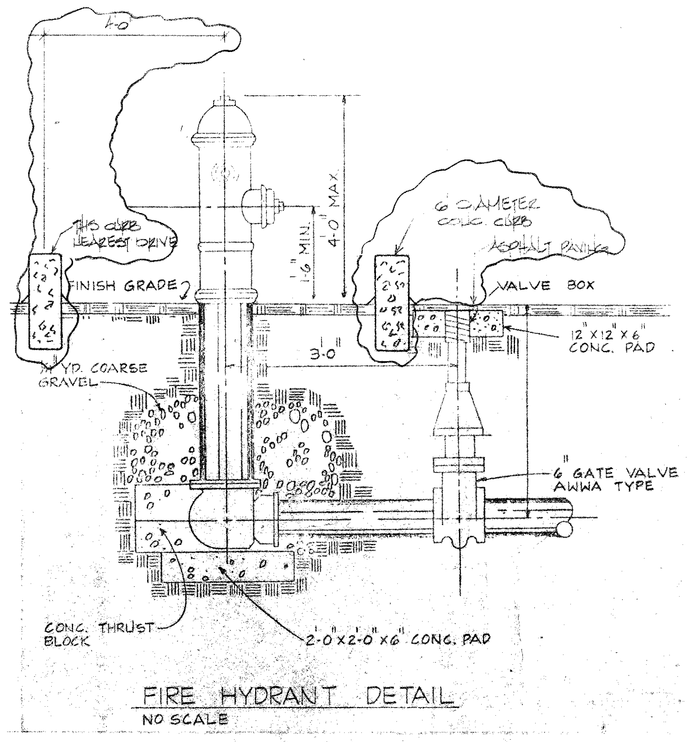

FIRE HYDRANT DETAIL
NO SCALE

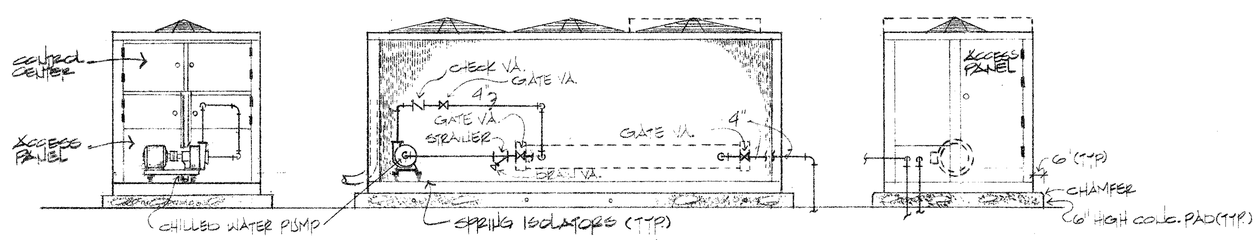

CHILLER & PUMP DETAIL
SCALE: 1/4"=1'-0"

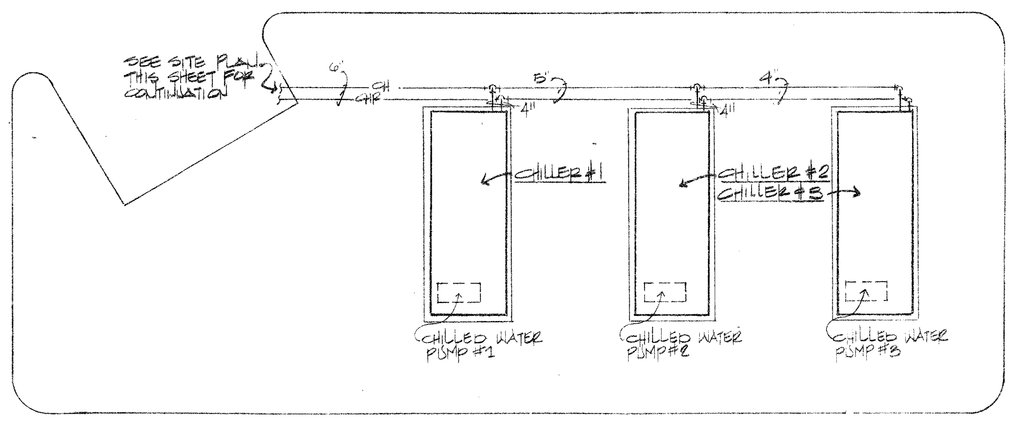

PARTIAL PLAN - MECHANICAL CHILLERS
SCALE: 1/8"=1'-0"

MECHANICAL SYMBOLS LEGEND

ALL SYMBOLS NOT NECESSARILY USED

SYMBOL	DESCRIPTION
CW	COLD WATER
DHW	DOMESTIC HOT WATER
DHWR	DOMESTIC HOT WATER RETURN
HWS	HEATING WATER SUPPLY
HWR	HEATING WATER RETURN
CHWS	CHILLED WATER SUPPLY
CHWR	CHILLED WATER RETURN
CWS	CONDENSER WATER SUPPLY
CWR	CONDENSER WATER RETURN
RL	REFRIGERANT LIQUID
RS	REFRIGERANT SUCTION
D	DRAIN
G	GAS
W	WASTE
V	SANITARY VENT
SD	STORM DRAIN
S	STEAM SUPPLY
GC	GRAVITY CONDENSATE RETURN
PC	PUMPED CONDENSATE RETURN
F	FIRE LINE
A	COMPRESSED AIR
GV	GATE VALVE
CV	CHECK VALVE
BC	BALANCE COCK
ST	STRAINER
U	UNION
TH	THERMOSTAT
TM	THERMOMETER
GC	GAUGE COCK
HB	HOSE BIBB
WH	WALL HYDRANT
BH	BOX HYDRANT
DS	DOWNSPOUT
FD	FLOOR DRAIN
RD	ROOF DRAIN
HD	HUB DRAIN
VTR	VENT THRU ROOF
CO	CLEAN OUT

Called Dale Butts on 3-1-81 Wayne Swahn 748-5261

CITY OF ADDISON APPROVED FOR CONSTRUCTION 1-20-81

Dale Rooty 386-5200

HKS

Harwood K Smith & Partners Inc
Architects Engineers Planners 2900 Southland Center Dallas Texas 75201
Harwood K Smith — George R Richie — Paul M Terrill Jr
Ronald M Brame — John M Barre — Ronald L Skaggs
Jack R Yardley — J Wade Driver Jr — Jack M Nottingham
C Joe Buskuhl Jr

Liberty Corporation - Phase I
United Fidelity Insurance Company Home Office Building
Keller Springs Road Addison, Texas

REVISIONS
PC #1 9 8 80
PC #2 10/15/80
PC #3 12-22-80

DATE 7-8-80

SHEET NUMBER
ME-1

OF 14 SHEETS