



REVISIONS

NO.	DATE	DESCRIPTION

KELLER SPRINGS LOFTS

LOFT APARTMENTS IN ADDISON, TEXAS

CONSTRUCTION ISSUE
10-17-2011







DATE
08-05-2011

PROJECT
11129

SHEET NUMBER

1.1
SITE PLAN/TABULATION

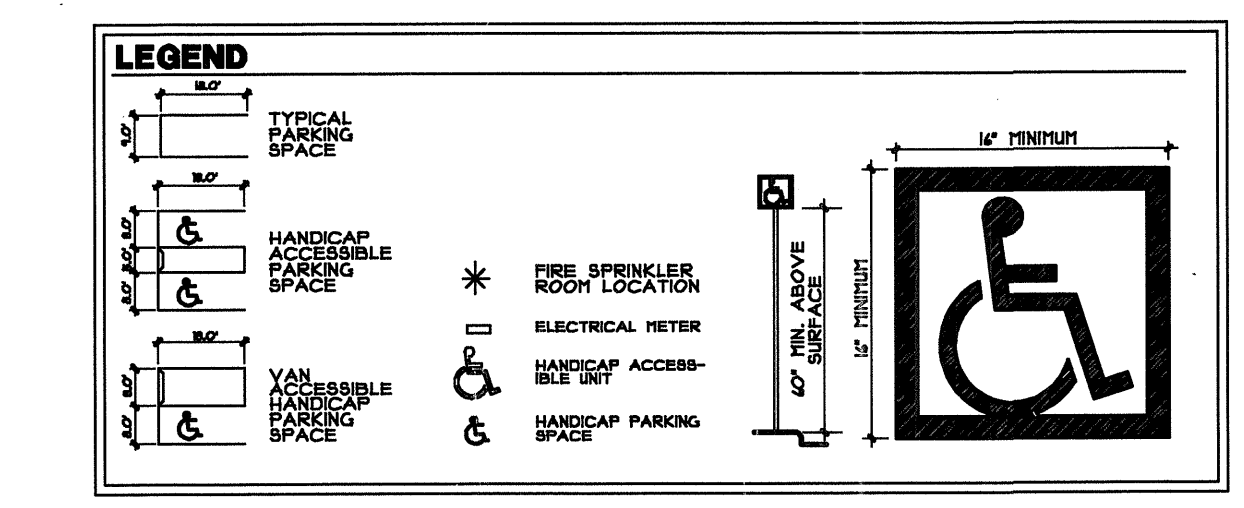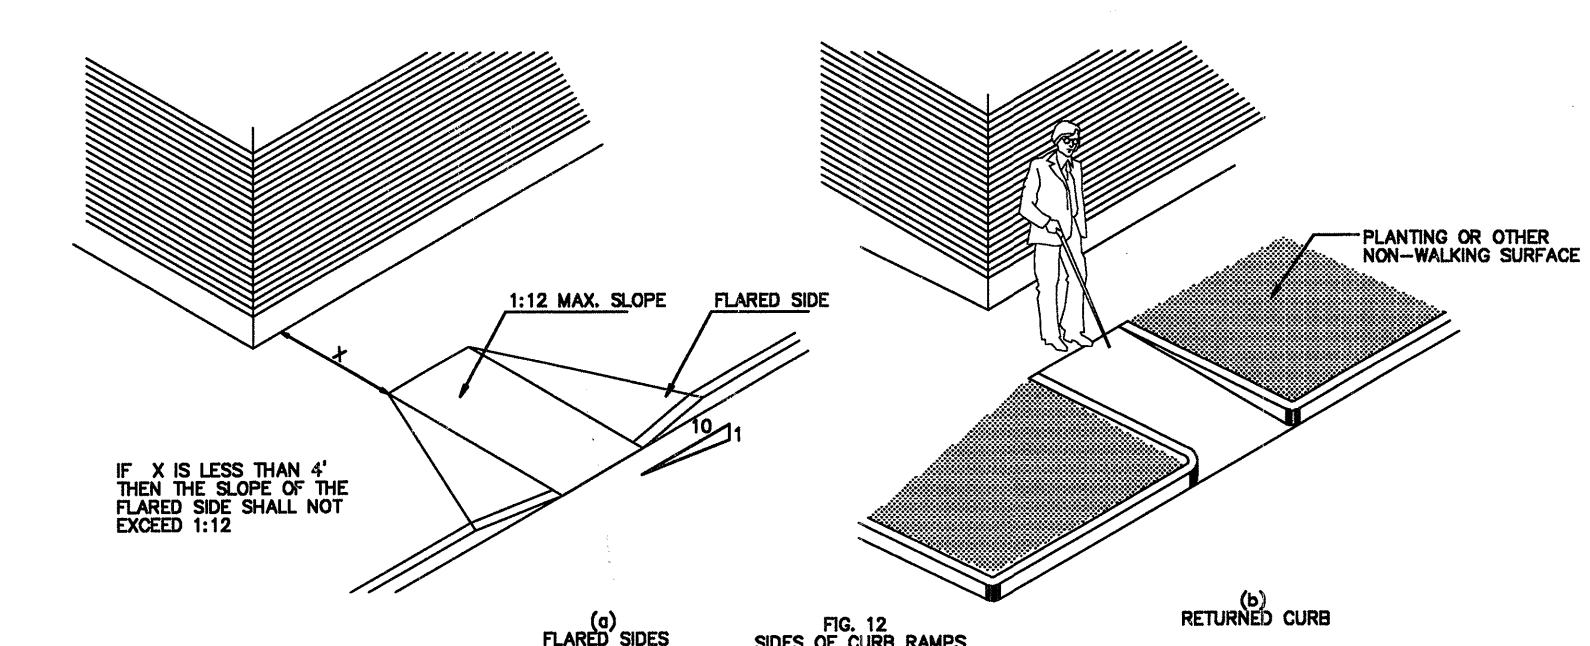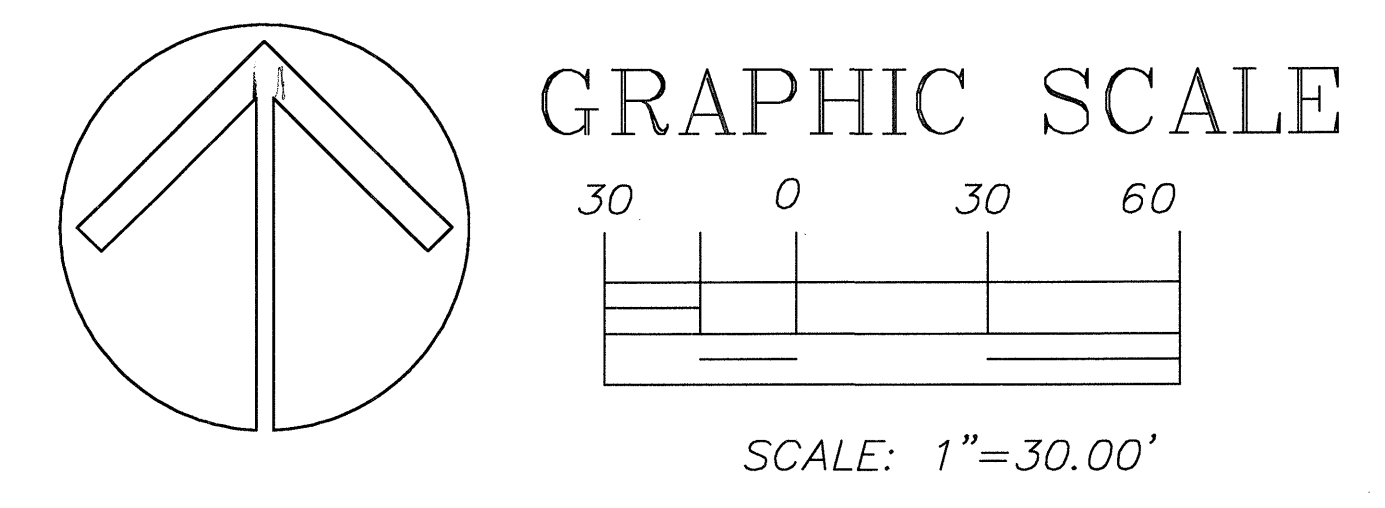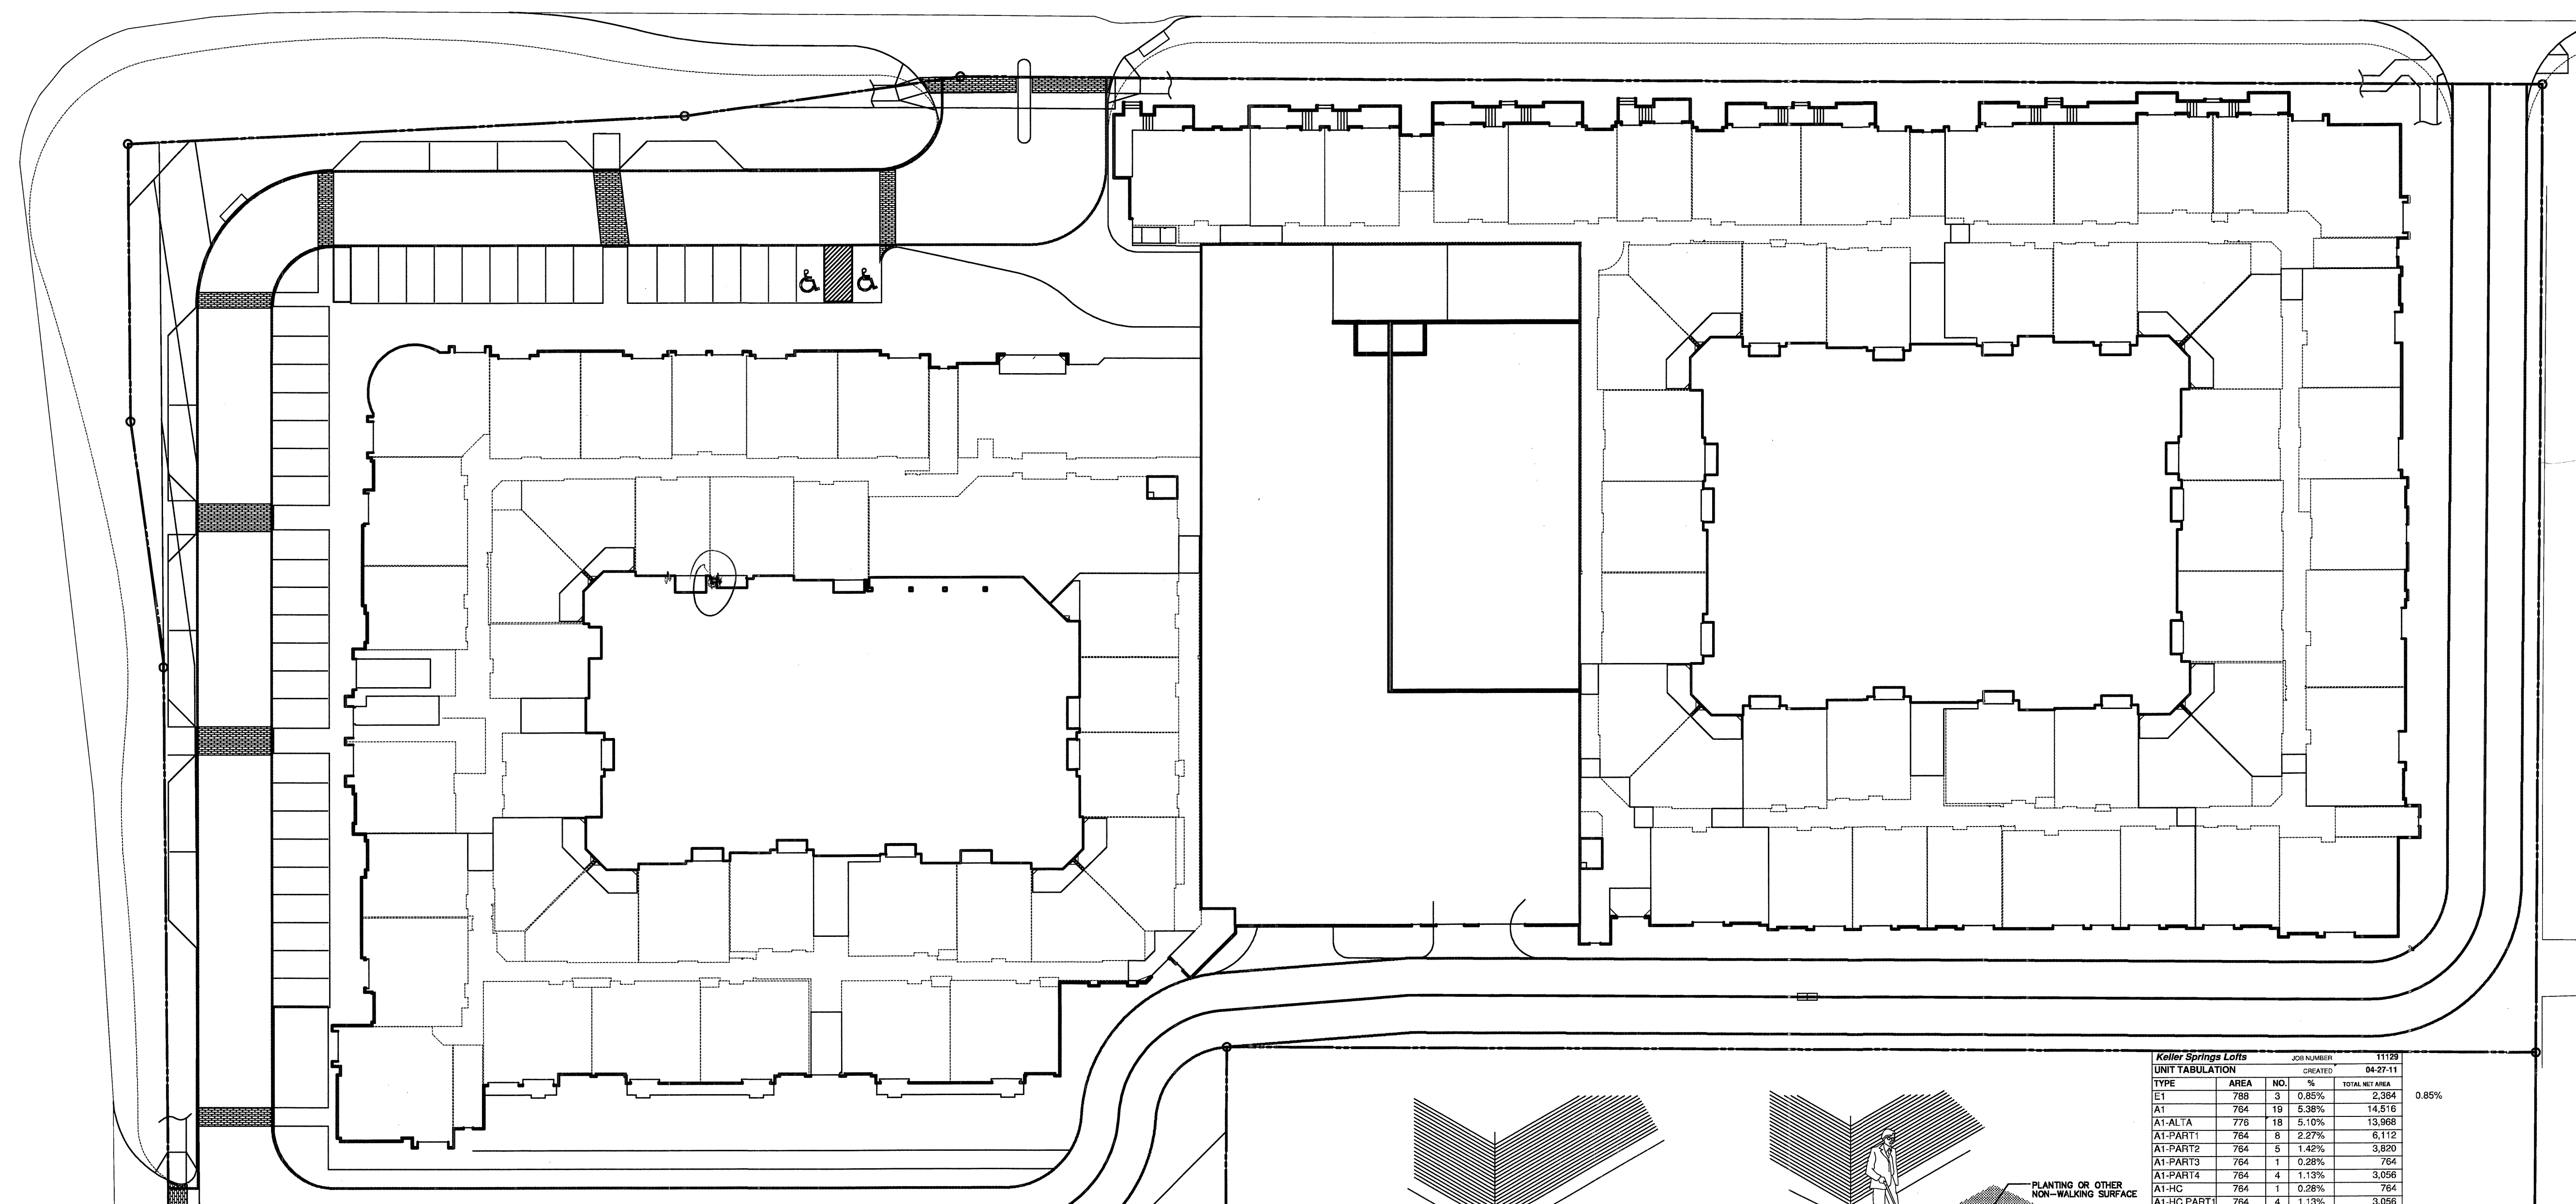

Keller Springs Lofts					JOB NUMBER	11129
UNIT TABULATION					CREATED	04-27-11
TYPE	AREA	NO.	%	TOTAL AREA		
A2	788	59	16.71%	46,492		
A2-PART1	788	3	0.85%	2,384		
A2-PART2	788	3	0.85%	2,384		
A2-SP	951	3	0.85%	2,853		36.26%
A3-AL1	885	4	1.13%	3,540		
A3-AL2	879	4	1.13%	3,516		
A3-AL3	875	3	0.85%	2,825		
A3-AL1D	862	27	7.55%	23,274		
A3-PART1	857	8	2.27%	6,856		
A3-PART2	857	1	0.28%	857		
A3-PART3	857	1	0.28%	857		
A3-ALTE	862	1	0.28%	862		13.66%
A4	887	1	0.28%	887		
A4-AL1A	920	19	5.38%	17,480		
A4-AL1B	951	12	3.40%	11,412		
A4-AL1C	920	3	0.85%	2,760		
A4-ALTE	920	7	1.98%	6,440		
A4-AL1F	902	1	0.28%	902		
A4-AL1G	920	16	4.53%	14,720		16.71%
BT-AL1A	1,093	3	0.85%	3,279		
BT-AL1B	1,093	1	0.28%	1,093		
BT-AL1D	1,098	7	1.98%	7,686		
BT-AL1D1	1,098	3	0.85%	3,294		
BT-AL1E	1,095	8	1.90%	8,760		
BT-AL1F	1,098	2	0.57%	2,196		
BT-AL1G	1,098	2	0.57%	2,196		
BT-AL1H	1,098	4	1.13%	4,392		
BT-AL1J	1,095	12	3.40%	13,140		
BT-AL1K	1,083	9	2.55%	9,807		
BT-AL1L	1,098	3	0.85%	3,294		
BT-PART1	1,081	3	0.85%	3,243		
BT-PART2	1,081	4	1.13%	4,324		16.71%
B2	1,155	3	0.85%	3,465		
B2-AL11	1,200	6	1.70%	7,200		
B2-AL12	1,182	3	0.85%	3,546		
B2-AL13	1,173	3	0.85%	3,519		
B2-AL14	1,173	3	0.85%	3,519		
B2-AL15	1,204	3	0.85%	3,612		
B2-PART1	1,155	3	0.85%	3,465		
B2-PART4	1,155	1	0.28%	1,155		
B2-AL11A	1,174	2	0.57%	2,348		
B2-AL12A	1,174	1	0.28%	1,174		
B2-AL13A	1,167	1	0.28%	1,167		
B2-AL14A	1,167	1	0.28%	1,167		
B2-AL15A	1,191	1	0.28%	1,191		
B2-CAL1	1,197	12	3.40%	14,364		12.18%
B3	1,282	2	1.13%	5,128		
B3-AL1A	1,295	1	1.13%	5,220		
B3-AL1B	1,248	1	0.85%	3,744		
B3-AL1C	1,243	2	0.28%	1,243		3.40%
TOTAL	353	100.00%	329,946		100.00%	114

AVERAGE UNIT SIZE: 934.69

1 SITE PLAN
SCALE: 1"=30.00'

COPYRIGHT © Beeler Guest Owens Architects. ALL RIGHTS RESERVED.