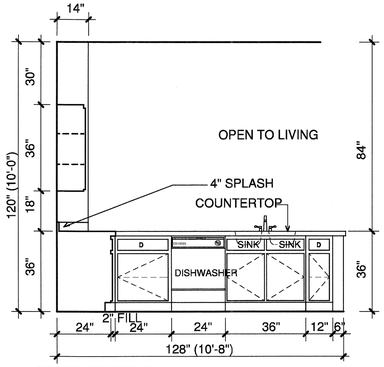

1 KITCHEN
3/8"=1'-0"

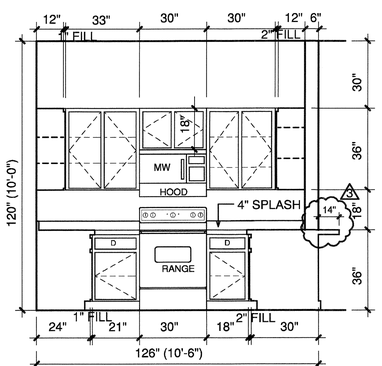

2 KITCHEN
3/8"=1'-0"

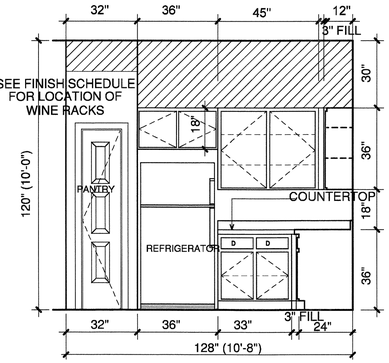

3 KITCHEN
3/8"=1'-0"

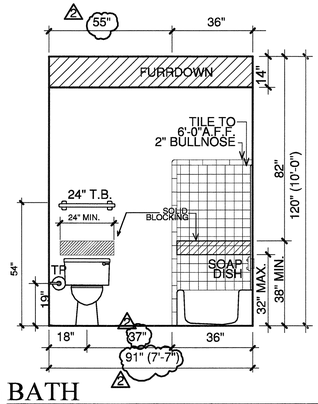

4 BATH
3/8"=1'-0"

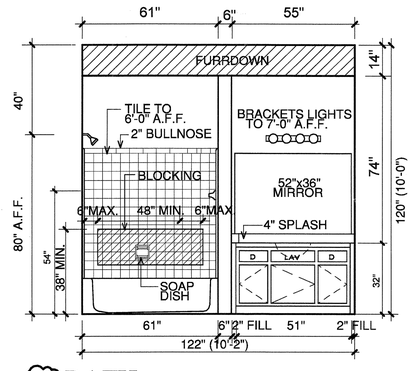

5 BATH
3/8"=1'-0"

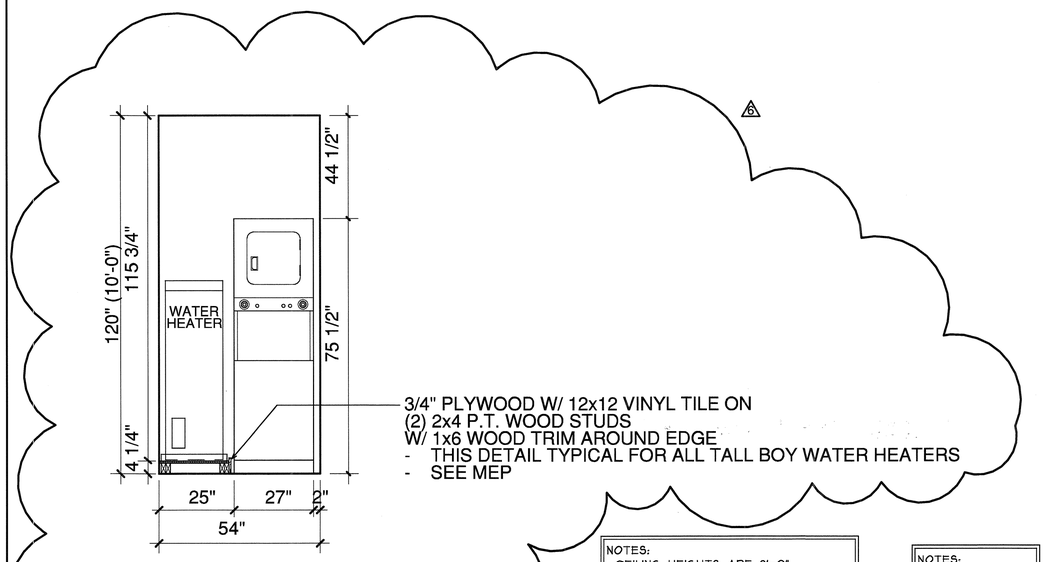

6 UTILITY
1/2"=1'-0"

NOTES:
CEILING HEIGHTS ARE 9'-0" ON THE 2ND, 3RD, AND 4TH FLOORS. REFERENCE SHEET 3.1 FOR VARYING CEILING HEIGHTS AT FIRST FLOOR.

NOTES:
CROSSHATCHING IN PLAN INDICATES AREAS TO BE SUFFICIENTLY BLOCKED FOR GRAB BARS.
14" FURRDOWN
30"X 48" CLEAR FLOOR SPACE

COORDINATE ALL FURRDOWN LOCATIONS WITH MECHANICAL SHOP DRAWINGS

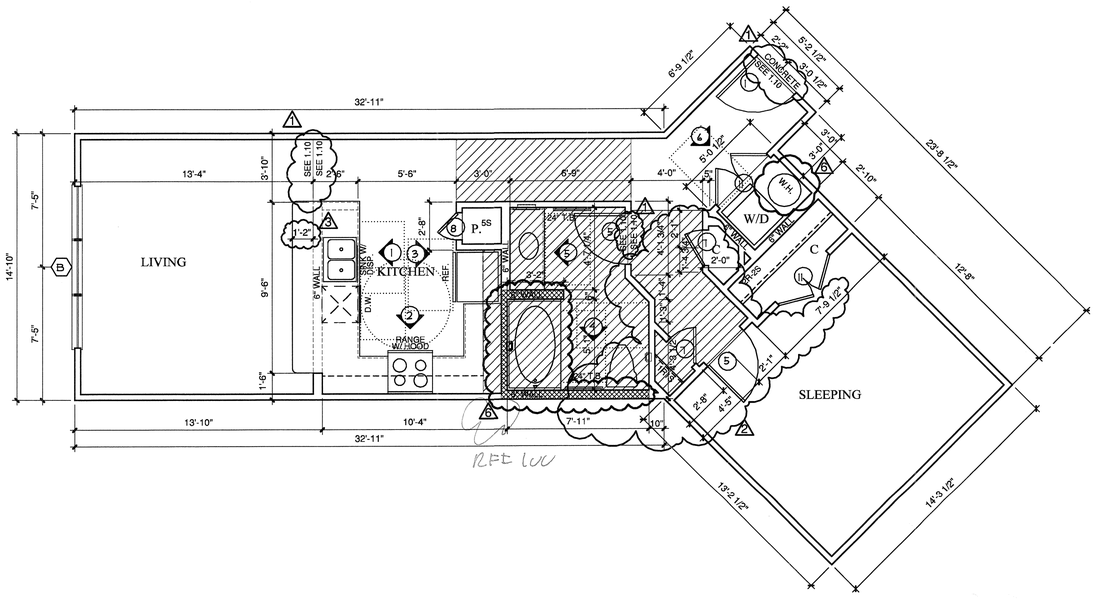

E1 ONE SLEEPING/ONE BATH — 788 S.F.
SCALE 1/4"=1'-0"
OCCURS AT: (3) TOTAL UNITS ON SITE

BGO architects
4144 N. Central Expy.
Suite 855
Dallas, TX 75204
214.520.8878
bgoarchitects.com

REVISIONS
1 OWNER COORDINATION 09- 01- 2011
2 ANSI/FHA COMMENTS 09-13-2011
3 COORDINATION 10-17-2011
4 COORDINATION 04-17-2012

CONSTRUCTION ISSUE
10-17-2011

DATE
08-05-2011

PROJECT
11129

SHEET NUMBER
2.1
E1 UNIT

KELLER SPRINGS LOFTS
LOFT APARTMENTS IN ADDISON, TEXAS

COPYRIGHT © Beeler Guest Owens Architects ALL RIGHTS RESERVED