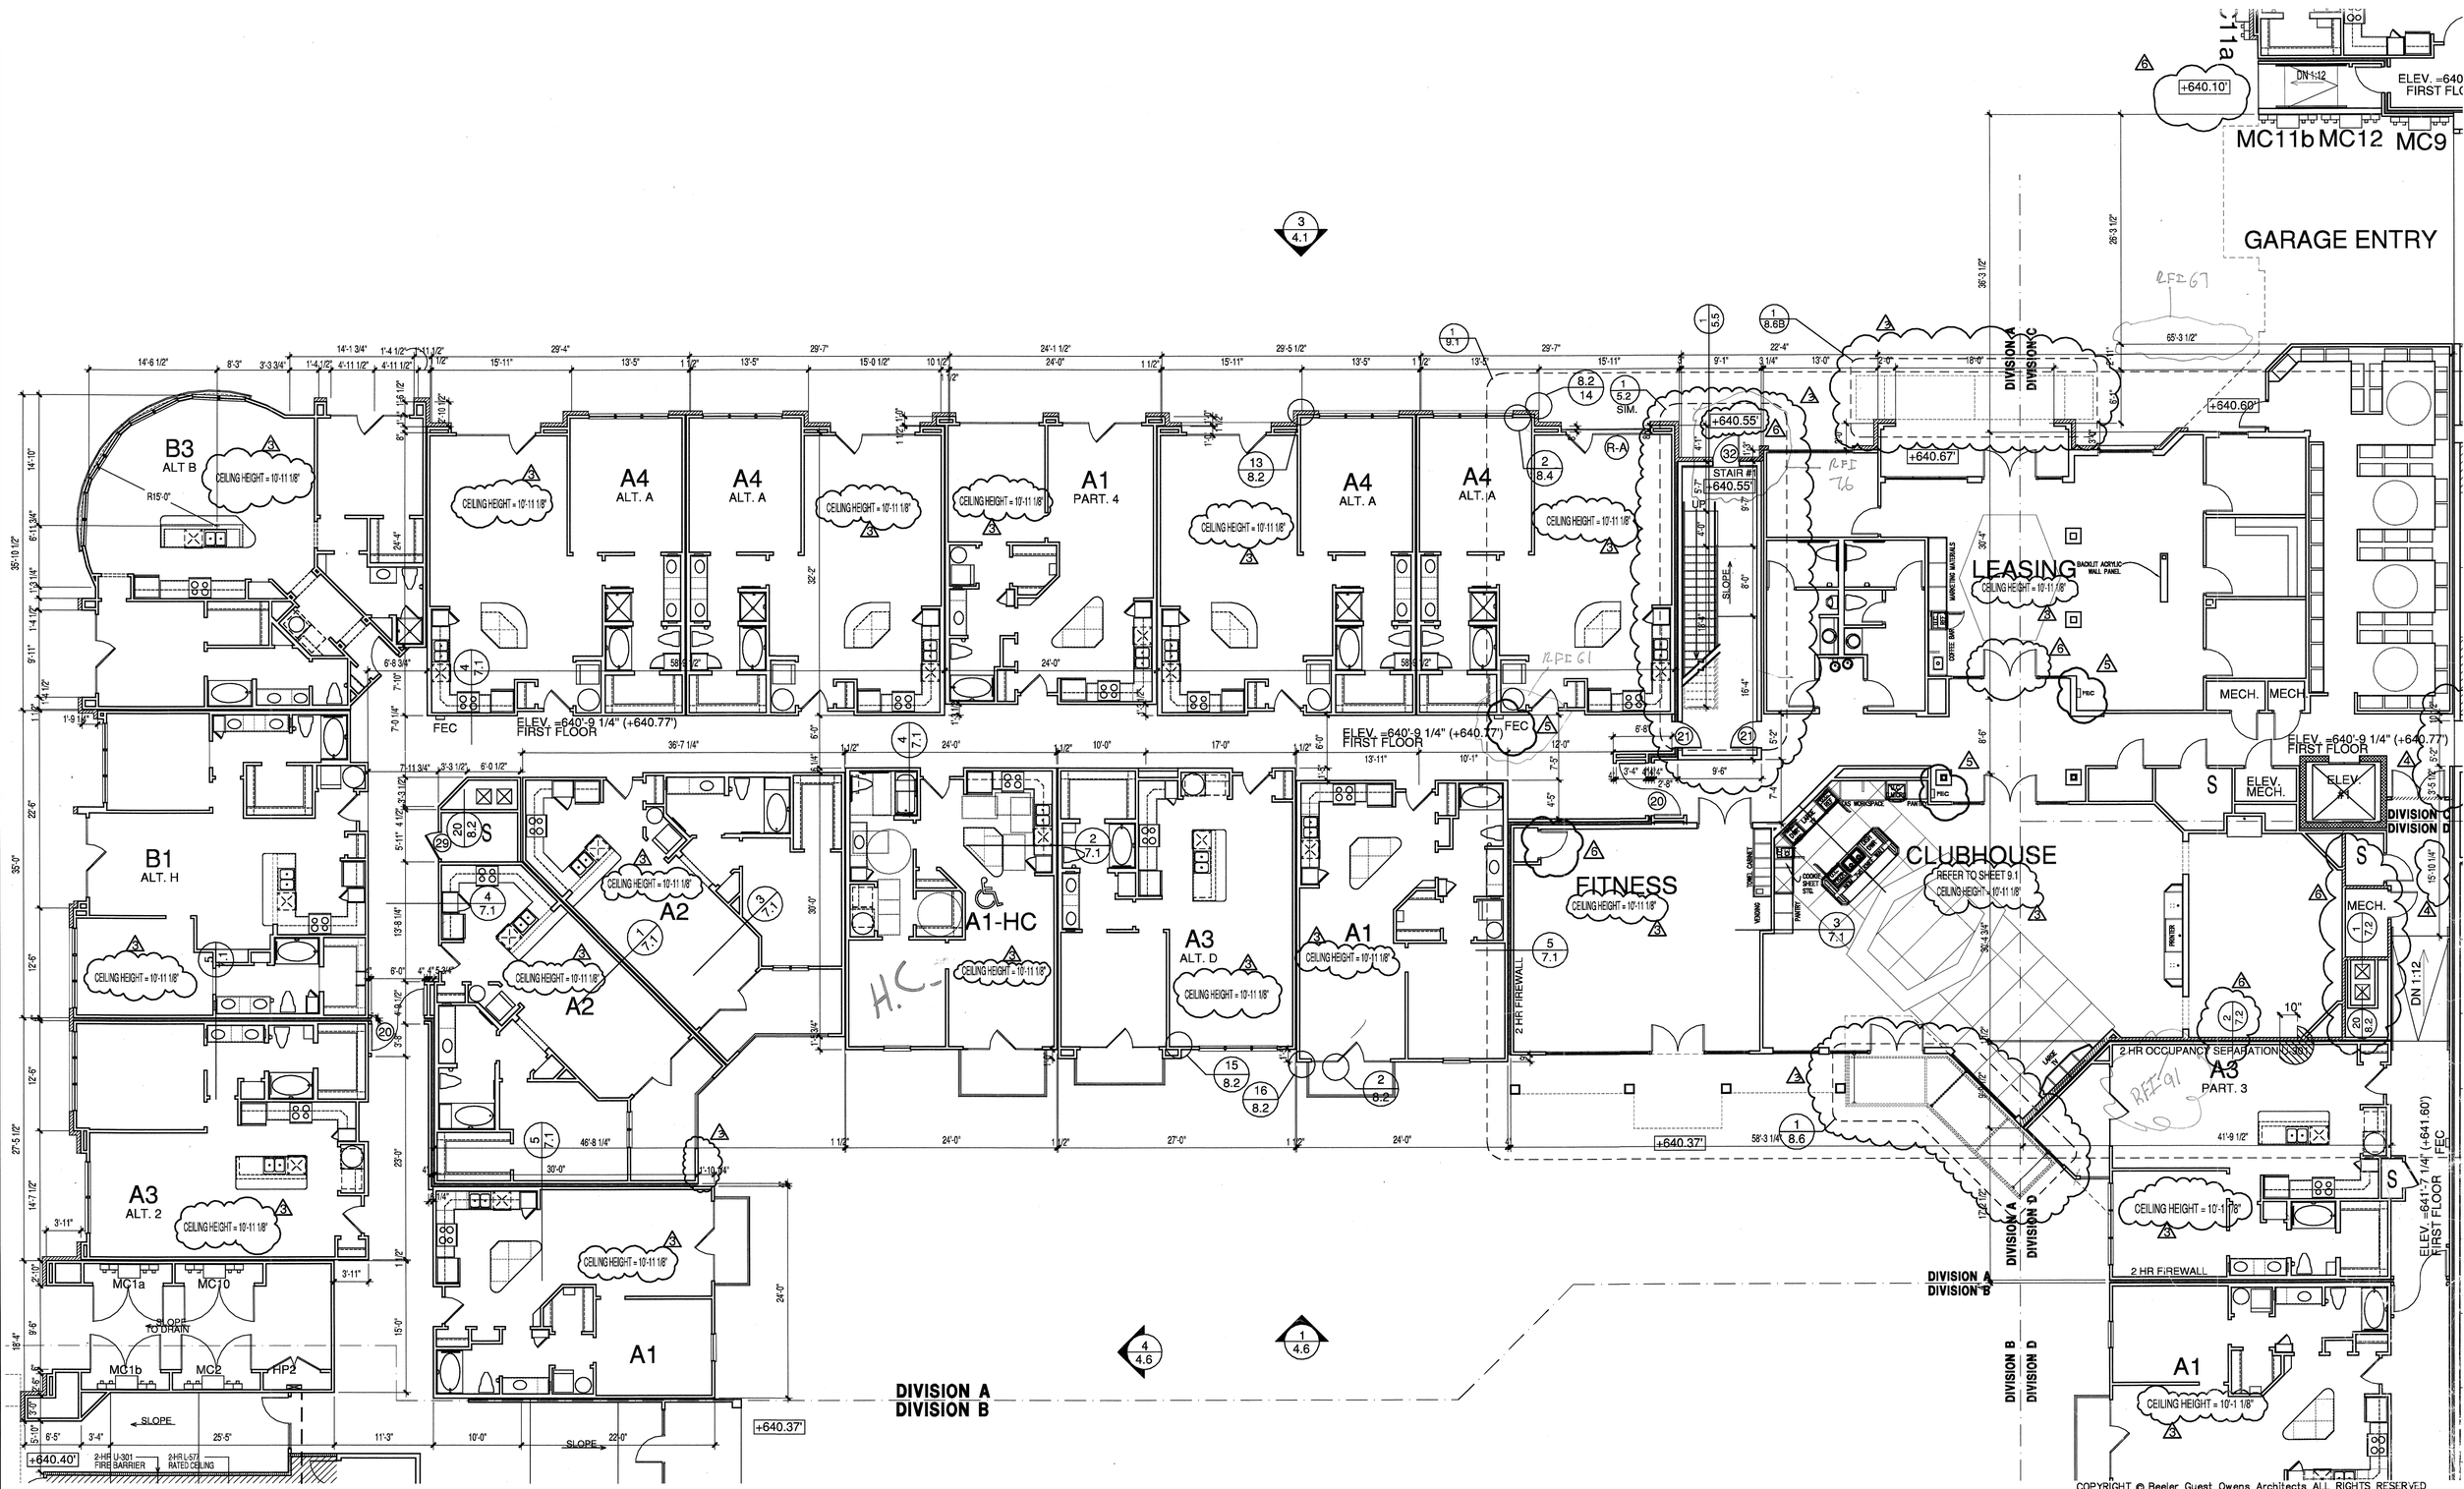

COPYRIGHT © Beeler Guest Owens Architects ALL RIGHTS RESERVED

1 DIVISION 'A' FIRST FLOOR PLAN

1/8"=1'-0"

DIVISION 'A'

BGO architects
4144 N. Central Expy.
Suite 855
Dallas, TX 75204
214.520.8878
bgoarchitects.com

CONSTRUCTION ISSUE
10-17-2011

REVISIONS
1 COORDINATION 10-17-2011
2 GARAGE REVISONS PER SHOP DWGS 01-03-2012
3 COORDINATION 02-29-2012
4 COORDINATION 04-17-2012

KELLER SPRINGS LOFTS

LOFT APARTMENTS IN ADDISON, TEXAS

REGISTERED ARCHITECT — STATE OF TEXAS — 22433 — 01-03-2012

DATE
08-05-2011

PROJECT
11129

SHEET NUMBER
3.1A
BLDG PLAN 'A'