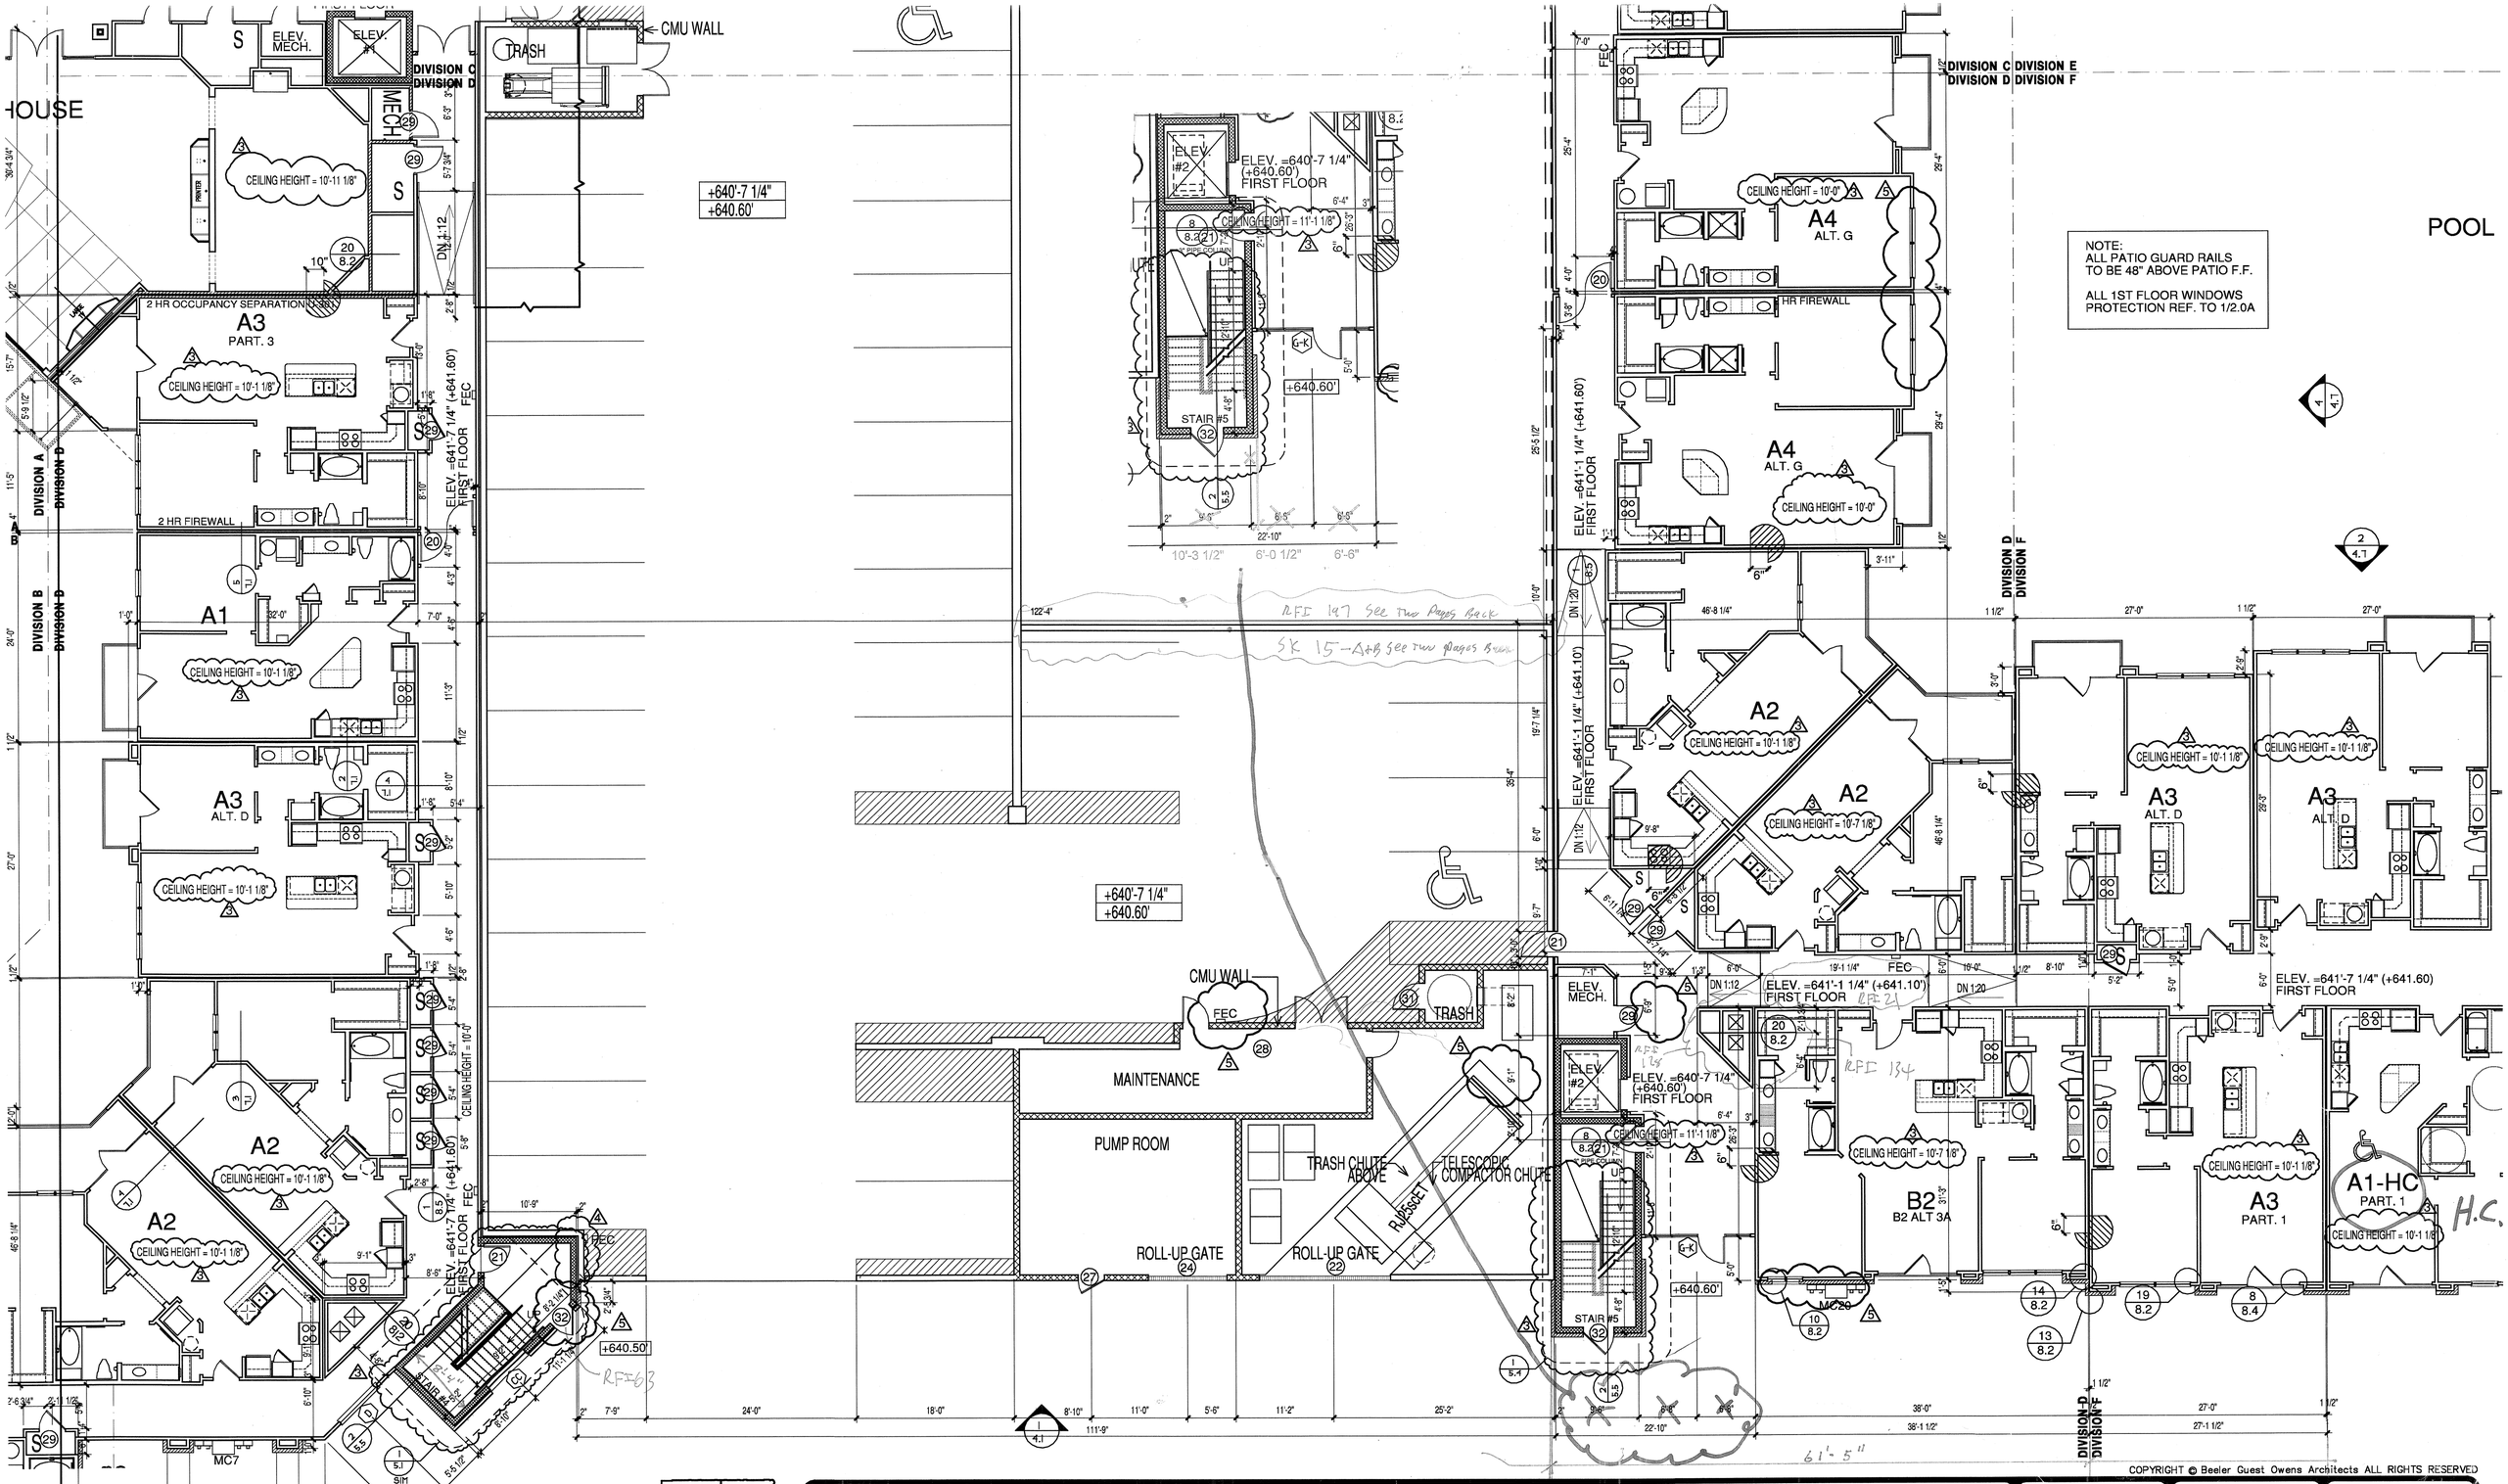

NOTE:
ALL PATIO GUARD RAILS TO BE 48" ABOVE PATIO F.F.

ALL 1ST FLOOR WINDOWS PROTECTION REF. TO 1/2.0A

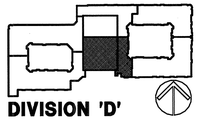

DIVISION 'D'

1 DIVISION 'D' FIRST FLOOR PLAN
1/8"=1'-0"

COPYRIGHT © Beeler Guest Owens Architects ALL RIGHTS RESERVED

BGO architects
4144 N. Central Expy.
Suite 855
Dallas, TX 75204
214.520.8878
bgoarchitects.com

CONSTRUCTION ISSUE
10-17-2011

REVISIONS
3 COORDINATION 10-17-2011
4 GARAGE REVISONS PER SHOP DWGS 01-03-2012
5 COORDINATION 02-29-2012

KELLER SPRINGS LOFTS

LOFT APARTMENTS IN ADDISON, TEXAS

REGISTERED ARCHITECT
STATE OF TEXAS
01-03-2012

DATE 08-05-2011

PROJECT 11129

SHEET NUMBER 3.1D

BLDG PLAN 'D'