


POOL AND AMENITY

NOTE:  
 ALL PATIO GUARD RAILS  
 TO BE 48" ABOVE PATIO F.F.  
 ALL 1ST FLOOR WINDOWS  
 PROTECTION REF. TO 1/2.0A

**1** DIVISION 'F' FIRST FLOOR PLAN  
 1/8"=1'-0"

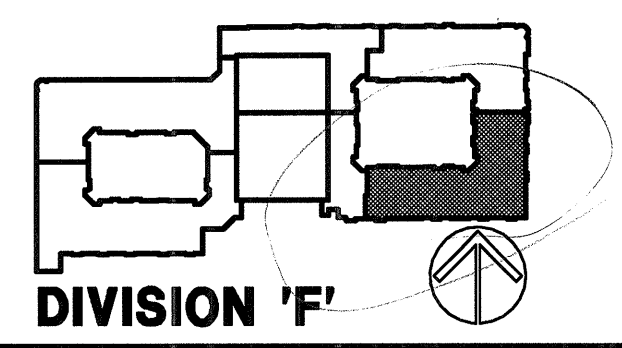

**BGO**  
 architects

4144 N. Central Expy.  
 Suite 855  
 Dallas, TX 75204  
 214.520.8878  
 bgoarchitects.com

CONSTRUCTION ISSUE  
 10-17-2011

REVISIONS

ANSI/FHA COMMENTS	09-13-2011
COORDINATION	10-17-2011

**KELLER SPRINGS LOFTS**

LOFT APARTMENTS IN ADDISON, TEXAS



DATE: 08-05-2011  
 PROJECT: 11129  
 SHEET NUMBER: 3.1F  
 BLDG PLAN 'F'

COPYRIGHT © Beeler Guest Owens Architects ALL RIGHTS RESERVED