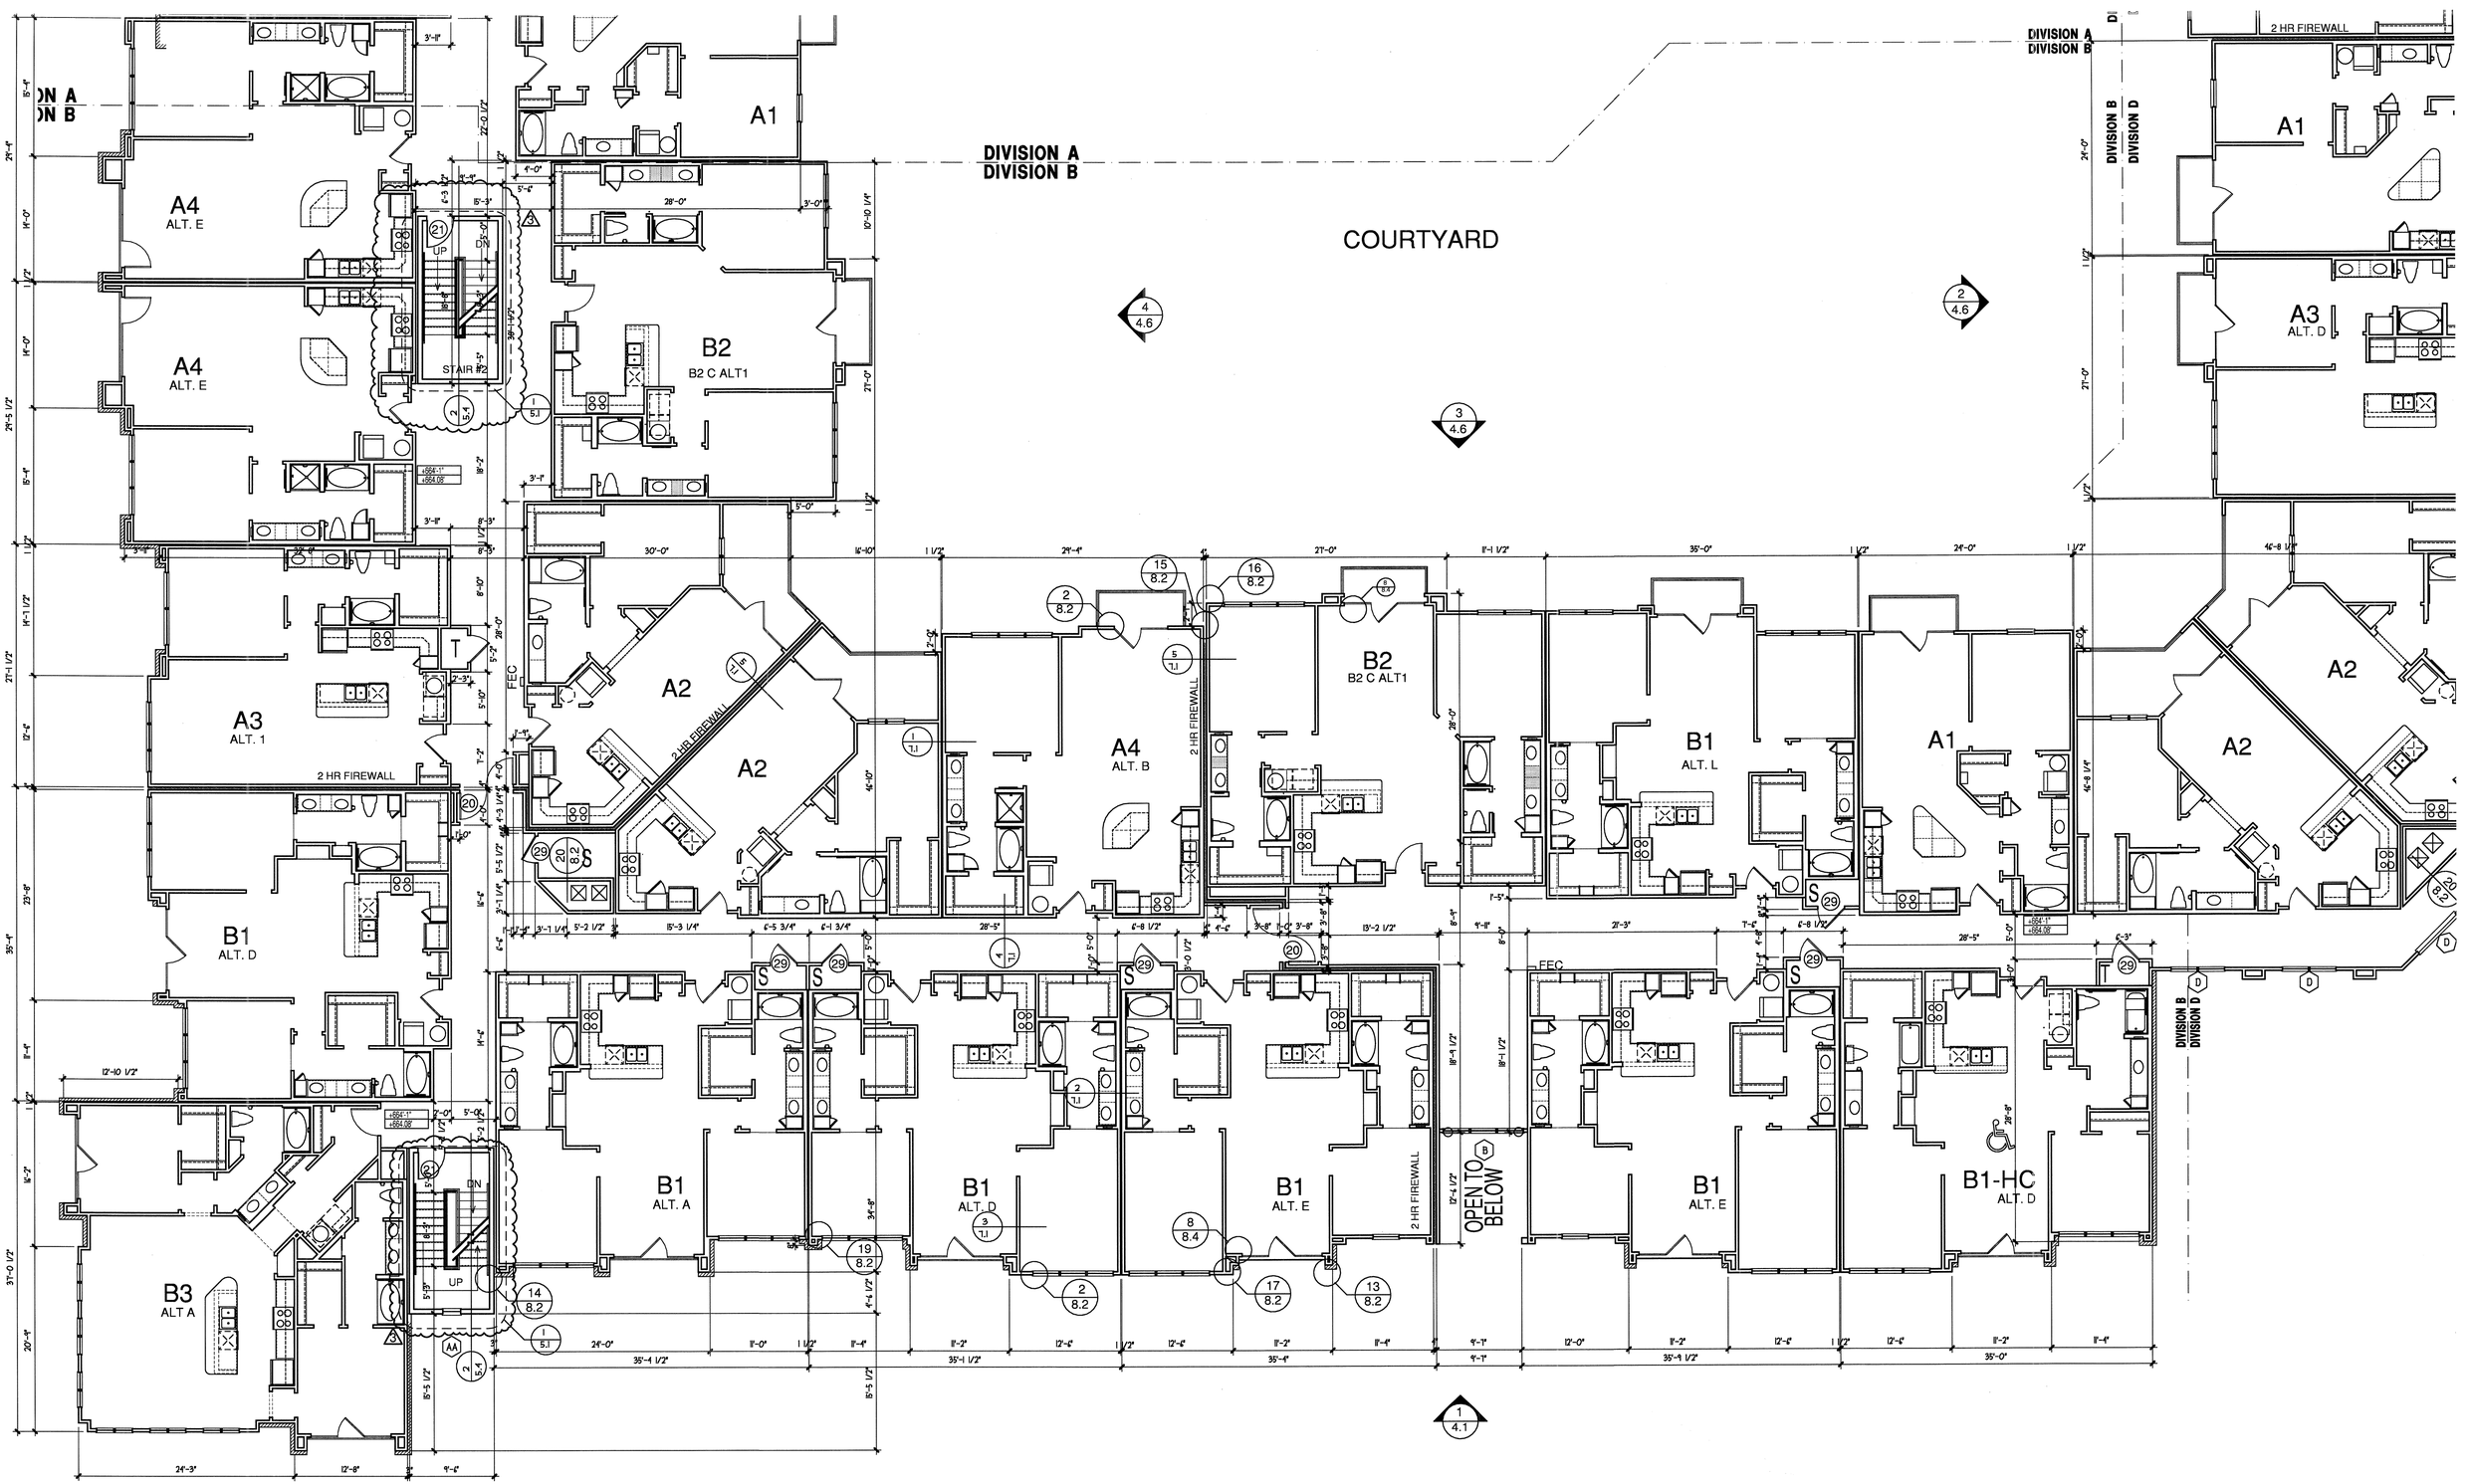

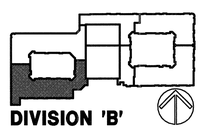

1 DIVISION 'B' THIRD FLOOR PLAN
1/8"=1'-0"

COPYRIGHT © Beeler Guest Owens Architects ALL RIGHTS RESERVED

BGO architects
4144 N. Central Expy.
Suite 855
Dallas, TX 75204
214.520.8878
bgoarchitects.com

CONSTRUCTION ISSUE
10-17-2011

REVISIONS
3 COORDINATION
10-17-2011

KELLER SPRINGS LOFTS

LOFT APARTMENTS IN ADDISON, TEXAS

REGISTERED ARCHITECT
STATE OF TEXAS
22433
10-17-2011

DATE
08-05-2011

PROJECT
11129

SHEET NUMBER
3.3B
BLDG PLAN 'B'