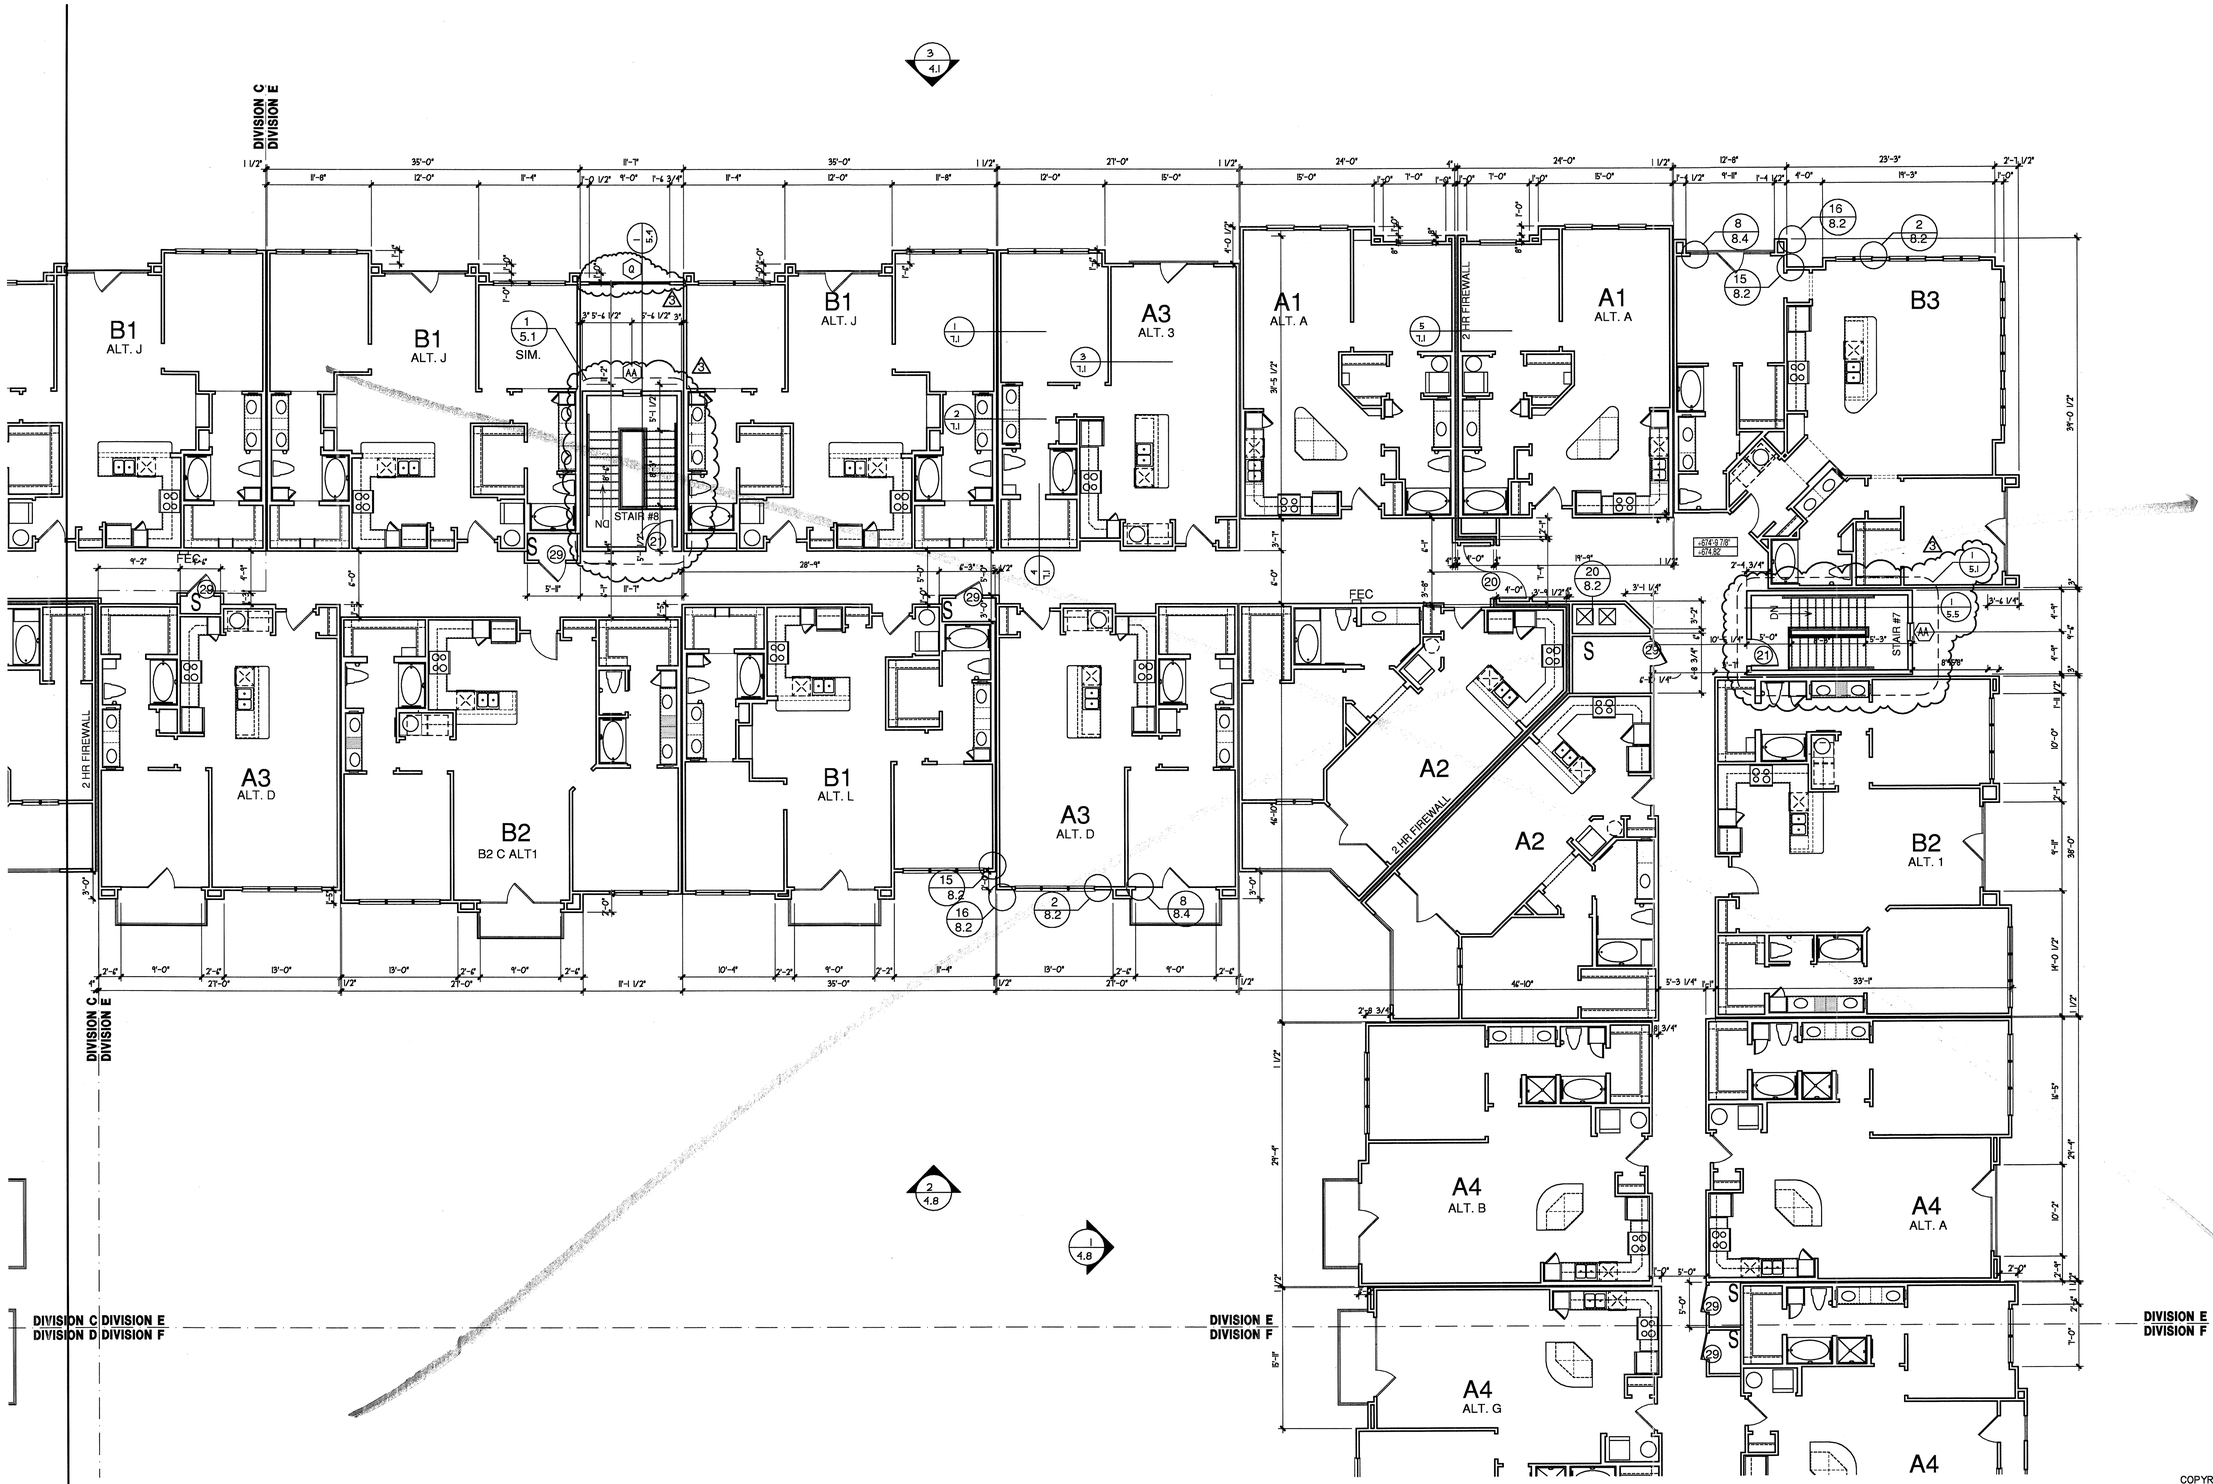

1 DIVISION 'E' FOURTH FLOOR PLAN

1/8"=1'-0"

COPYRIGHT © Beeler Guest Owens Architects ALL RIGHTS RESERVED

BGO architects
4144 N. Central Expy.
Suite 855
Dallas, TX 75204
214.520.8878
bgoarchitects.com

CONSTRUCTION ISSUE
10-17-2011

REVISIONS

KELLER SPRINGS LOFTS

LOFT APARTMENTS IN ADDISON, TEXAS

REGISTERED ARCHITECT
STATE OF TEXAS
22433
10-17-2011

DATE
08-05-2011

PROJECT
11129

SHEET NUMBER
3.4E

BLDG PLAN 'E'