


ROOF LEGEND:


- [Hatched Box] ROOF AREA NOT TO HAVE PENETRATIONS
- [Square with X] LOW INTAKE ATTIC VENT
- [Square with Circle] EXHAUST ATTIC VENT
- [Line with Arrow] DRAFTSTOP

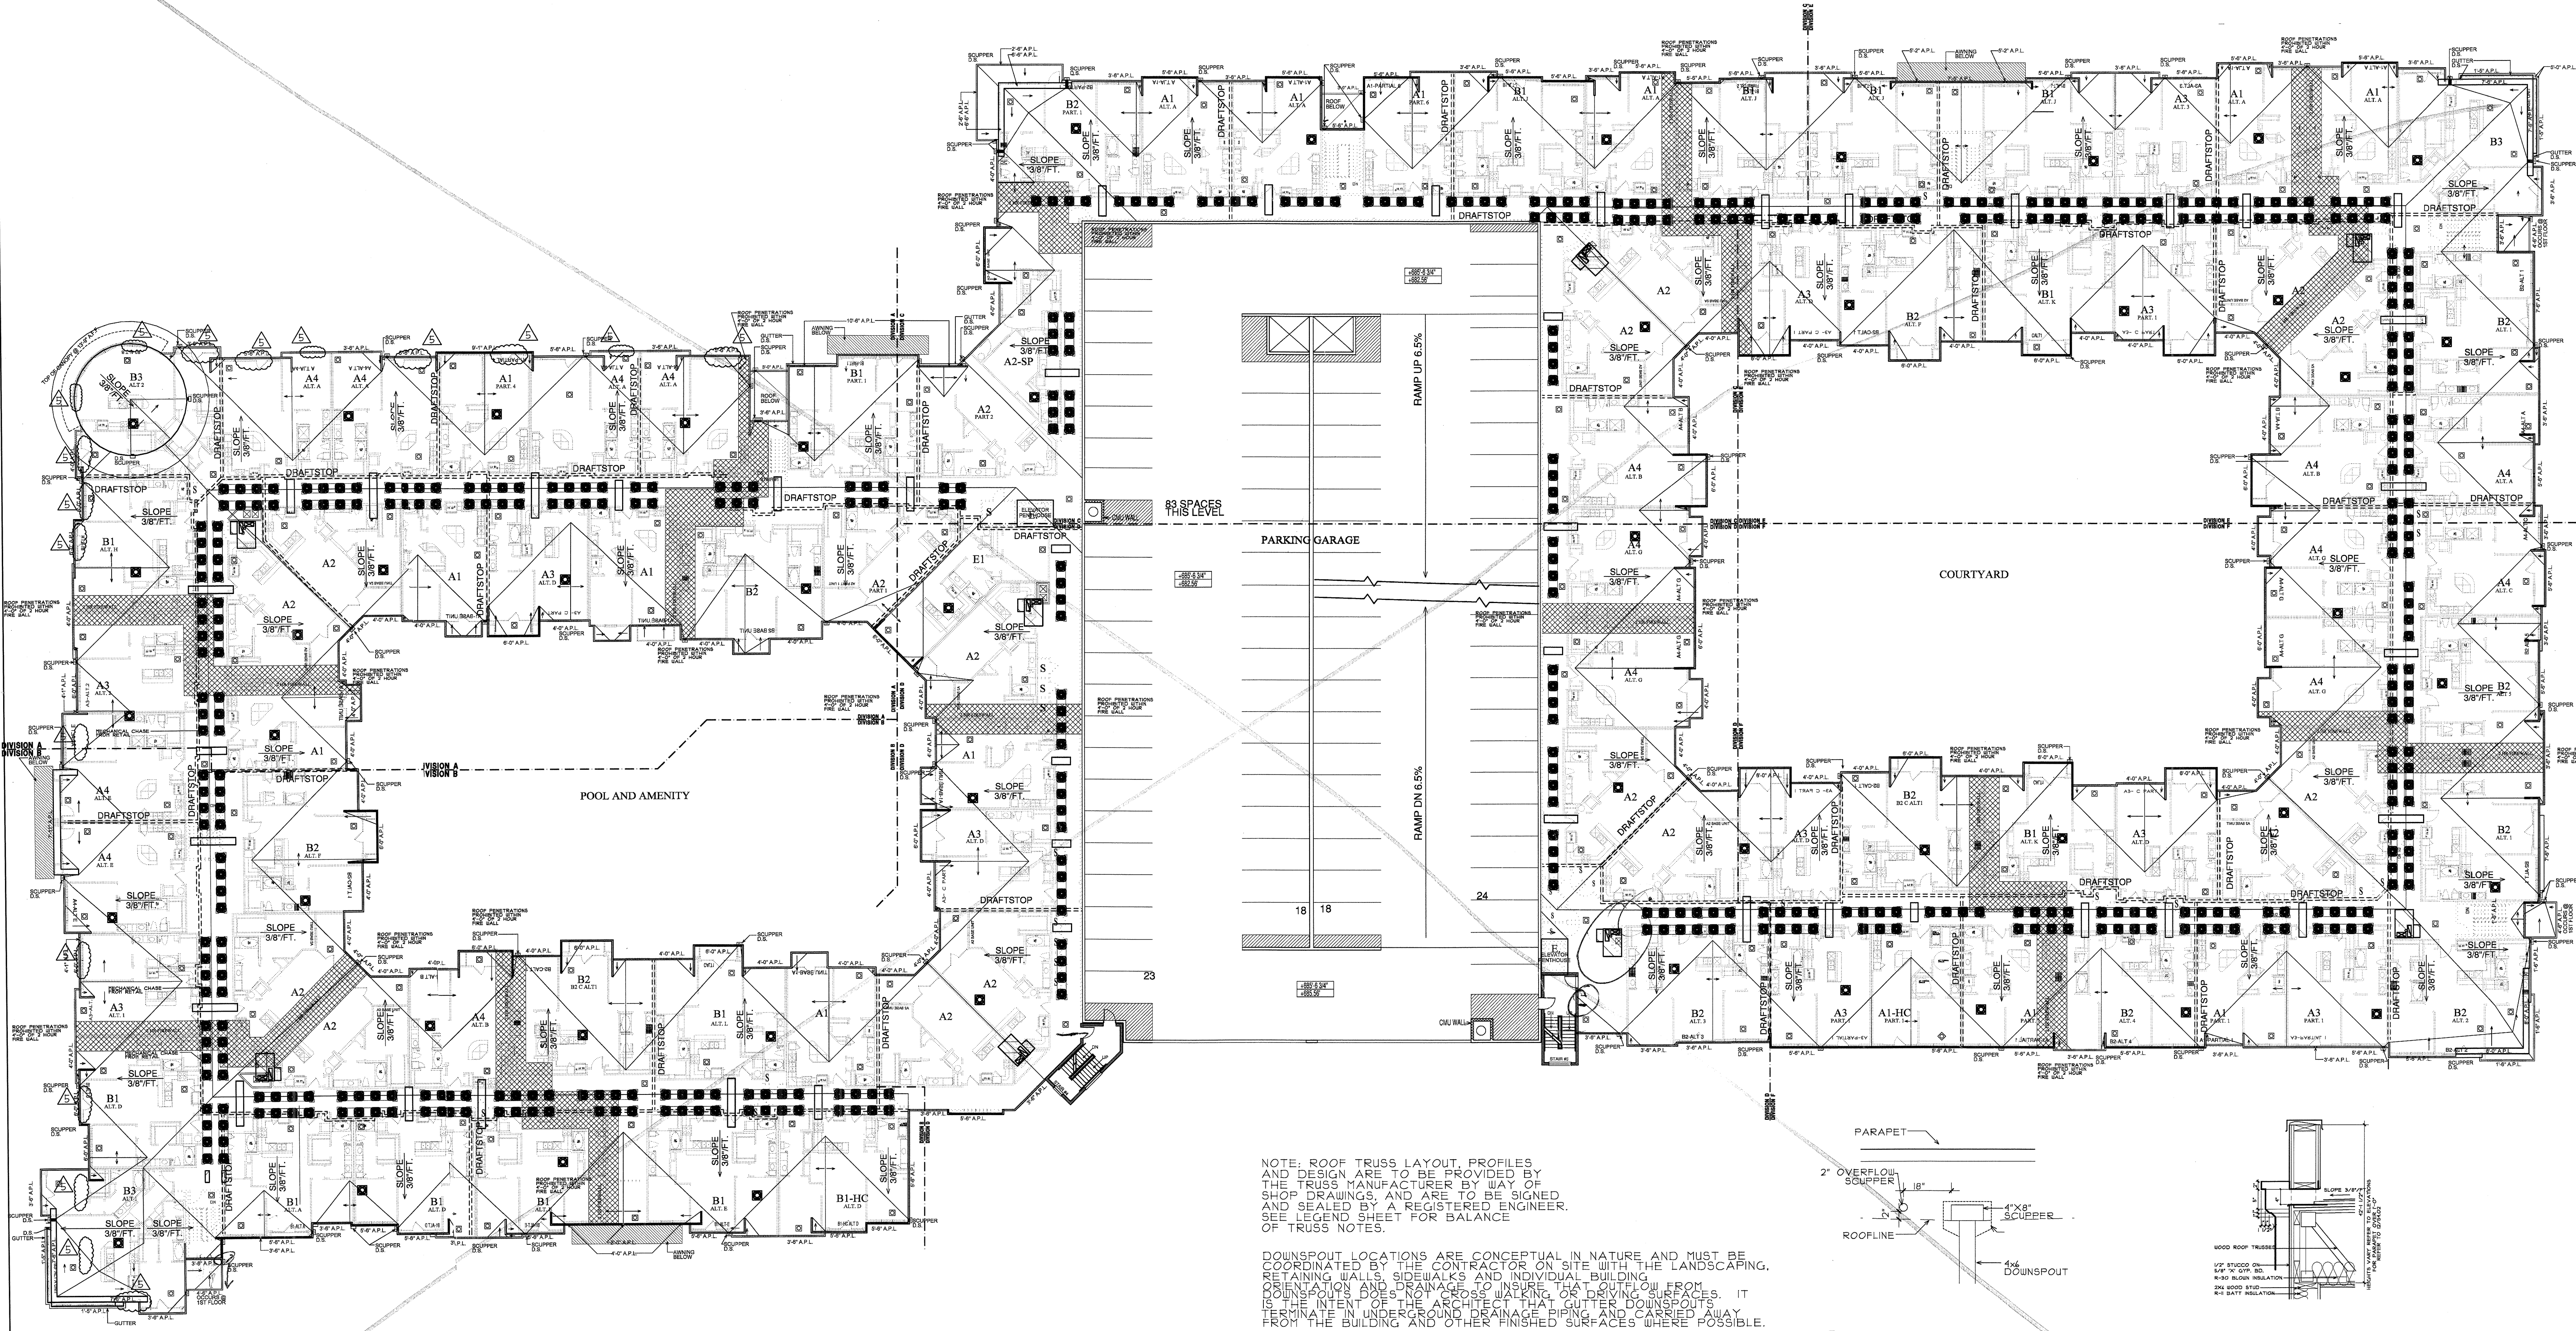

NOTE: ROOF TRUSS LAYOUT, PROFILES AND DESIGN ARE TO BE PROVIDED BY THE TRUSS MANUFACTURER BY WAY OF SHOP DRAWINGS, AND ARE TO BE SIGNED AND SEALED BY A REGISTERED ENGINEER. SEE LEGEND SHEET FOR BALANCE OF TRUSS NOTES.

DOWNSPOUT LOCATIONS ARE CONCEPTUAL IN NATURE AND MUST BE COORDINATED BY THE CONTRACTOR ON SITE WITH THE LANDSCAPING, RETAINING WALLS, SIDEWALKS AND INDIVIDUAL BUILDING ORIENTATION AND DRAINAGE TO INSURE THE OUTFLOW FROM DOWNSPOUTS DOES NOT CROSS WALKING OR DRIVING SURFACES. IT IS THE INTENT OF THE ARCHITECT THAT GUTTER DOWNSPOUTS TERMINATE IN UNDERGROUND DRAINAGE PIPING AND CARRIED AWAY FROM THE BUILDING AND OTHER FINISHED SURFACES WHERE POSSIBLE.

DOWN SPOUTS IN COURTYARD ARE TO BE HARD PIPED INTO THE STORM DRAIN - REFER TO LANDSCAPE PLANS FOR LOCATIONS

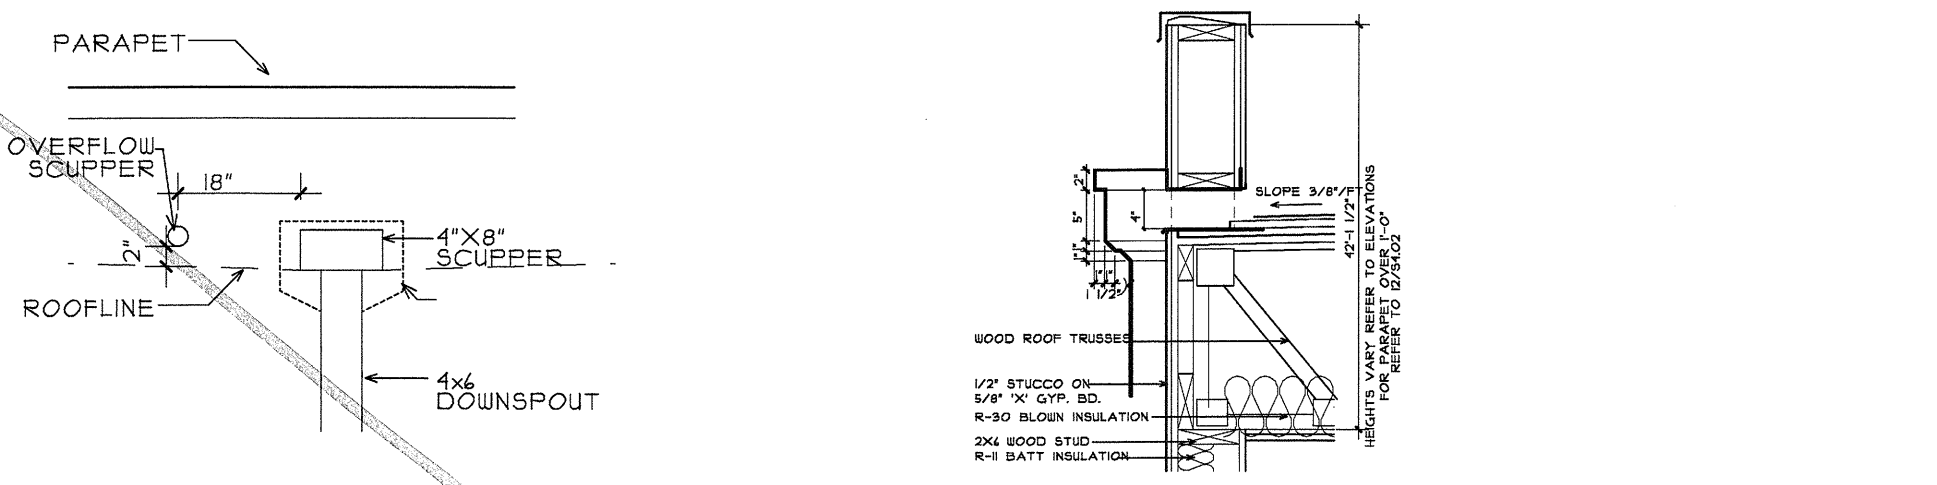

1 ROOF PLAN / GARAGE PLAN 5
SCALE: 1:20

2 SCUPPER ELEVATION
N.T.S.

3 SCUPPER SECTION DETAIL
N.T.S.

COPYRIGHT © Beeler Guest Owens Architects ALL RIGHTS RESERVED

BGO
architects
4144 N. Central Exp.
Suite 855
Dallas, TX 75204
214.520.8878
bgoarchitects.com

CONSTRUCTION ISSUE
10-17-2011

REVISIONS

COORDINATION	10-17-2011
GARAGE REVISIONS PER SHOP DWGS	01-03-2012

KELLER SPRINGS LOFTS
LOFT APARTMENTS IN ADDISON, TEXAS

REGISTERED ARCHITECT
BGO
22433
STATE OF TEXAS

DATE	08-05-2011
PROJECT	11129

SHEET NUMBER	3.5
--------------	------------