


ROOF LEGEND:



- [Symbol] ROOF AREA NOT TO HAVE ROOF FINISHING
- [Symbol] LOW INTAKE ATTIC VENT
- [Symbol] EXHAUST ATTIC VENT
- [Symbol] DRAFT STOP

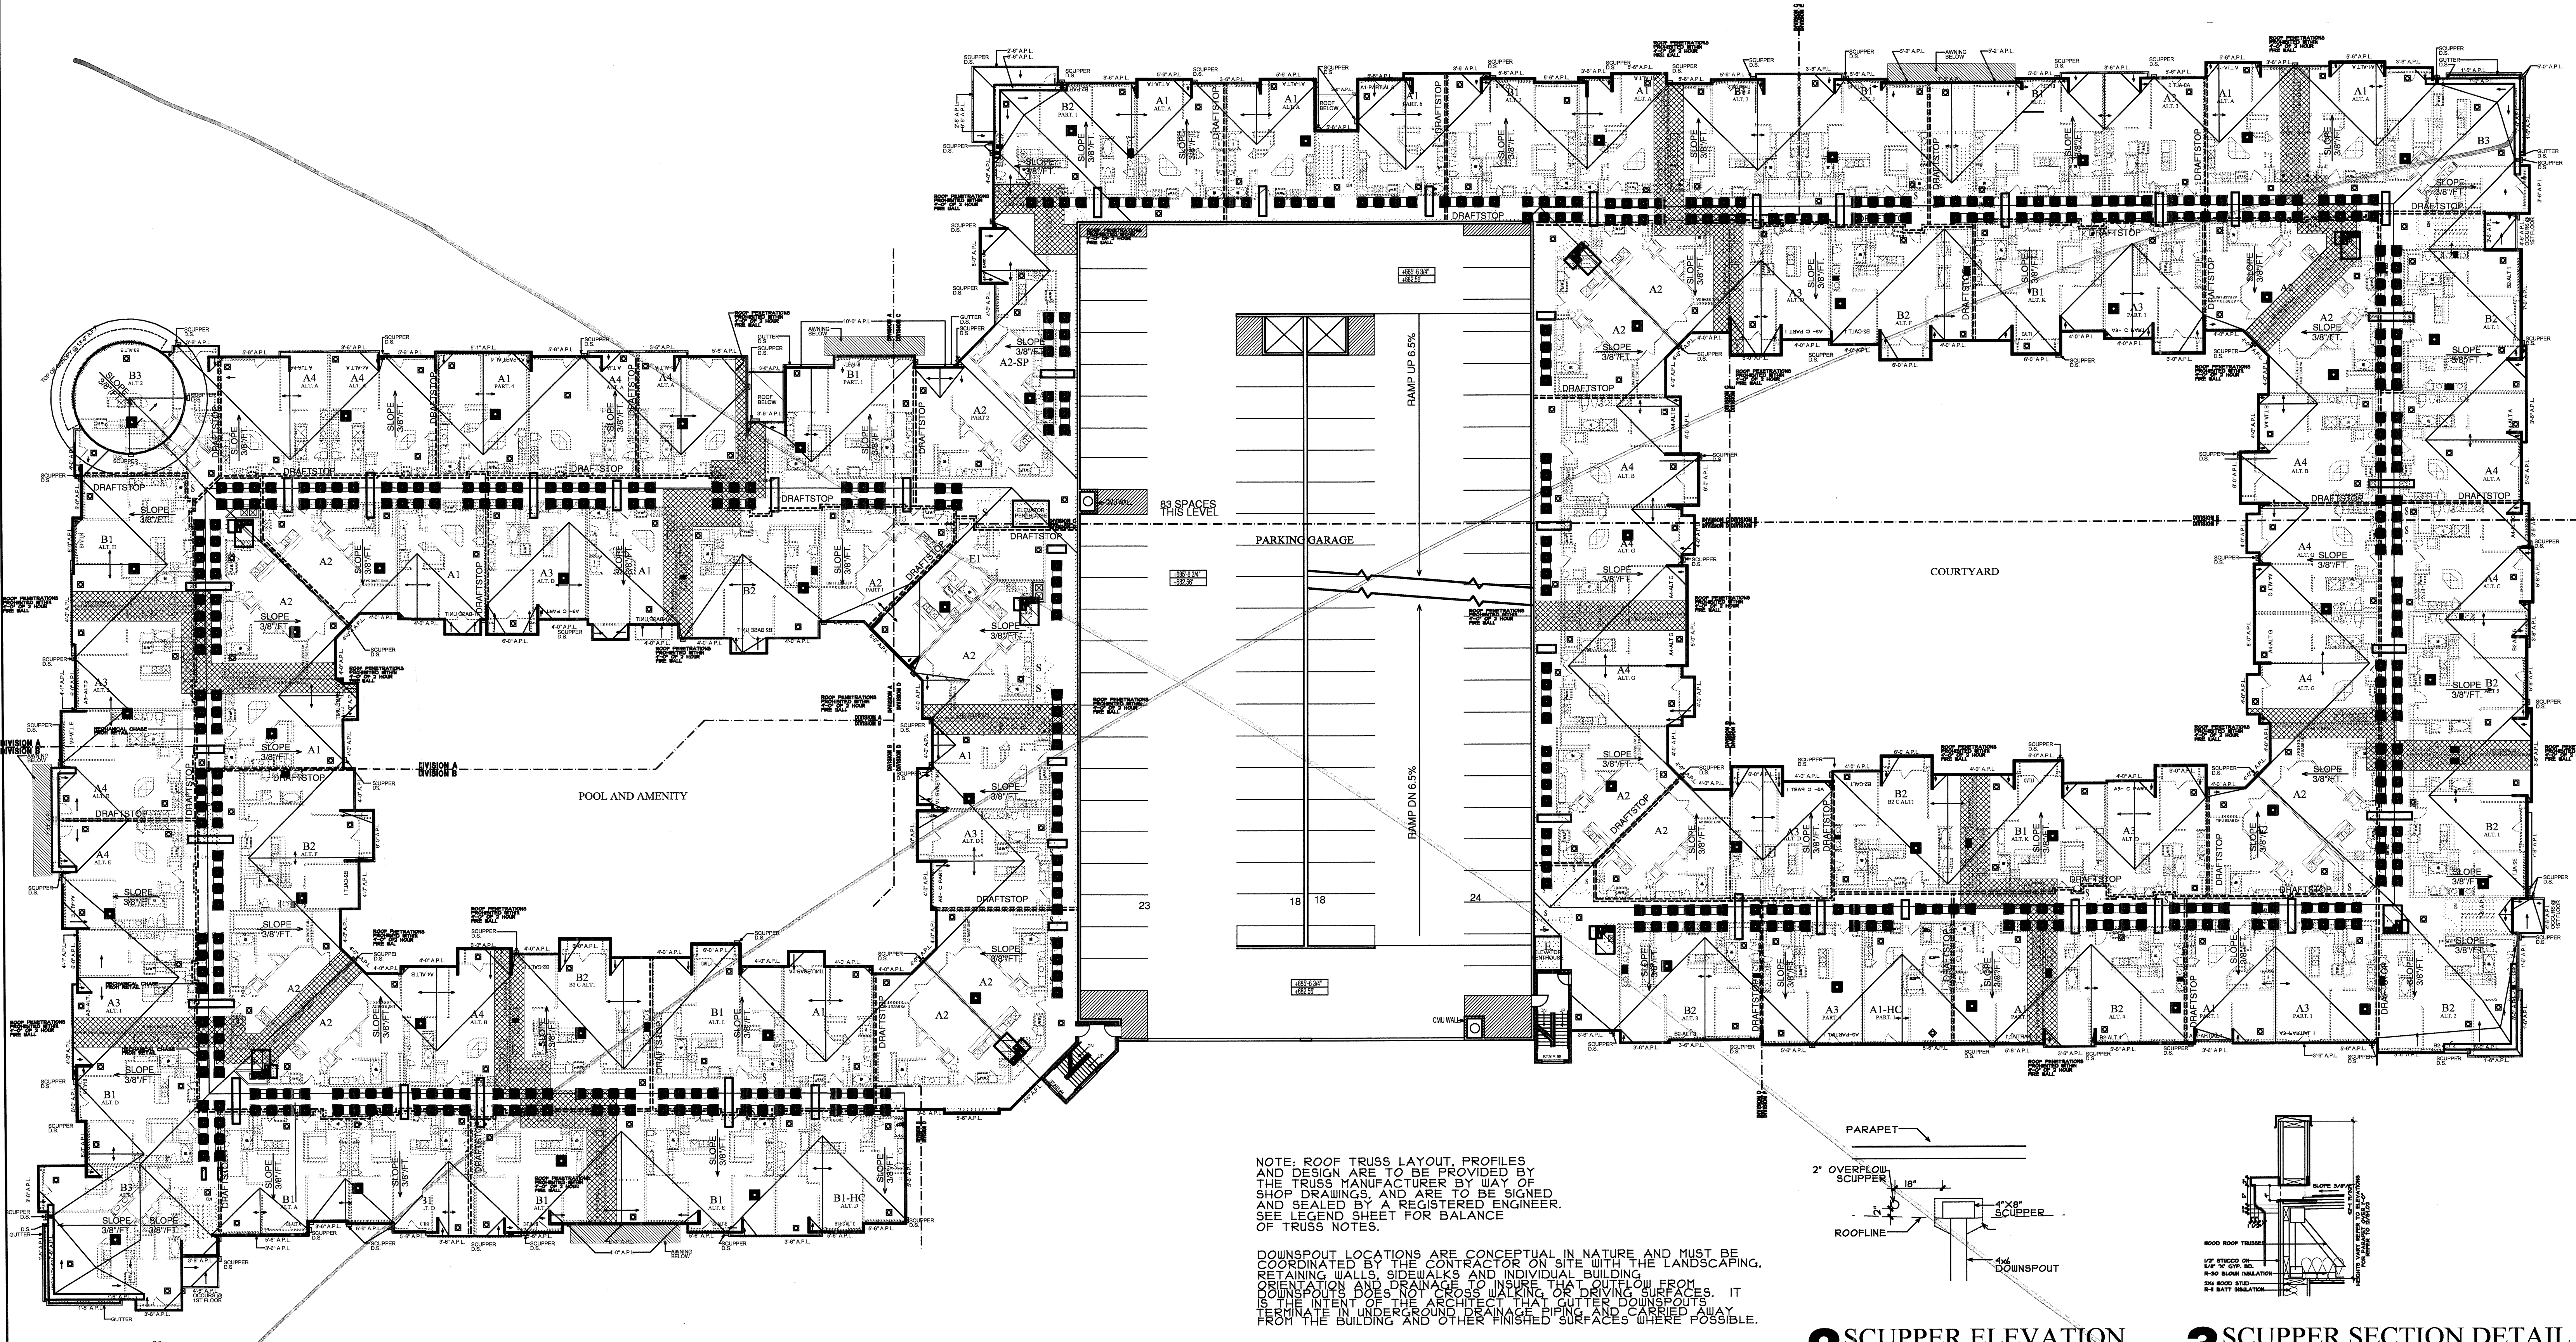

NOTE: ROOF TRUSS LAYOUT, PROFILES AND DESIGN ARE TO BE PROVIDED BY THE TRUSS MANUFACTURER BY WAY OF SHOP DRAWINGS, AND ARE TO BE SIGNED AND SEALED BY A REGISTERED ENGINEER. SEE LEGEND SHEET FOR BALANCE OF TRUSS NOTES.

DOWNSPOUT LOCATIONS ARE CONCEPTUAL IN NATURE AND MUST BE COORDINATED BY THE CONTRACTOR ON SITE WITH THE LANDSCAPING, RETAINING WALLS, SIDEWALKS AND INDIVIDUAL BUILDING ORIGIN AND RAINAGE TO INSURE THAT OUTFLOW FROM DOWNSPOUTS DOES NOT CROSS WALKING OR DRIVING SURFACES. IT IS THE INTENT OF THE ARCHITECT THAT GUTTERS AND DOWNSPOUTS TERMINATE IN UNDERGROUND DRAINAGE PIPING AND CARRIED AWAY FROM THE BUILDING AND OTHER FINISHED SURFACES WHERE POSSIBLE.

DOWNSPOUTS IN COURTYARD ARE TO BE HARD PIPED INTO THE STORM DRAIN - REFER TO LANDSCAPE PLANS FOR LOCATIONS

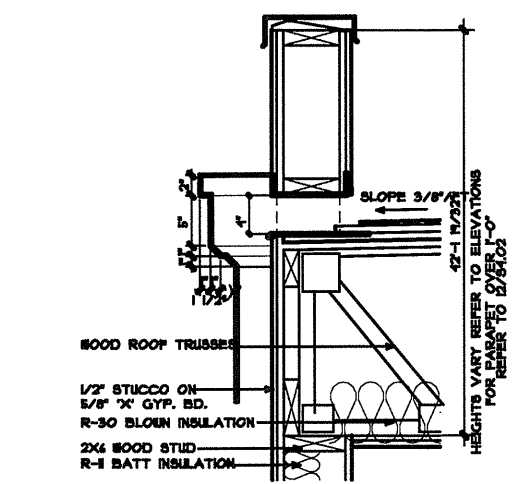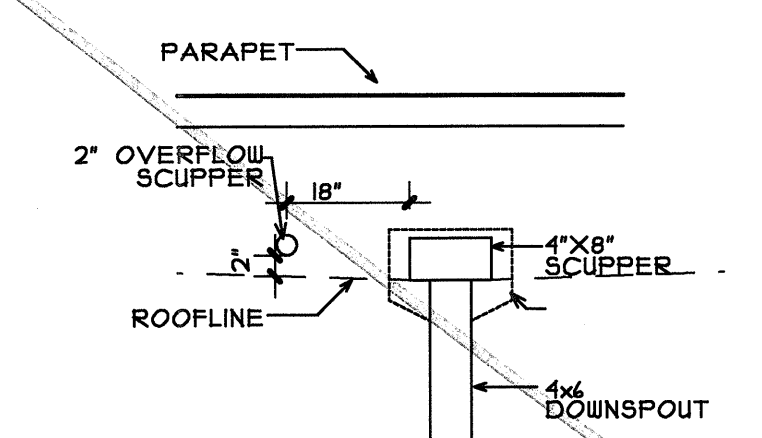

1 ROOF PLAN / GARAGE PLAN 5
SCALE: 1:20

2 SCUPPER ELEVATION
N.T.S.

3 SCUPPER SECTION DETAIL
N.T.S.

COPYRIGHT © Beeler Guest Owens Architects ALL RIGHTS RESERVED

<p>4144 N. Central Expy. Suite B55 Dallas, TX 75204 214.520.8878 bgoarchitects.com</p>	<p>CONSTRUCTION ISSUE 10-17-2011</p>	<p>REVISIONS</p>	<p>KELLER SPRINGS LOFTS</p> <p>LOFT APARTMENTS IN ADDISON, TEXAS</p>			<p>DATE 08-05-2011</p>	<p>SHEET NUMBER 3.5</p>
			<p>10-17-2011</p>	<p>PROJECT 11129</p>			