


NOTE: ROOF TRUSS LAYOUT, PROFILES AND DESIGN ARE TO BE PROVIDED BY THE TRUSS MANUFACTURER BY WAY OF SHOP DRAWINGS, AND ARE TO BE SIGNED AND SEALED BY A REGISTERED ENGINEER. SEE LEGEND SHEET FOR BALANCE OF TRUSS NOTES.

DOWNSPOUT LOCATIONS ARE CONCEPTUAL IN NATURE AND MUST BE COORDINATED BY THE CONTRACTOR ON SITE WITH THE LANDSCAPING, RETAINING WALLS, SIDEWALKS AND INDIVIDUAL BUILDING DOWNSPOUTS. DOWNSPOUTS ARE TO BE INSTALLED FROM THE ROOF TO THE GROUND SURFACE. IT IS THE INTENT OF THE ARCHITECT TO HAVE DOWNSPOUTS FROM THE BUILDING AND OTHER FINISHED SURFACES WHERE POSSIBLE.

DOWN SPOUTS IN COURTYARD ARE TO BE HARD PIPED INTO THE STORM DRAIN - REFER TO LANDSCAPE PLANS FOR LOCATIONS

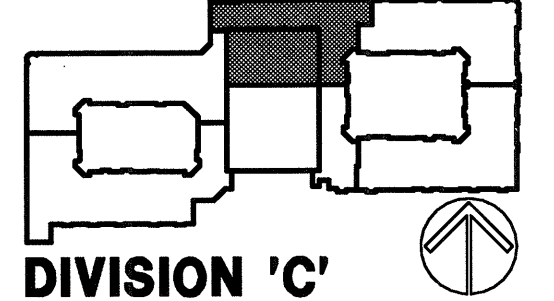

COPYRIGHT © Beeler Guest Owens Architects ALL RIGHTS RESERVED

DIVISION 'C' ROOF PLAN

1/8"=1'-0"

BGO
architects

4144 N. Central Expy.
Suite 955
Dallas, TX 75204
214.520.8878
bgoarchitects.com

CONSTRUCTION ISSUE

10-17-2011

REVISIONS

KELLER SPRINGS LOFTS

LOFT APARTMENTS IN ADDISON, TEXAS

REGISTERED ARCHITECT
STATE OF TEXAS
22453

DATE	08-05-2011
PROJECT	11129
10-17-2011	

SHEET NUMBER	3.5C
BLDG PLAN 'C'	