


ROOF LEGEND:

- INDICATES AREA NOT TO HAVE ROOF PENETRATIONS
- LOW INTAKE ATTIC VENT
- EXHAUST ATTIC VENT
- DRAFT STOP

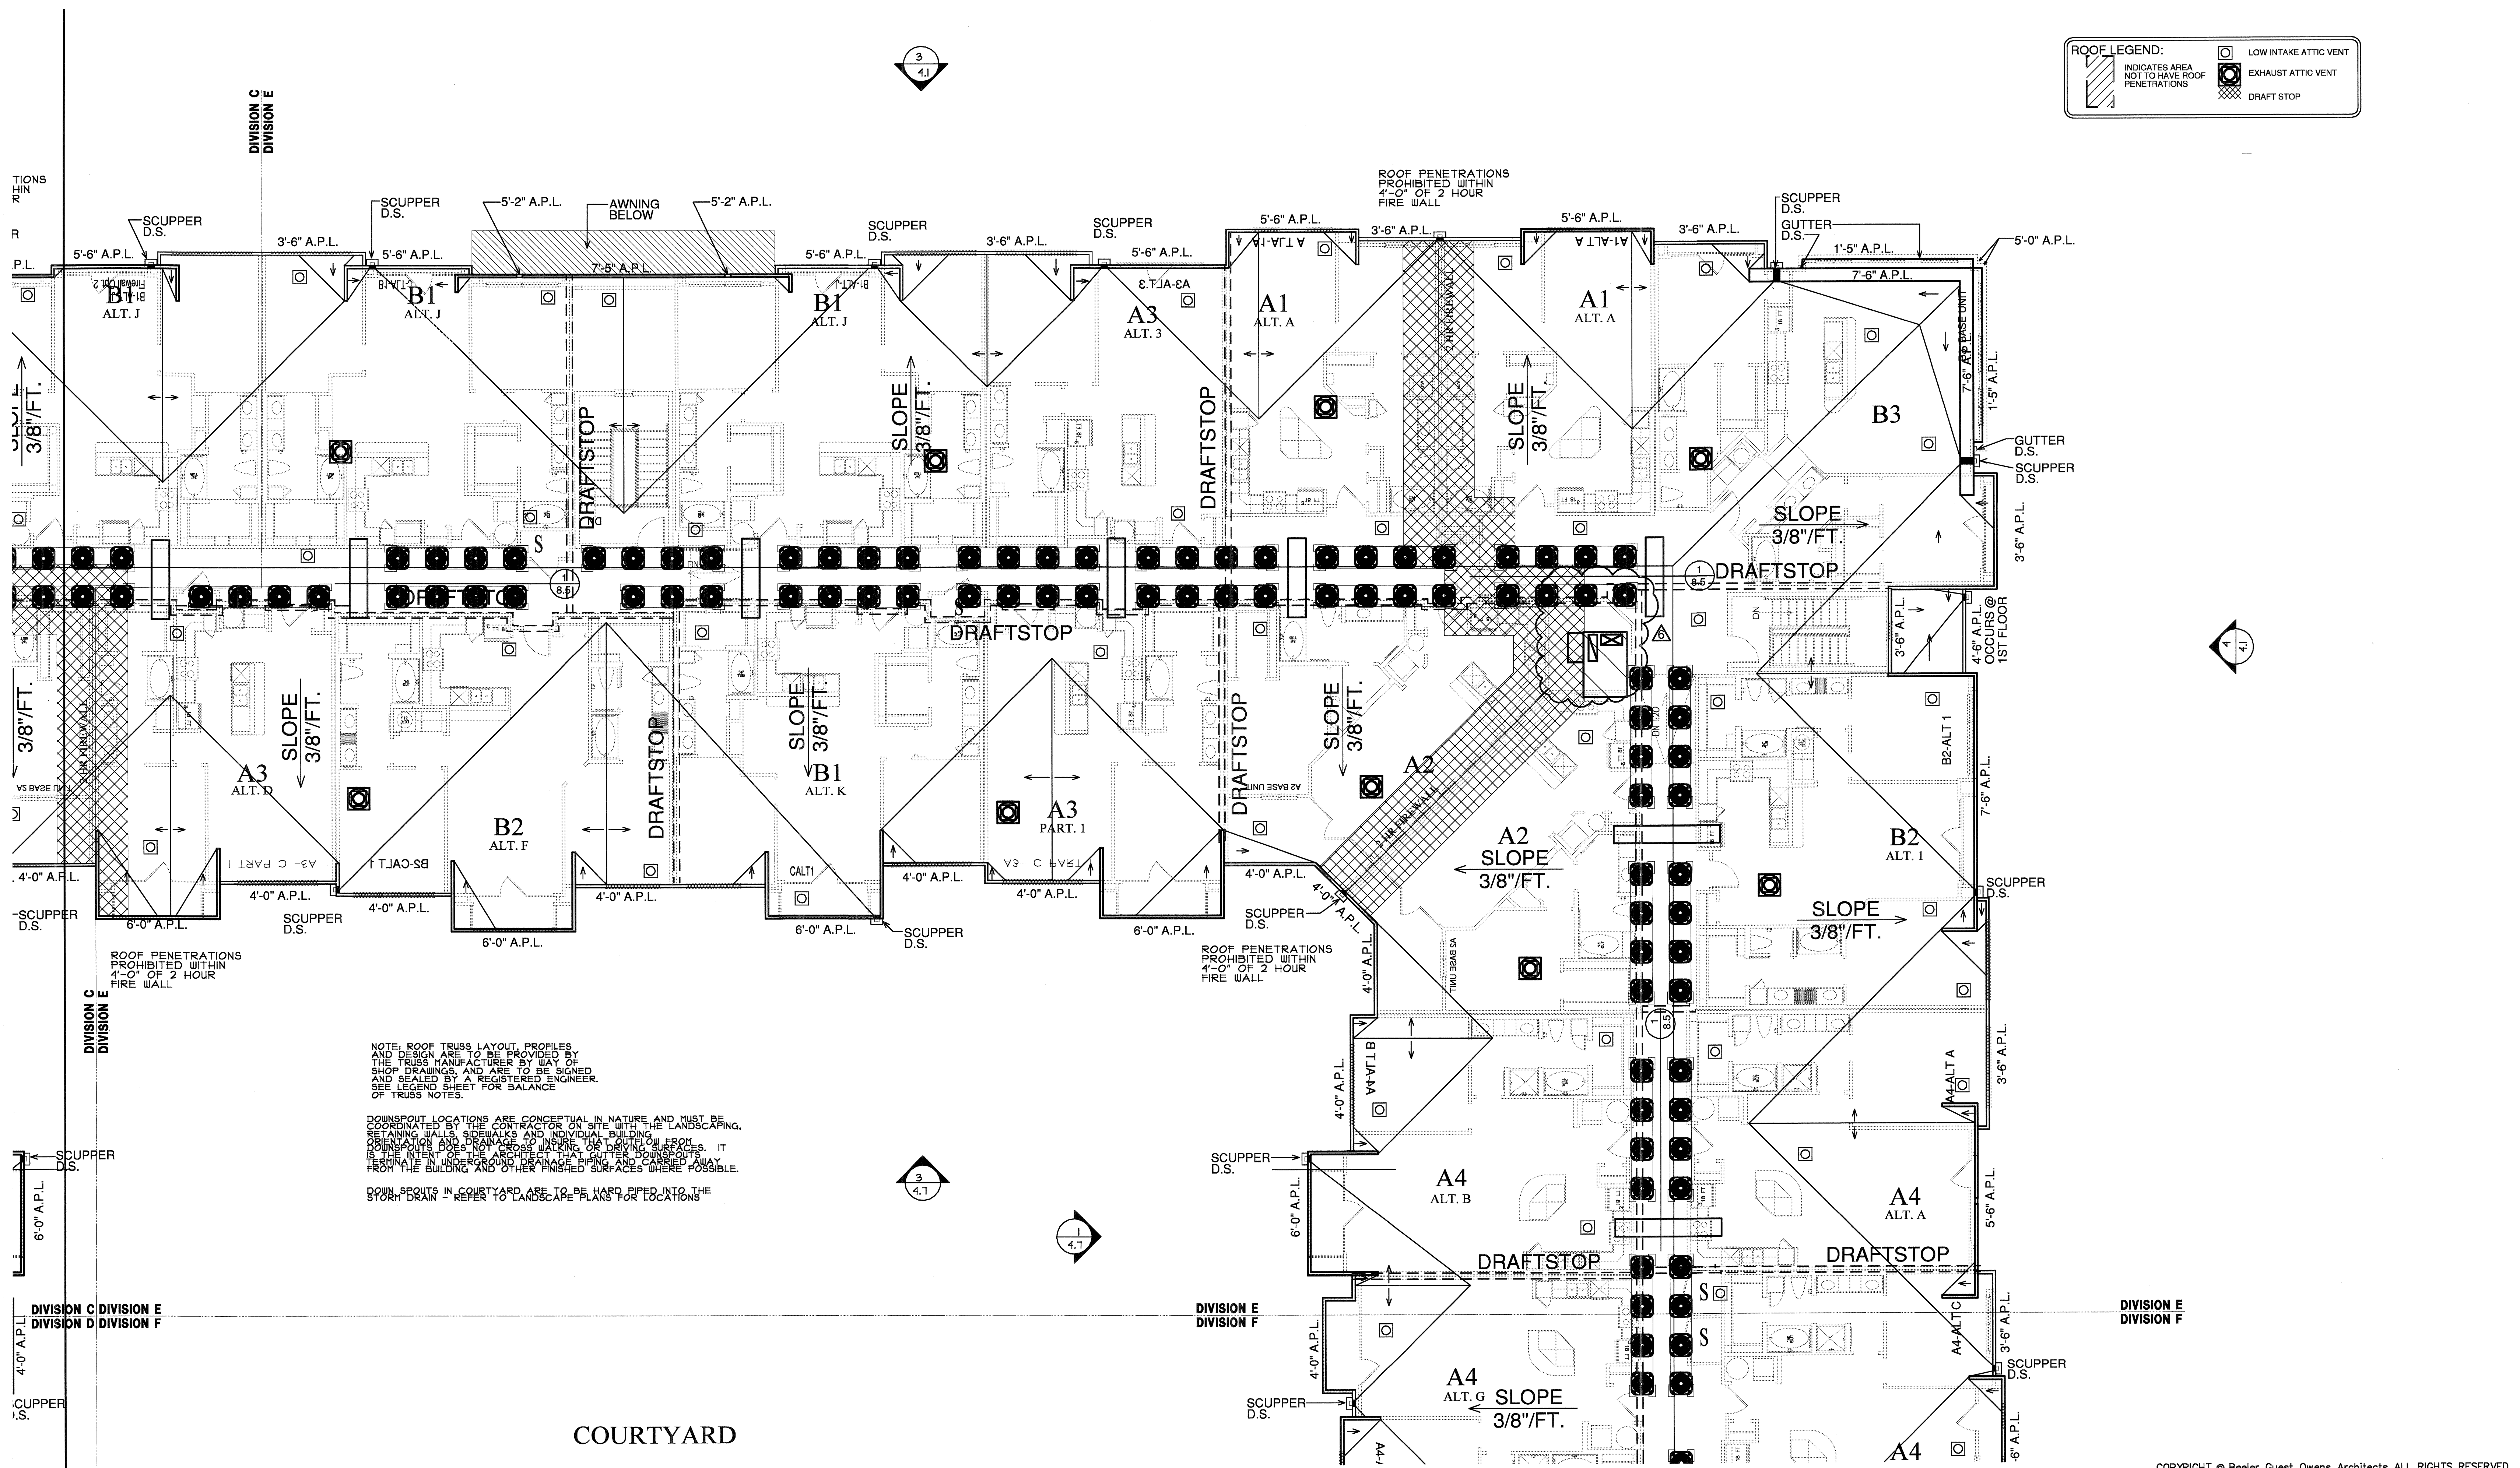

NOTE: ROOF TRUSS LAYOUT, PROFILES AND DESIGN ARE TO BE PROVIDED BY THE TRUSS MANUFACTURER BY WAY OF SHOP DRAWINGS, AND ARE TO BE SIGNED AND SEALED BY A REGISTERED ENGINEER. SEE LEGEND SHEET FOR BALANCE OF TRUSS NOTES.

DOWNSPOUT LOCATIONS ARE CONCEPTUAL IN NATURE AND MUST BE COORDINATED BY THE CONTRACTOR ON SITE WITH THE LANDSCAPING, RETAINING WALLS, SIDEWALKS AND INDIVIDUAL BUILDING ORIENTATION AND DRAINAGE TO INSURE THAT DOWNSPOUTS DO NOT CROSS WALKING OR DRIVING SURFACES. IT IS THE INTENT OF THE ARCHITECT THAT GUTTER DOWNSPOUTS TERMINATE IN UNDERGROUND DRAINAGE PIPING AND CARRIED AWAY FROM THE BUILDING AND OTHER FINISHED SURFACES WHERE POSSIBLE.

DOWNSPOUTS IN COURTYARD ARE TO BE HARD PIPED INTO THE STORM DRAIN - REFER TO LANDSCAPE PLANS FOR LOCATIONS

1 DIVISION 'E' ROOF PLAN
1/8"=1'-0"

<p>BGO architects 4144 N. Central Expy. Suite 855 Dallas, TX 75204 214.520.8878 bgoarchitects.com</p>	<p>CONSTRUCTION ISSUE 10-17-2011</p>	<p>REVISIONS</p>	<p>KELLER SPRINGS LOFTS LOFT APARTMENTS IN ADDISON, TEXAS</p>		<p>DATE 08-05-2011</p>	<p>SHEET NUMBER 3.5E</p>
	<p>COORDINATION 04-17-2012</p>	<p>LOFT APARTMENTS IN ADDISON, TEXAS</p>	<p>01-03-2012</p>	<p>PROJECT 11129</p>	<p>BLDG PLAN 'E'</p>	

COPYRIGHT © Beeler Guest Owens Architects ALL RIGHTS RESERVED