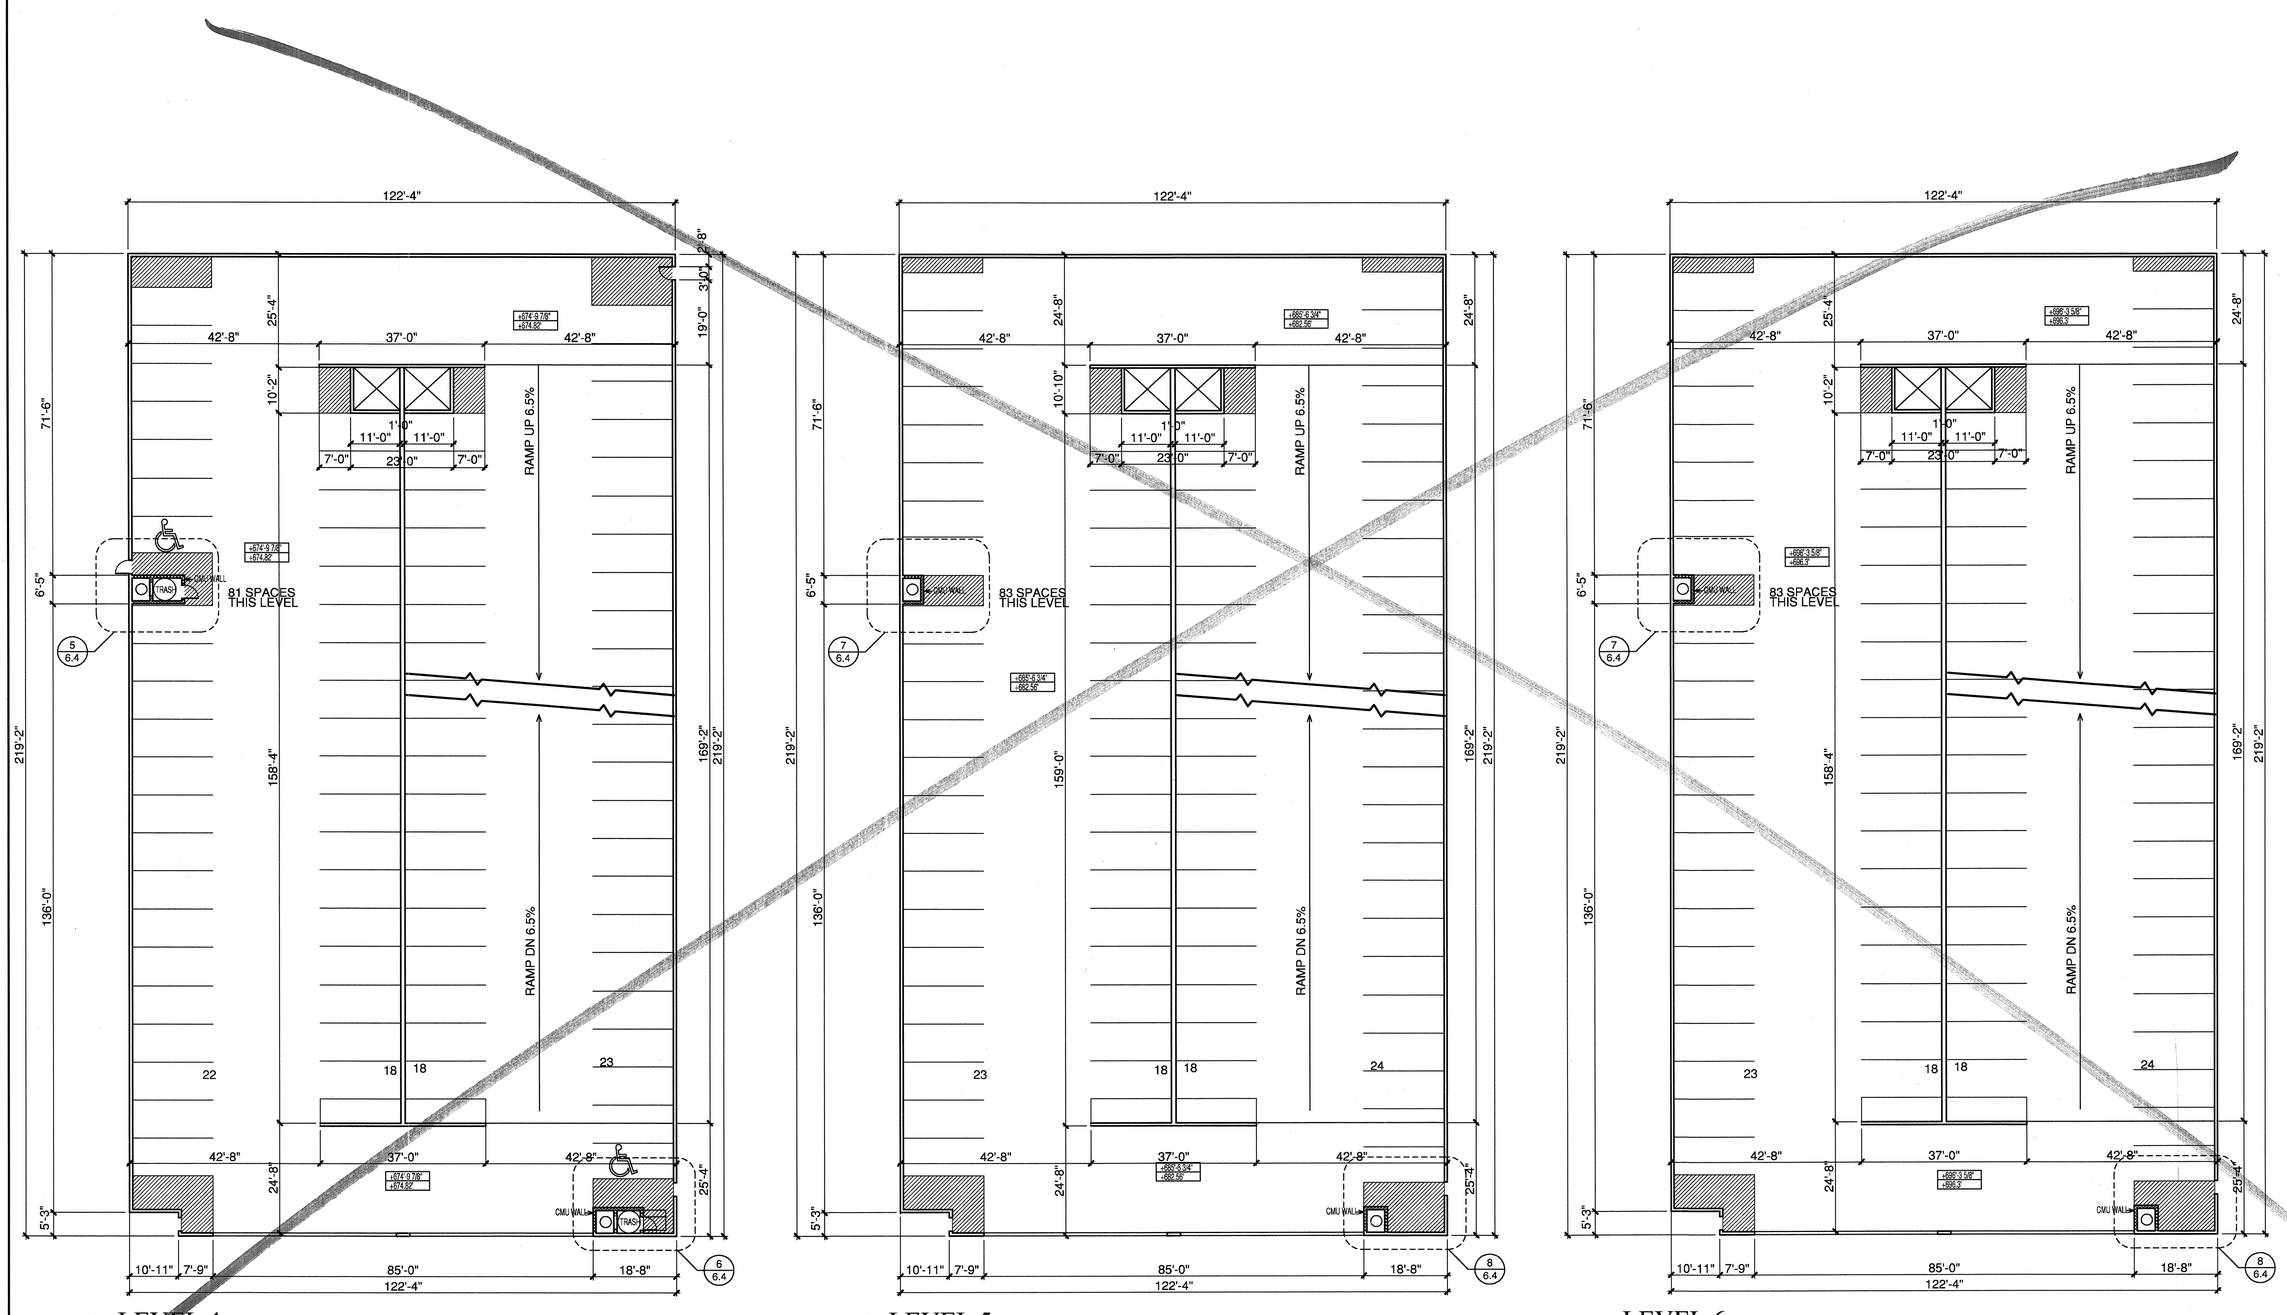

1 LEVEL 4
SCALE: 1/16"=1'-0"

2 LEVEL 5
SCALE: 1/16"=1'-0"

3 LEVEL 6
SCALE: 1/16"=1'-0"

REGISTERED ARCHITECT
STATE OF TEXAS
10-17-2011

REVISIONS

KELLER SPRINGS LOFTS

LOFT APARTMENTS IN ADDISON, TEXAS

CONSTRUCTION ISSUE
10-17-2011

BGO architects
4144 N. Central Expy.
Suite 855
Dallas, TX 75204
214.520.8878
bgoarchitects.com

DATE
08-05-2011

PROJECT
11129

SHEET NUMBER
6.3
GARAGE PLAN
4-6

COPYRIGHT © Beeler Guest Owens Architects ALL RIGHTS RESERVED