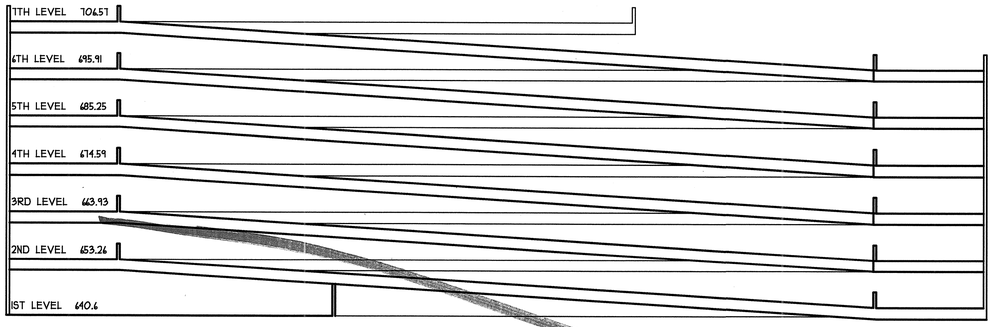

2 GARAGE SECTION
SCALE: 1/16"=1'-0"

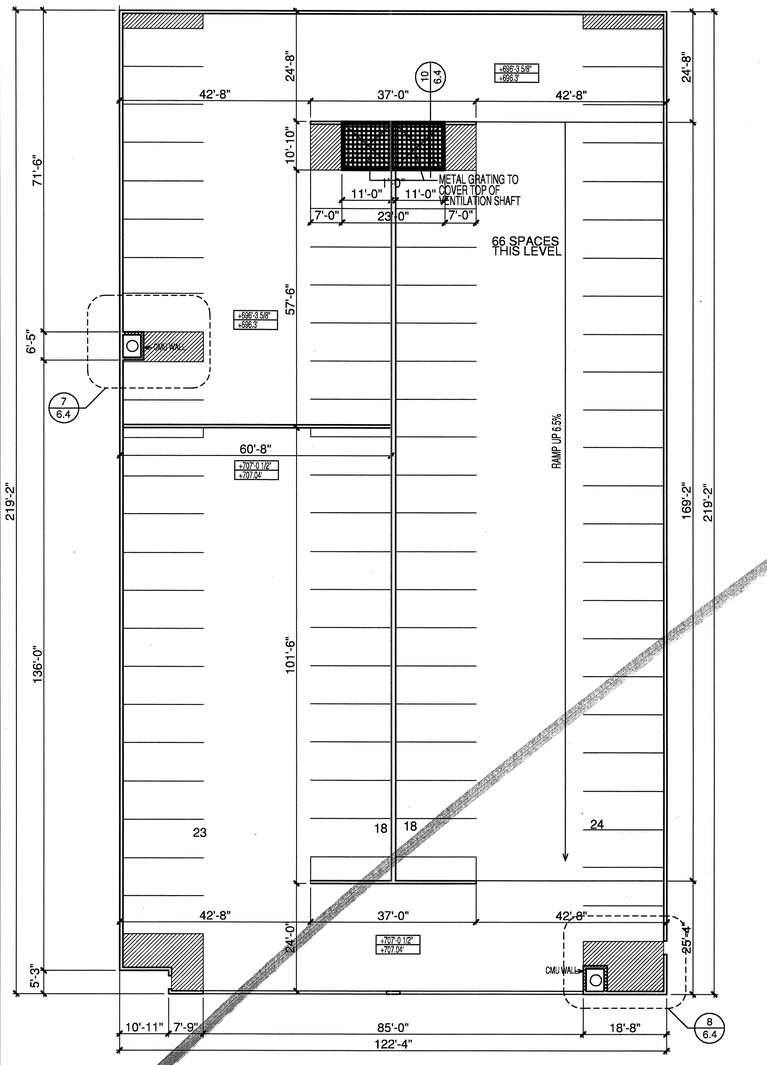

1 LEVEL 7
SCALE: 1/16"=1'-0"

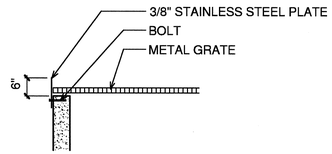

10 A/C GRATE COVER SECTION DETAIL
SCALE: 1/2"=1'-0"

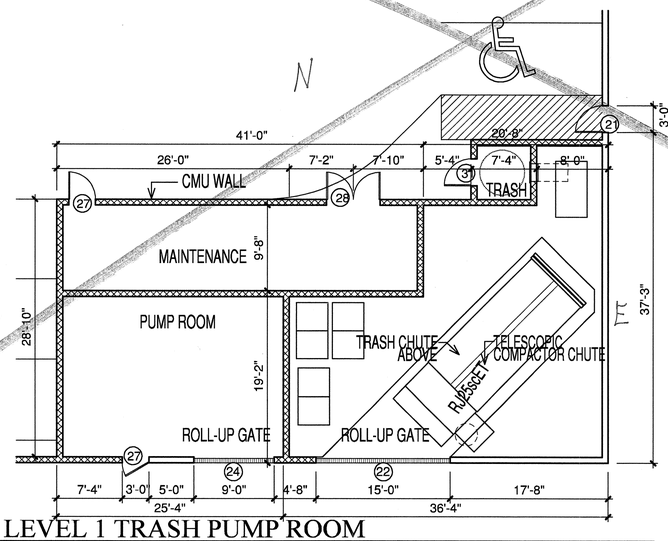

4 LEVEL 1 TRASH PUMP ROOM
SCALE: 1/8"=1'-0"

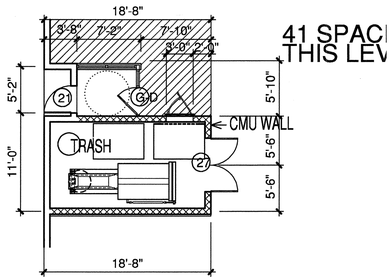

3 LEVEL 1 TRASH
SCALE: 1/8"=1'-0"

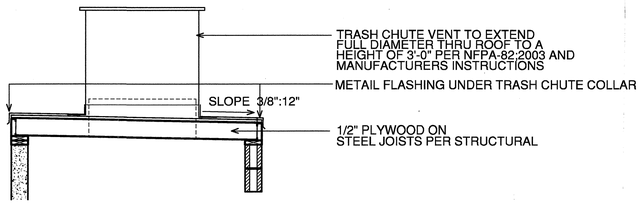

9 TRASH CHUTE ROOF PENETRATION
SCALE: 1/2"=1'-0"

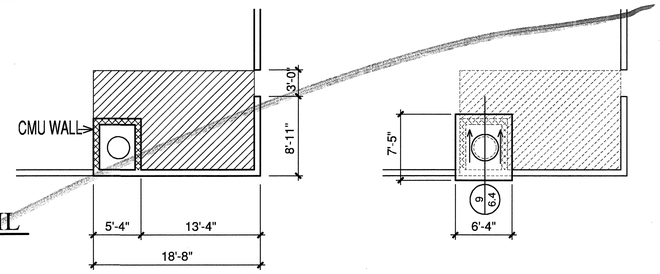

8 LEVEL 5-7 TRASH SHAFT ROOF
SCALE: 1/8"=1'-0"

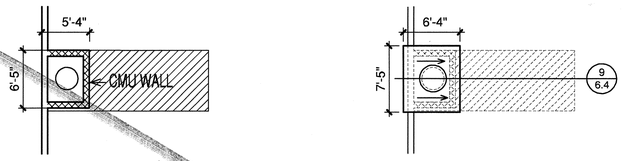

7 LEVEL 5-7 TRASH SHAFT ROOF
SCALE: 1/8"=1'-0"

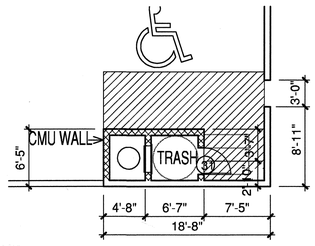

6 LEVEL 2-4 ENTRY
SCALE: 1/8"=1'-0"

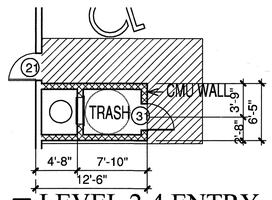

5 LEVEL 2-4 ENTRY
SCALE: 1/8"=1'-0"

COPYRIGHT © Beeler Guest Owens Architects ALL RIGHTS RESERVED

REVISIONS

KELLER SPRINGS LOFTS
LOFT APARTMENTS IN ADDISON, TEXAS

CONSTRUCTION ISSUE
10-17-2011

BGO architects
4144 N. Central Expy.
Suite 855
Dallas, TX 75204
214.520.8878
bgoarchitects.com

DATE
08-05-2011

PROJECT
11129

SHEET NUMBER
6.4

GARAGE PLAN 7 & SECTION