NOTE:
BID ALTERNATE TPO ROOFING

NOTE @ ALL FOAM DETAIL LOCATIONS:
5/8" MAGNA-WALL STUCCO
ON FOAM DETAIL ON 5/8" MAGNA-WALL
STUCCO ON FELT ON 1/2" TYVEK
STUCCO WRAP ON 1/2" GP. SHEATHING

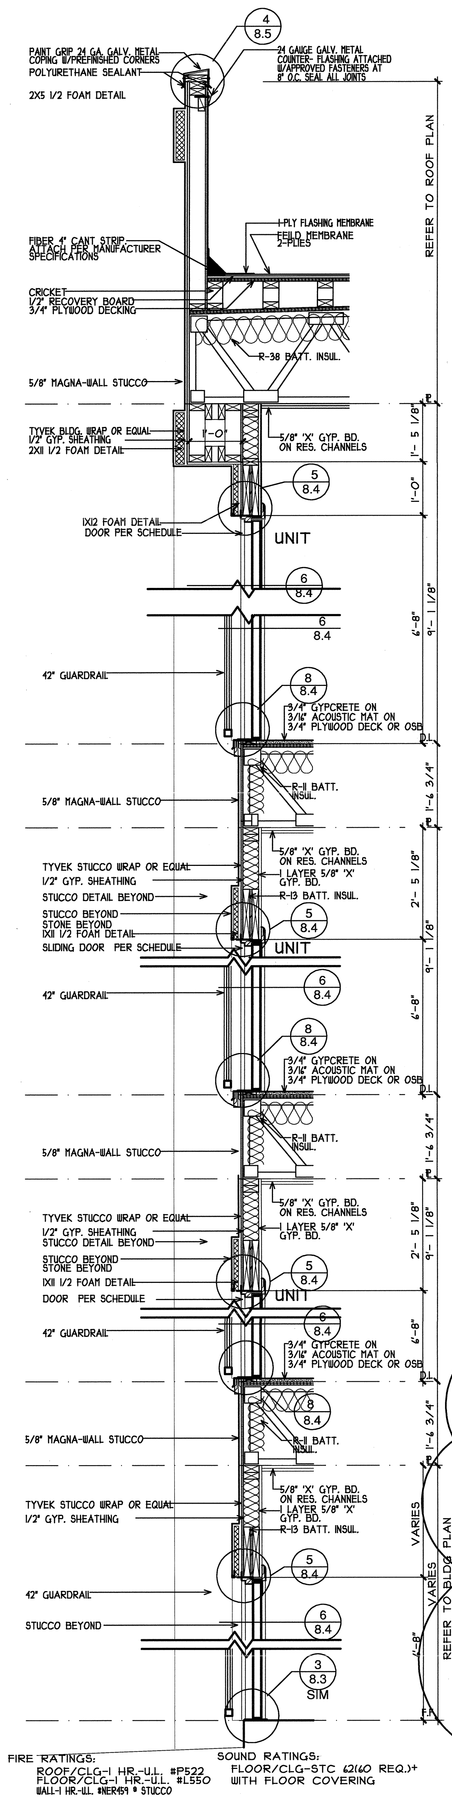

2 4-STORY EXT. - BALCONY
3/4"=1'-0"

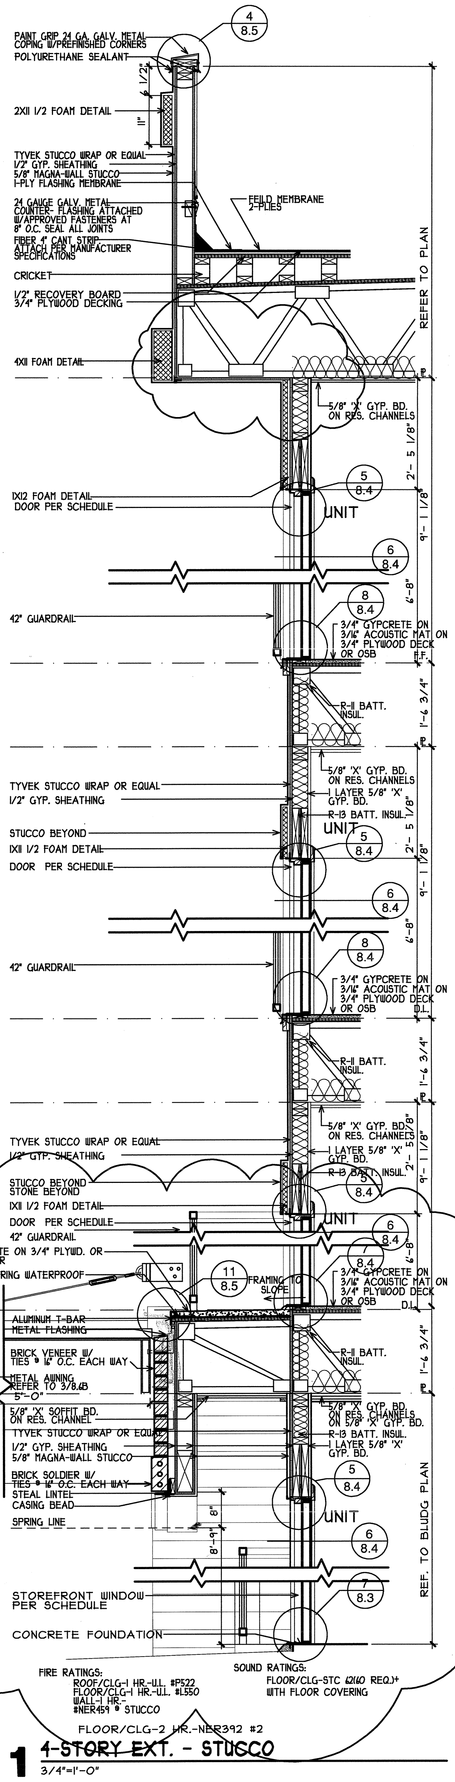

1 4-STORY EXT. - STUCCO
3/4"=1'-0"

COPYRIGHT © Beeler Guest Owens Architects ALL RIGHTS RESERVED

4 ST. WALL

SHEET NUMBER 7.11

PROJECT 1129

DATE 08-05-2011

BGO architects
4144 N. Central Expy.
Suite 1000
Dallas, TX 75204
214.520.8878
bgoarchitects.com

REVIEW PRINTS NOT TO BE USED FOR REGULATORY APPROVAL, PERMIT, OR CONSTRUCTION

KELLER SPRINGS LOFTS

LOFT APARTMENTS IN ADDISON, TEXAS

REVISIONS
COORDINATION 10-17-2011

REGISTERED ARCHITECT
22433
STATE OF TEXAS
10-17-2011