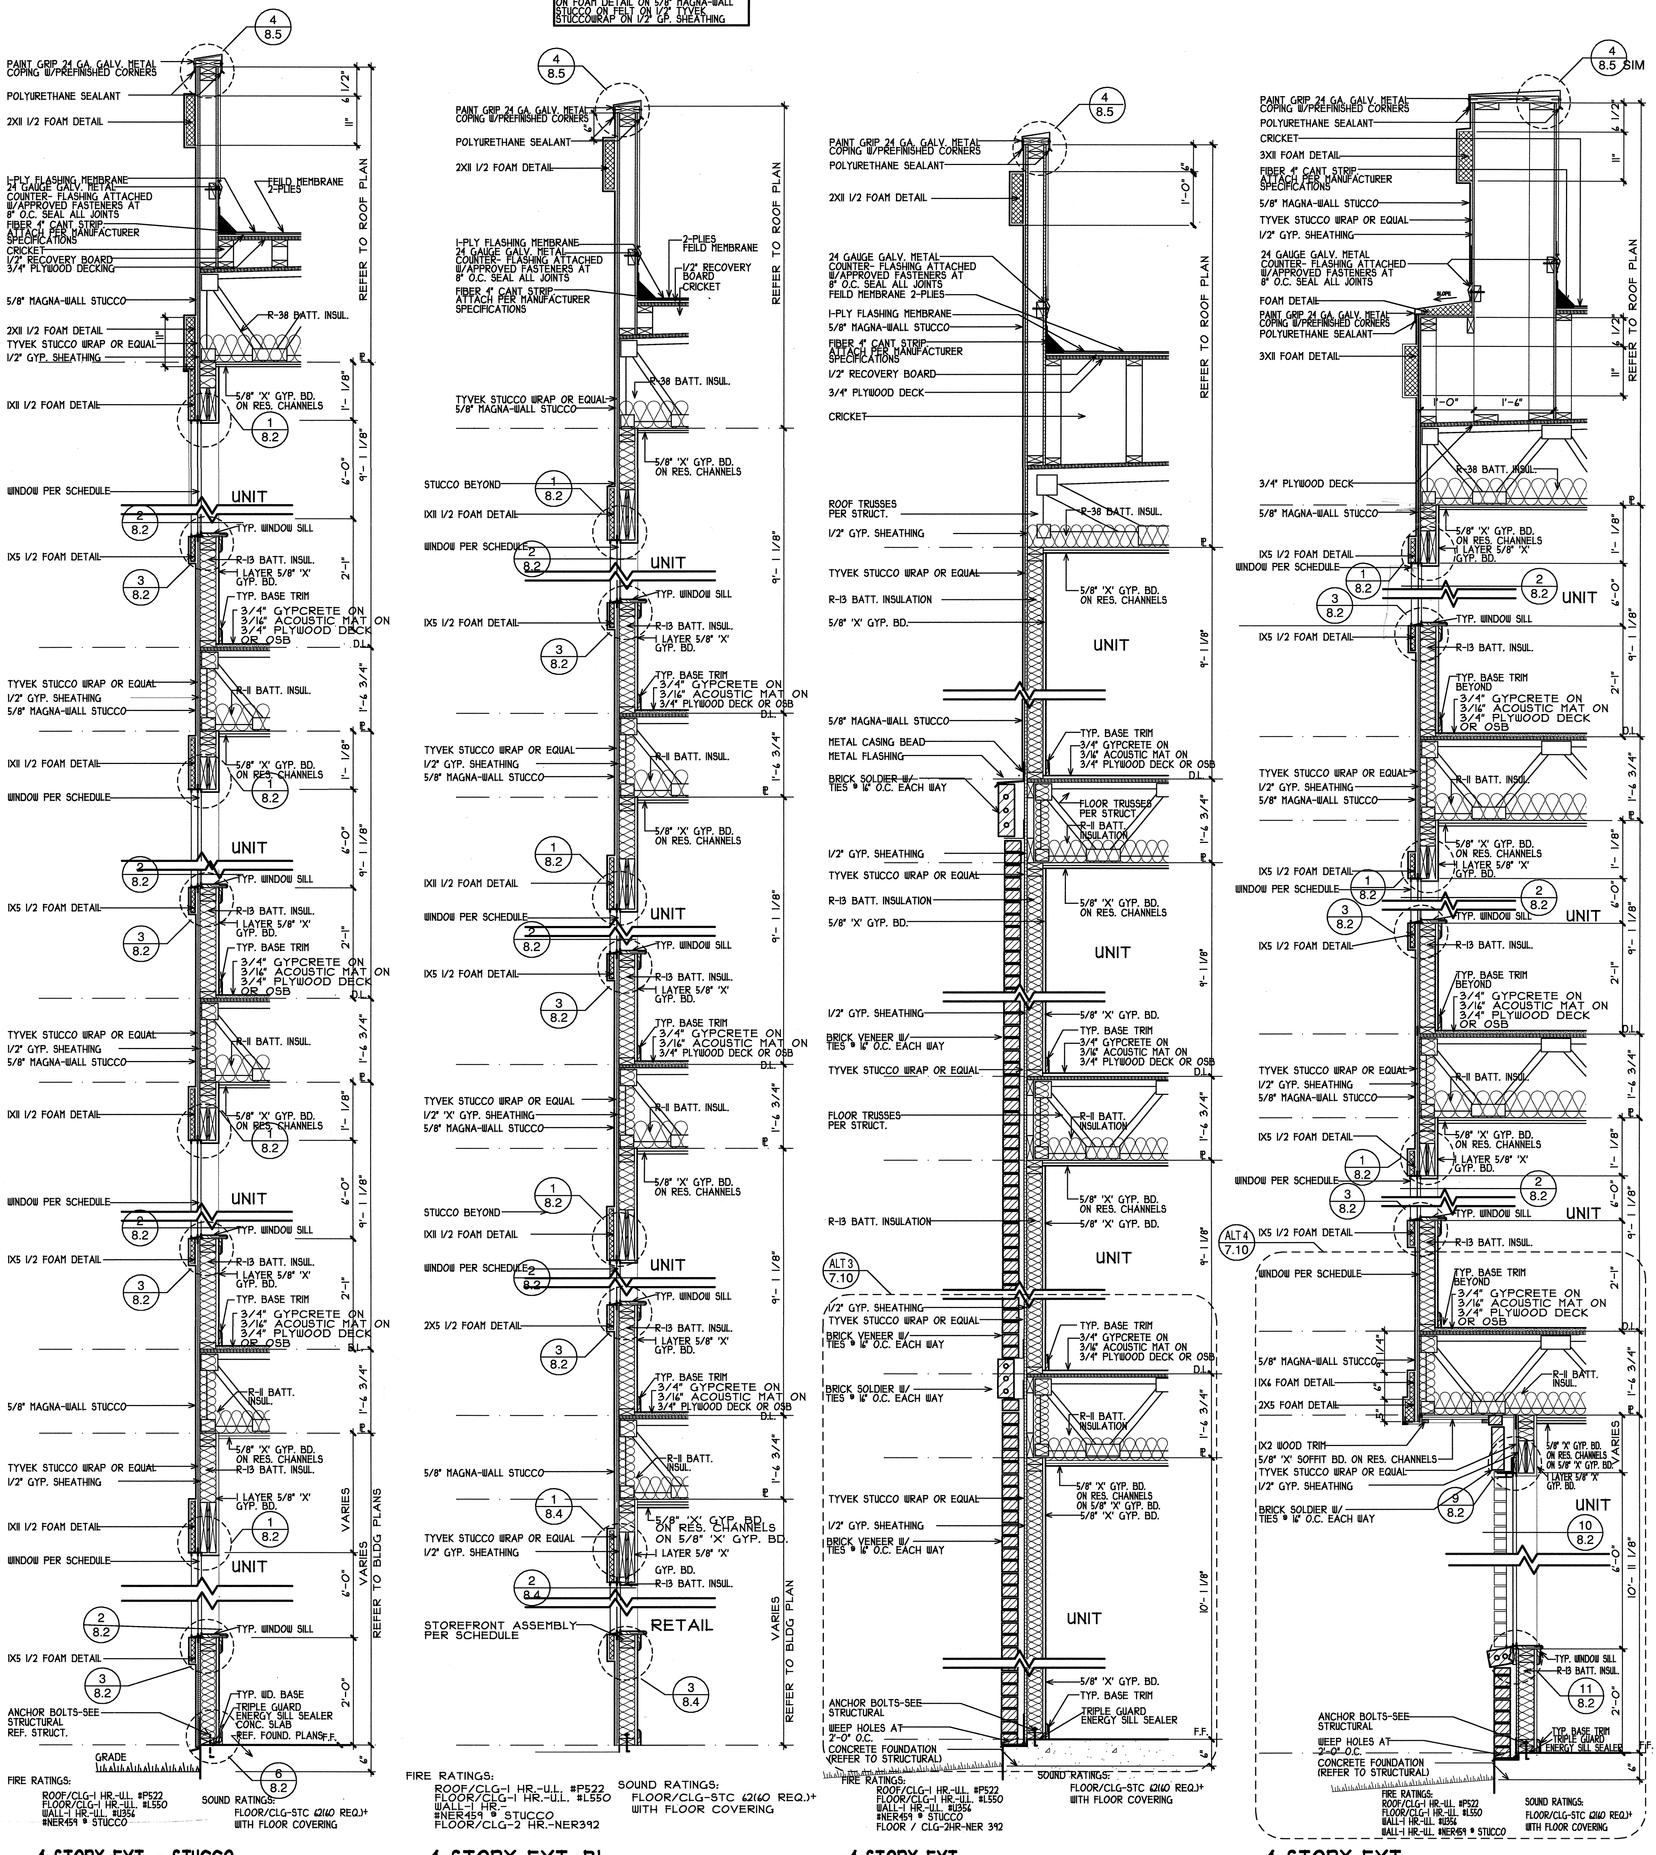

4 4-STORY EXT. - STUCCO
3/4"=1'-0"

3 4-STORY EXT. BI
3/4"=1'-0"

2 4-STORY EXT.
3/4"=1'-0"

1 4-STORY EXT.
3/4"=1'-0"

COPYRIGHT © Beeler Guest Owens Architects ALL RIGHTS RESERVED

4 ST. WALL

SHEET NUMBER 7.4

PROJECT 11129

DATE 08-05-2011

BGO architects
4144 N. Central Expy.
Suite 1000
Dallas, TX 75204
214.520.8878
bgoarchitects.com

CONSTRUCTION ISSUE
10-17-2011

KELLER SPRINGS LOFTS

LOFT APARTMENTS IN ADDISON, TEXAS

REVISIONS
COORDINATION 10-17-2011

REGISTERED ARCHITECT
STEVEN O. EARLY
22433
STATE OF TEXAS
10-17-2011