



CONTRACTOR TO ARRANGE CONDENSING UNITS TO MINIMIZE LENGTH OF REFRIGERANT PIPE RUNS. INSTALL PER MANUF. RECOMMENDATIONS AND CODE REQUIREMENTS.

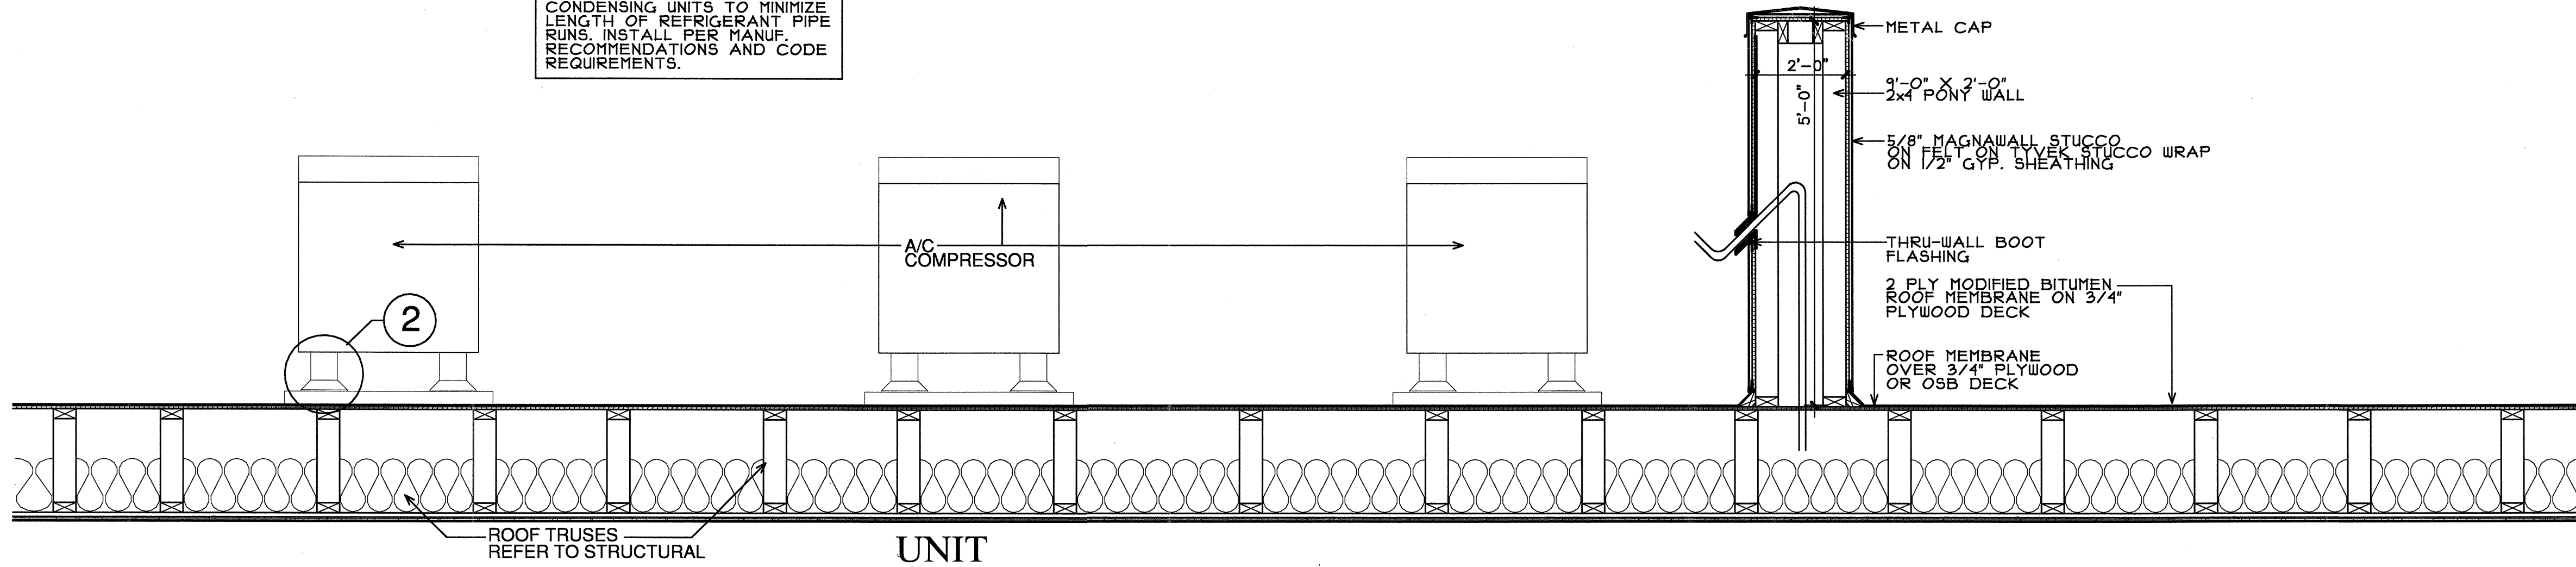


1 SECTION @ HVAC ROOF CONDITION

SCALE: 3/4"=1'-0"

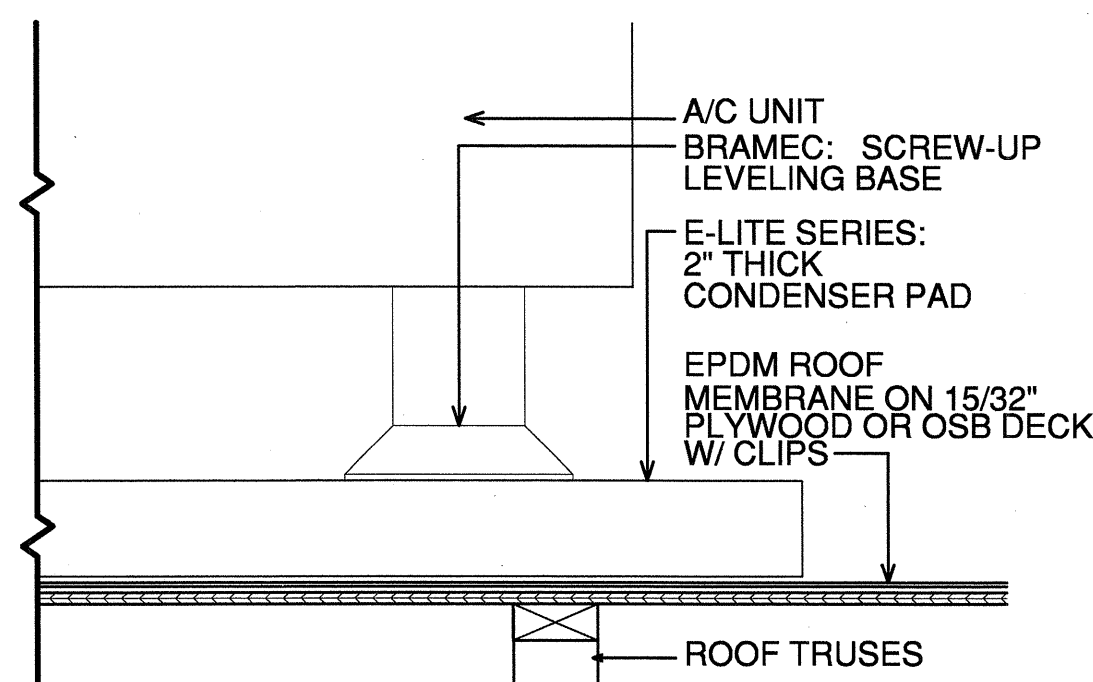


2 PLATFORM DETAIL

SCALE: 1 1/2"=1'-0"

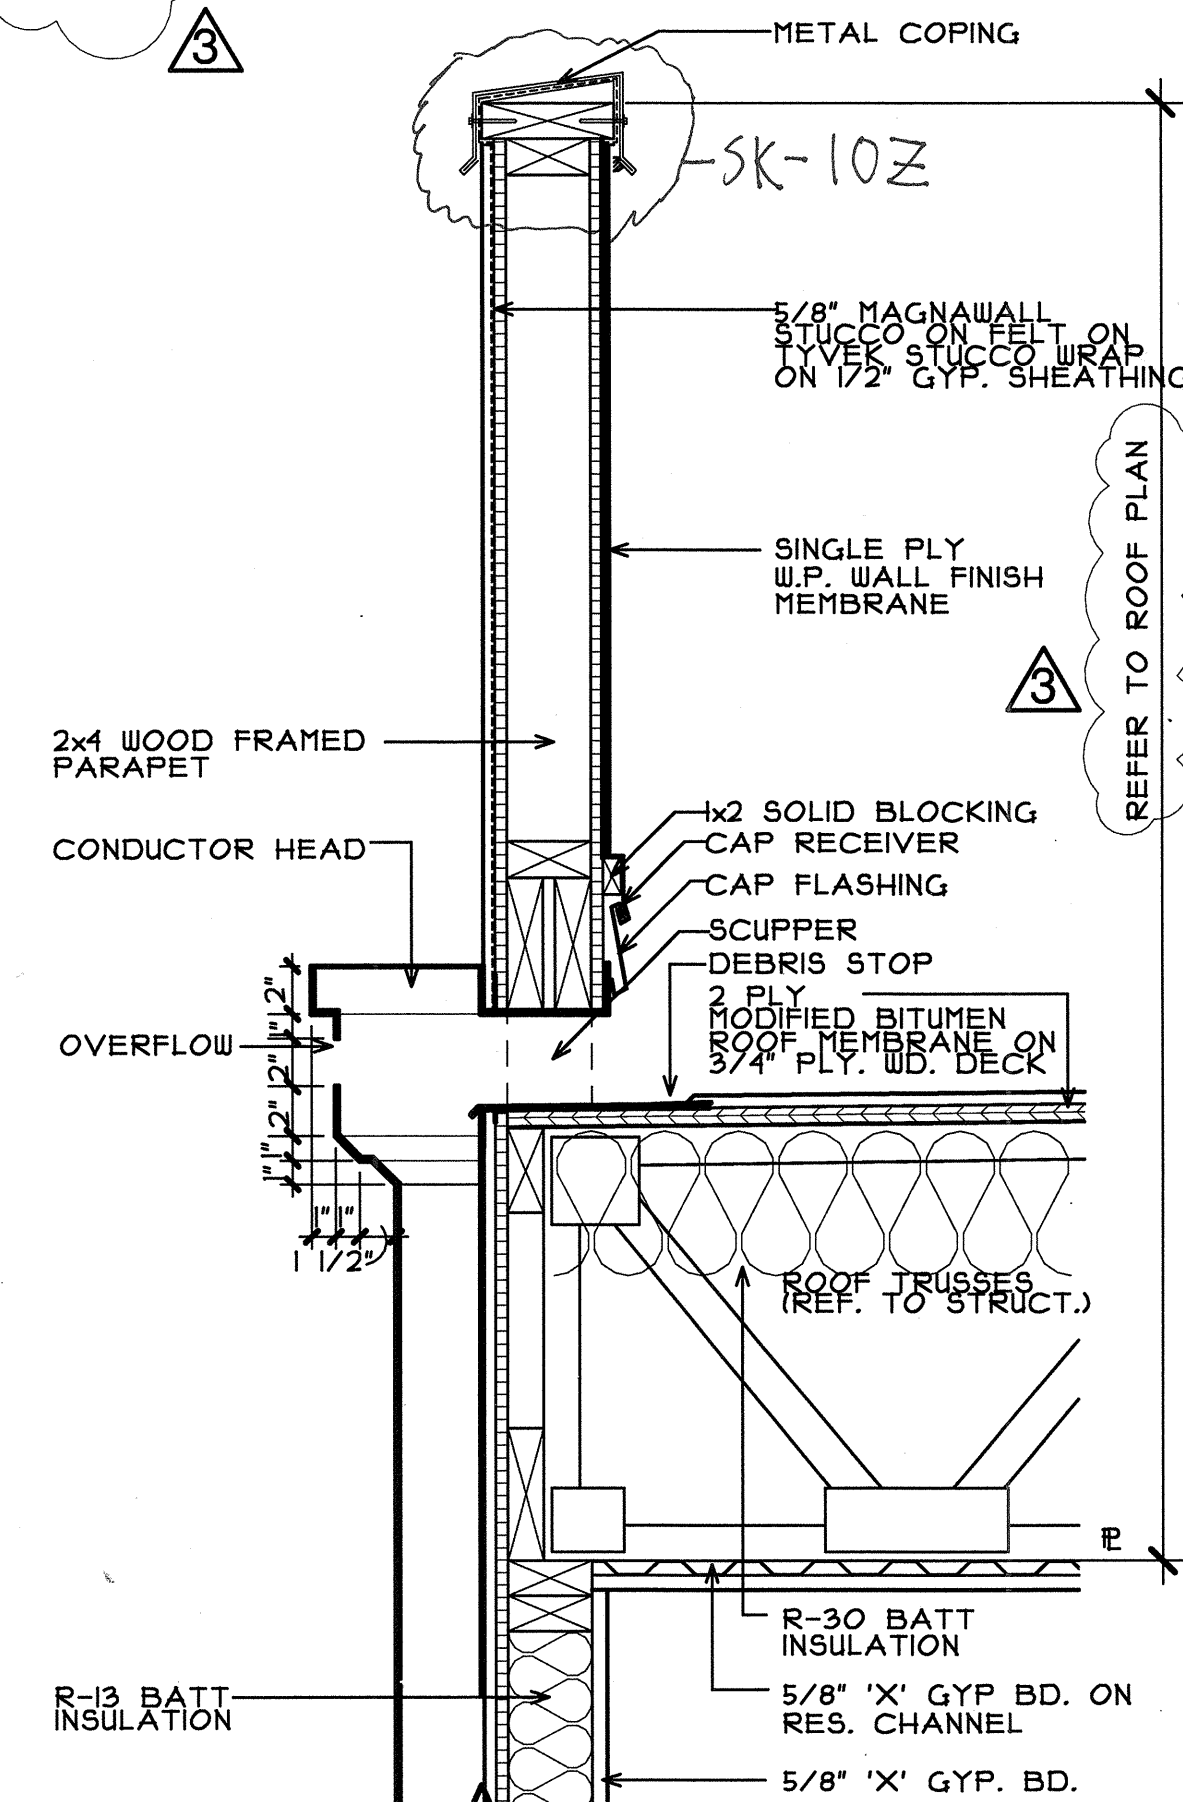


3 PARAPET STUCCO W/SCUPPER

SCALE: 1 1/2"=1'-0"

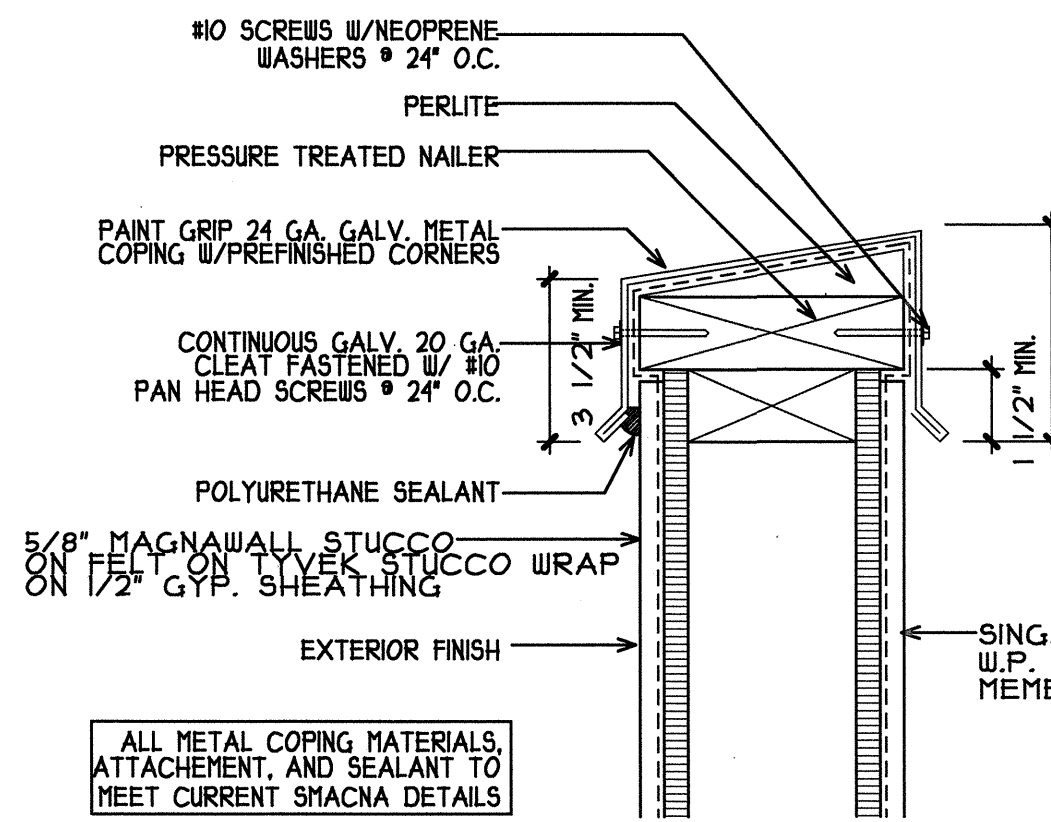


4 PARAPET CAP

SCALE: 3"=1'-0"

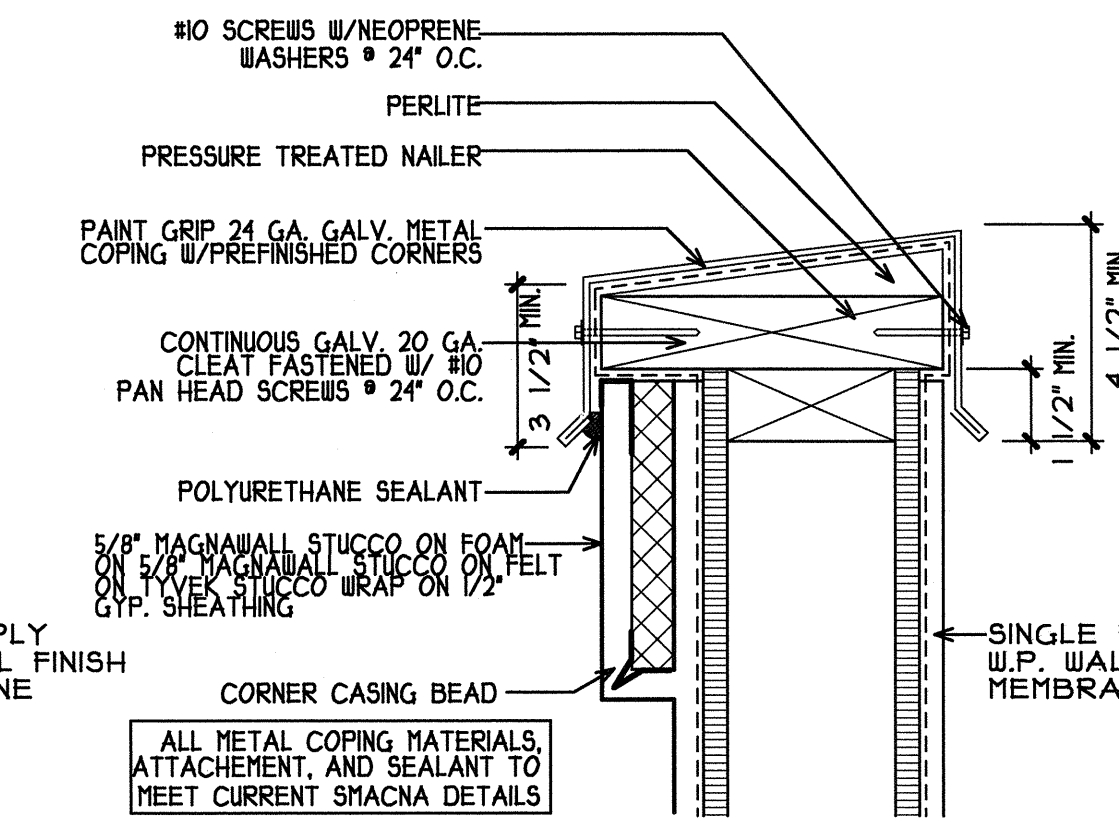


7 PARAPET CAP W/ FOAM TRIM

SCALE: 3"=1'-0"

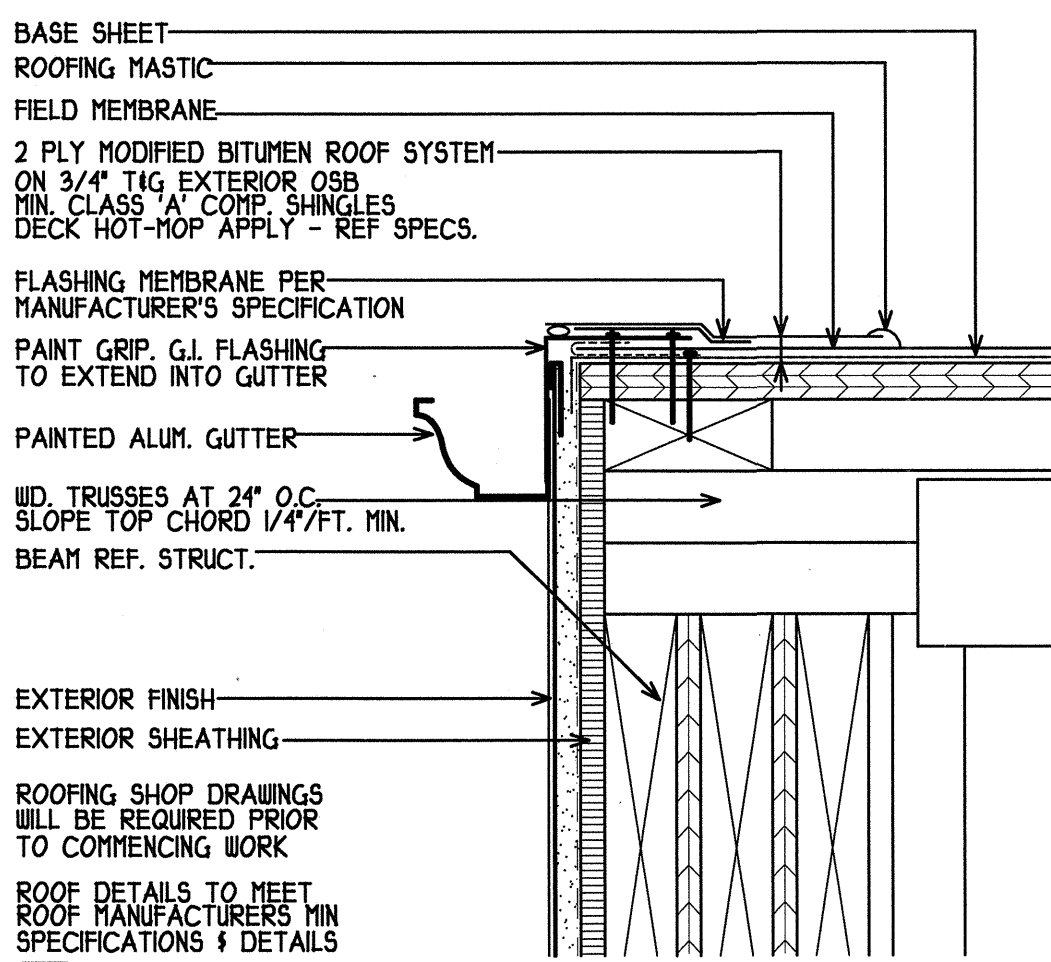


5 ROOF EDGE - MODIFIED BITUMEN

SCALE: 3"=1'-0"

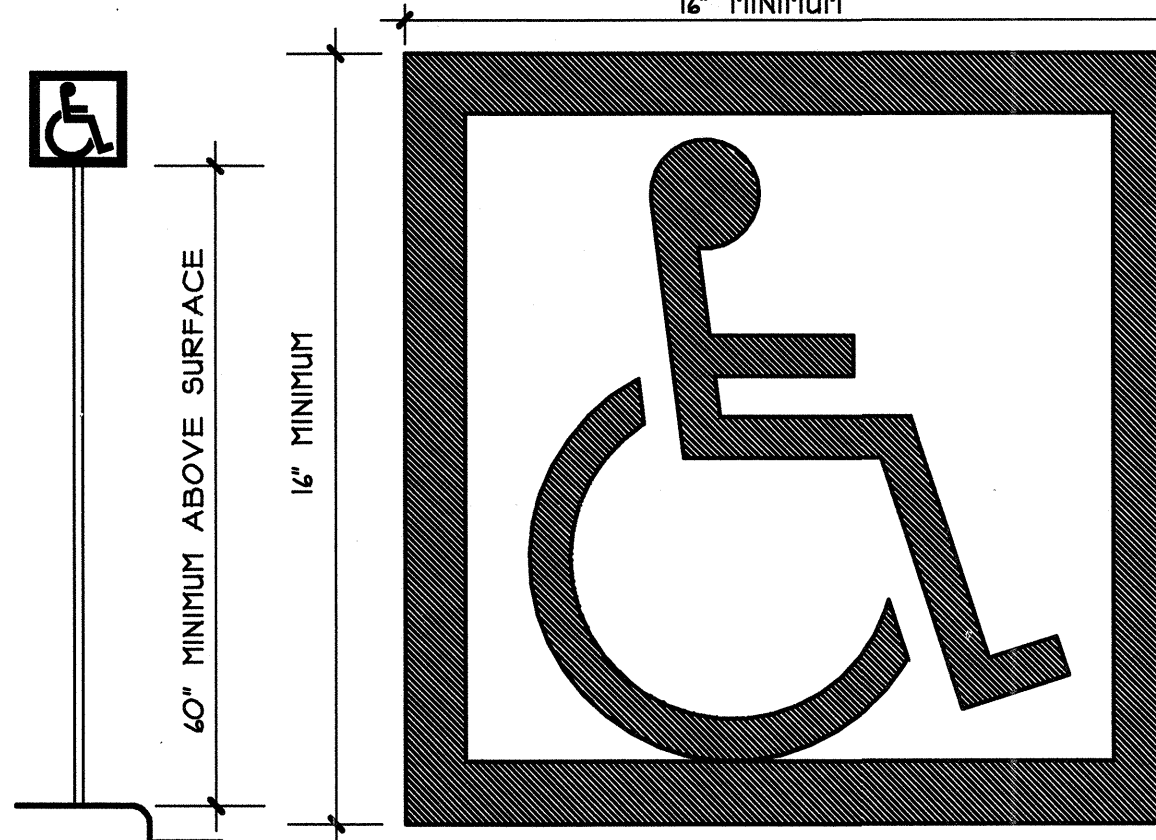


6 TYPICAL PARKING SIGNAGE

EACH ACCESSIBLE PARKING SPACE SHALL BE DESIGNATED AS RESERVED BY A VERTICALLY MOUNTED OR SUSPENDED SIGN SHOWING THE SYMBOL OF ACCESSIBILITY. VAN ACCESSIBLE SPACES SHALL HAVE AN ADDITIONAL SIGN VAN ACCESSIBLE MOUNTED BELOW THE SYMBOL OF ACCESSIBILITY. (TAS 4.4.4) SEE LANDSCAPE PLAN FOR HANDICAP PARKING LOCATIONS.

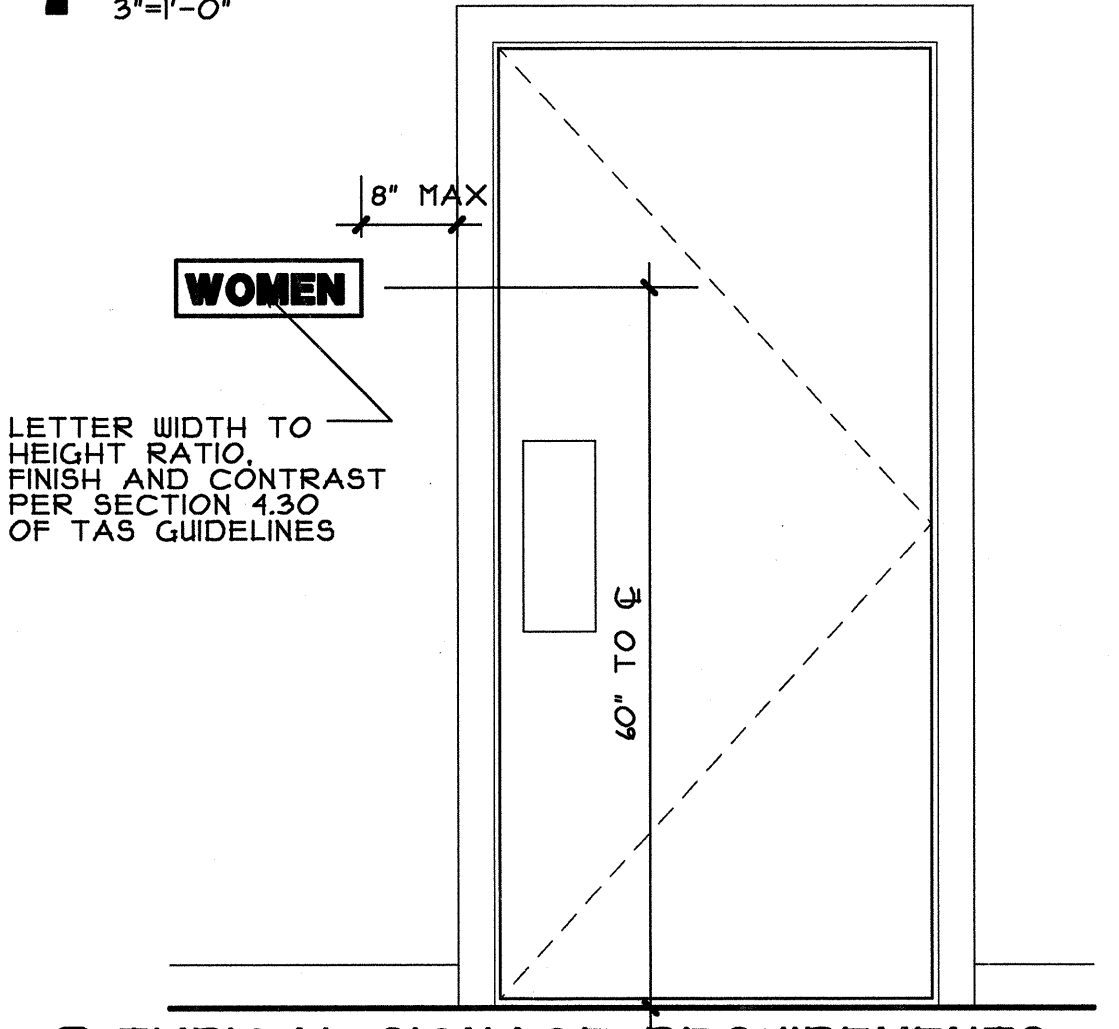


8 TYPICAL SIGNAGE REQUIREMENTS

NO SCALE

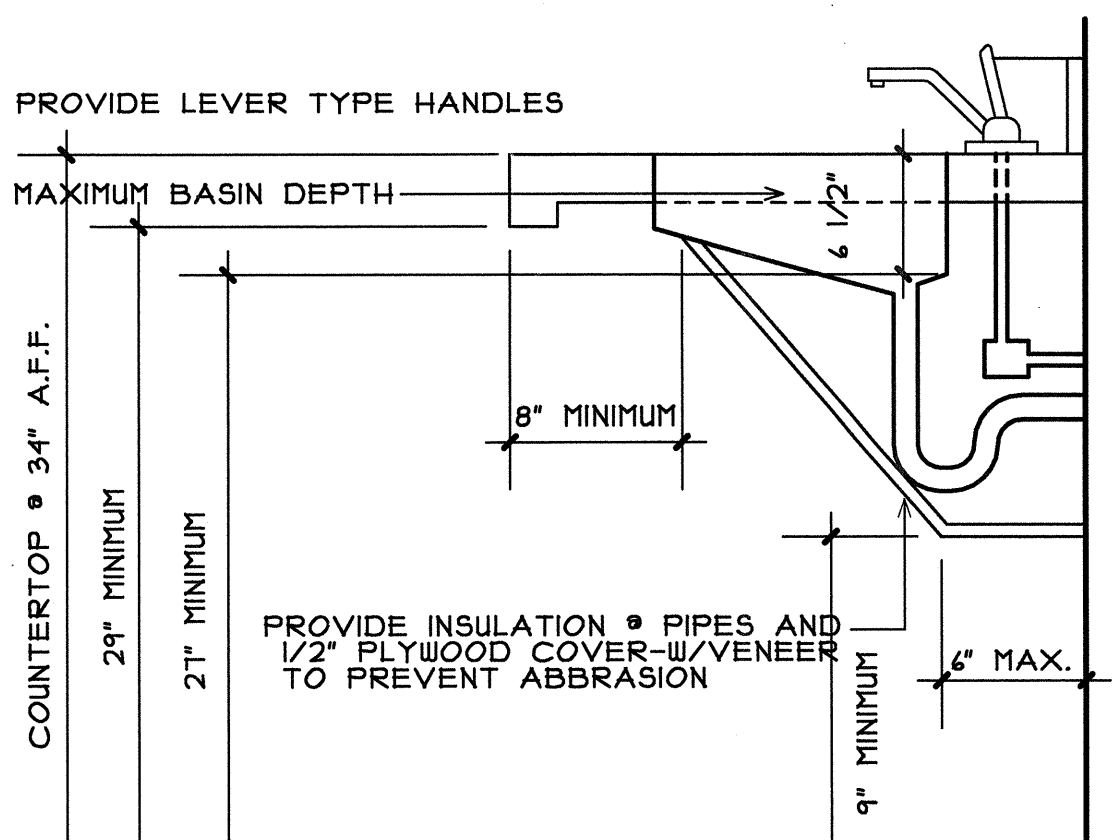


9 ACCESSIBLE SINK DETAIL

SCALE: 1 1/2"=1'-0"

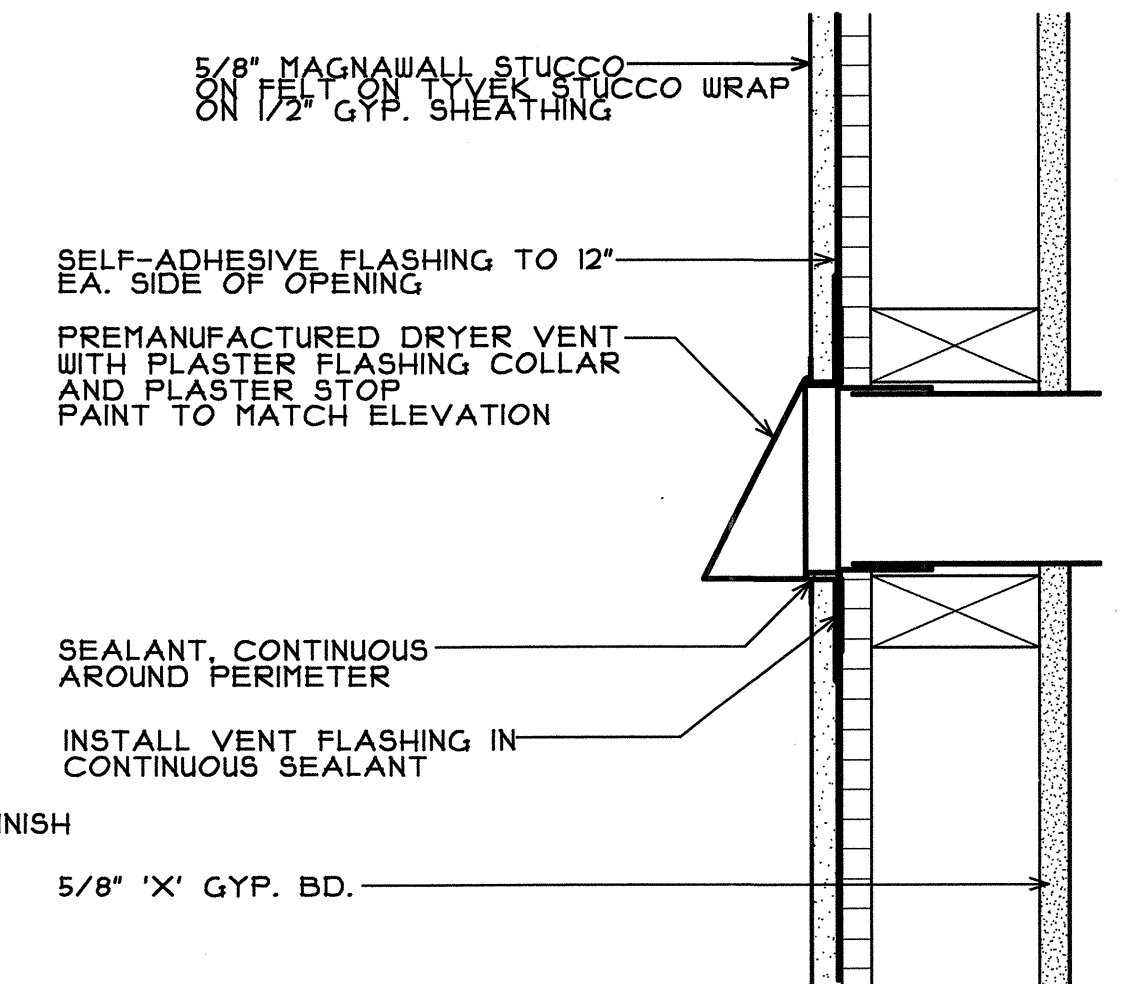


10 STUCCO DESIGNED DRYER VENT

SCALE: 3"=1'-0"

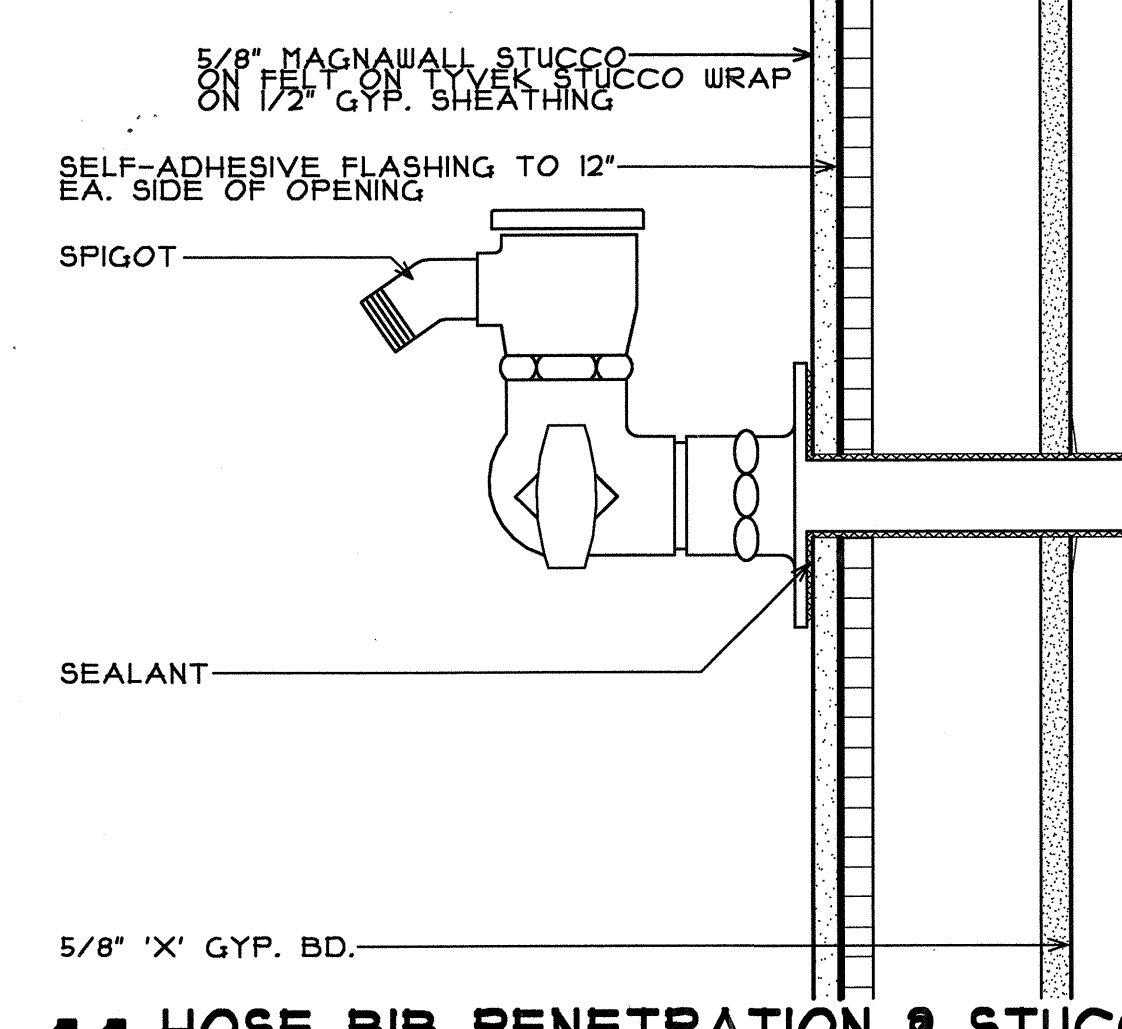


11 HOSE BIB PENETRATION STUCCO

SCALE: 3"=1'-0"

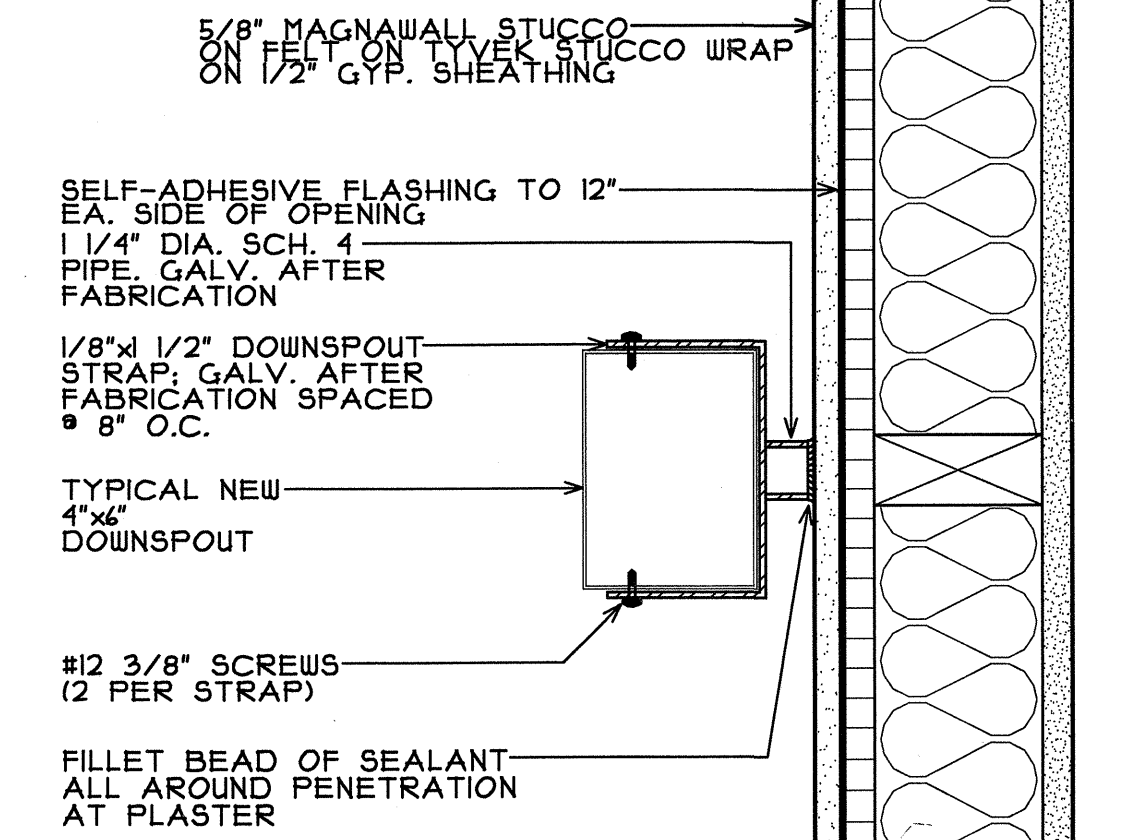


12 TYPICAL DOWNSPOUT SUPPORT

SCALE: 3"=1'-0"

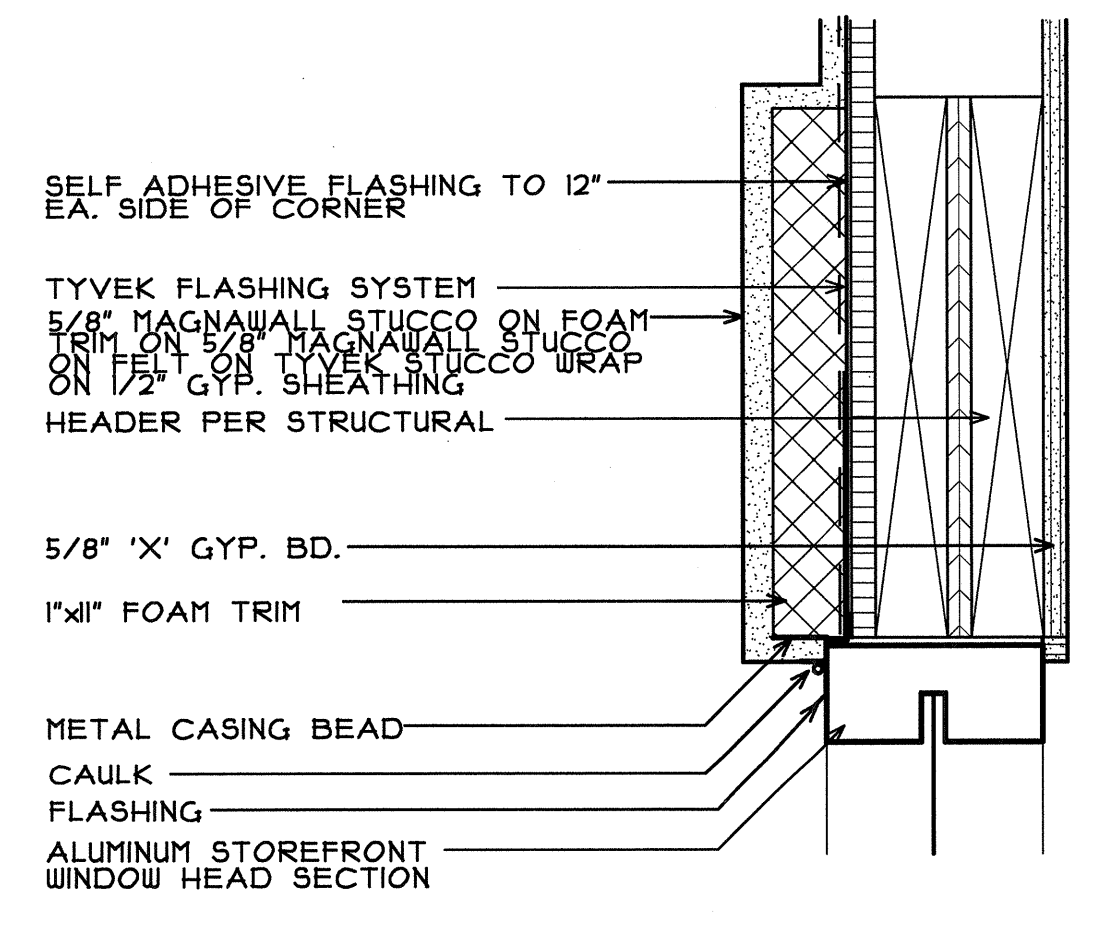


13 STOREFRONT HEAD STUCCO

SCALE: 3"=1'-0"

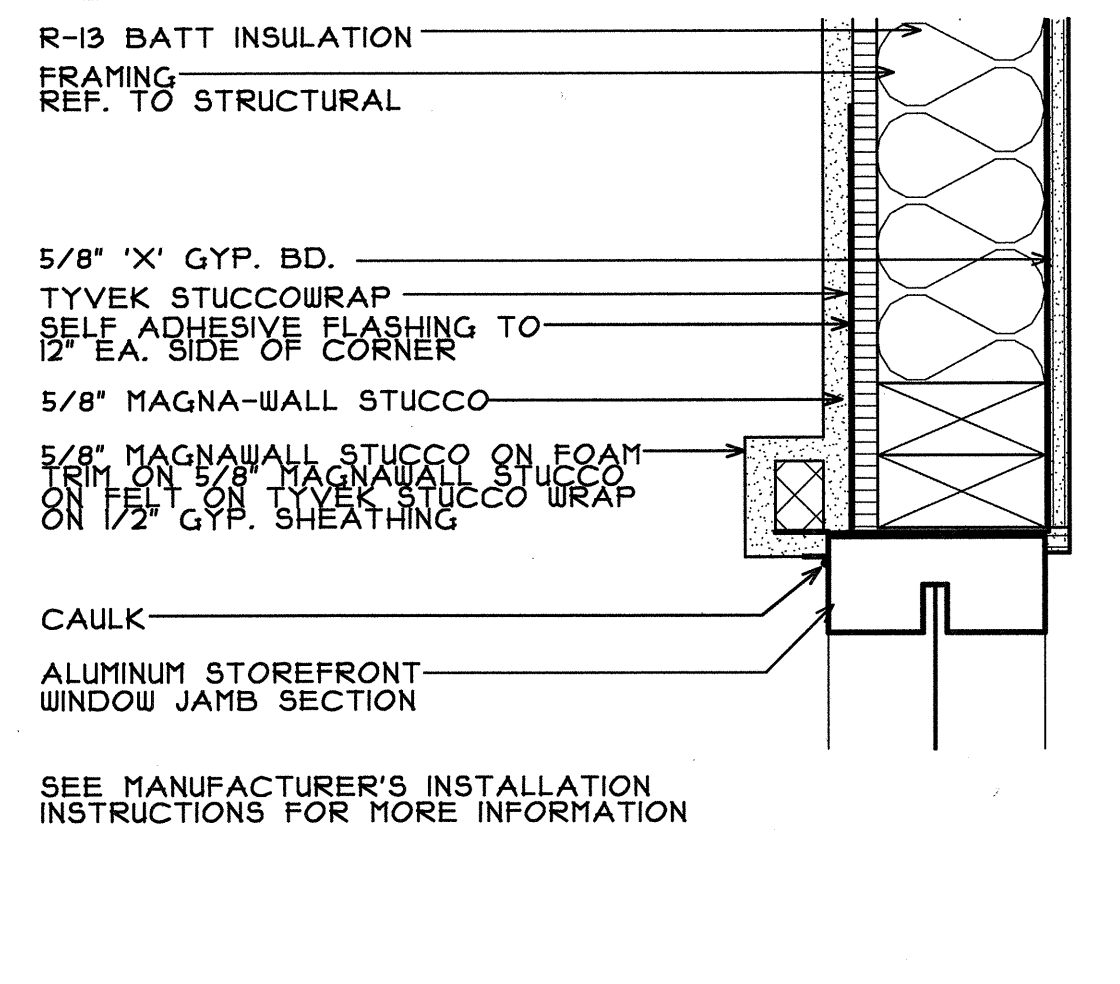


14 STOREFRONT JAMB STUCCO

SCALE: 3"=1'-0"

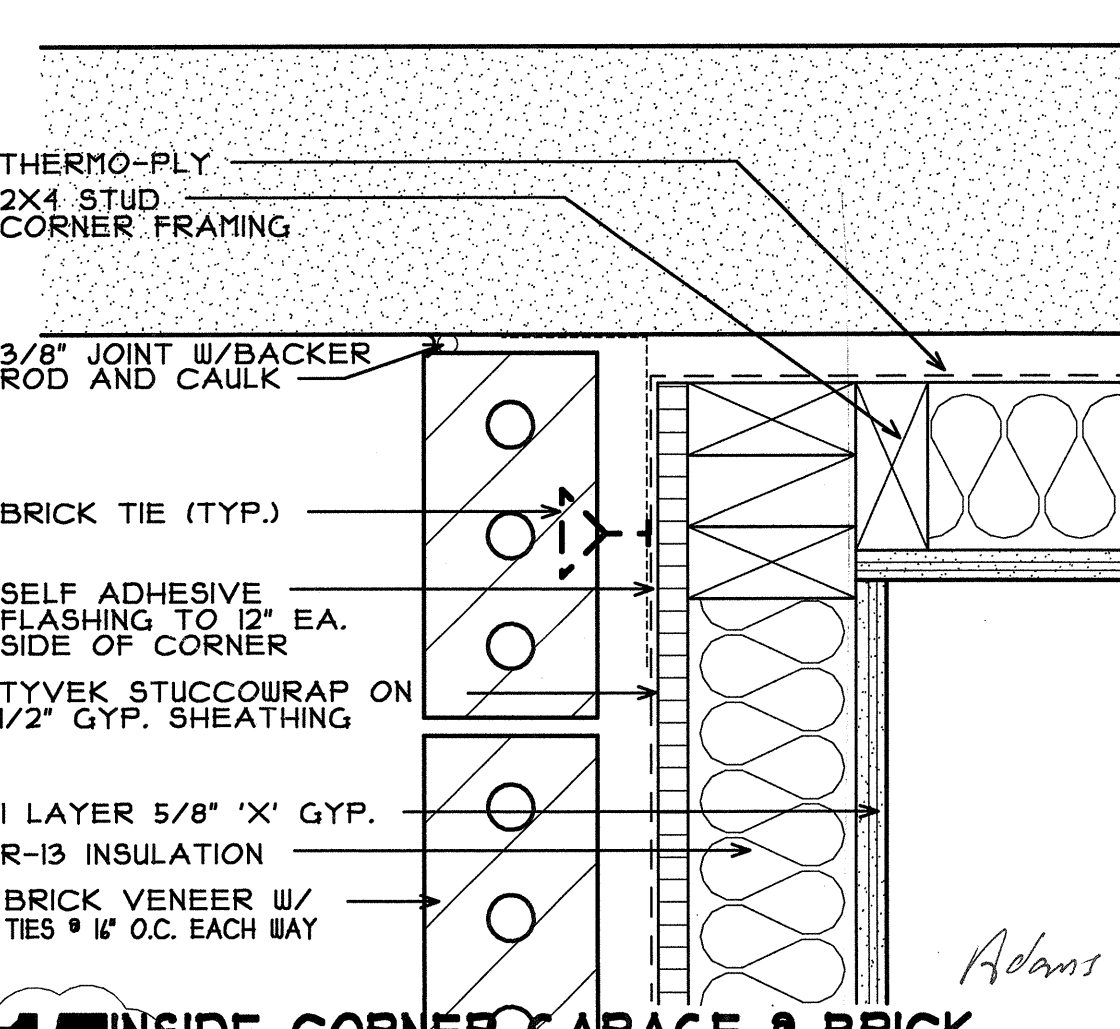


15 INSIDE CORNER GARAGE BRICK

SCALE: 3"=1'-0"

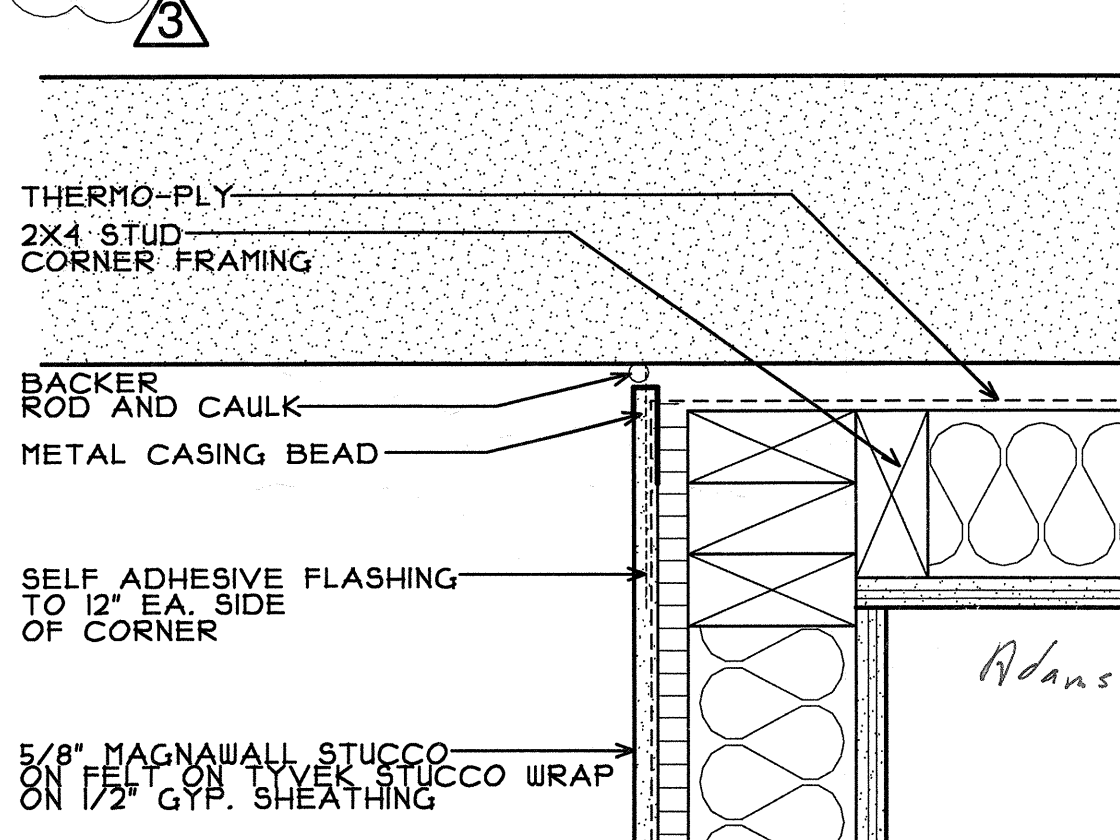

16 INSIDE CORNER GARAGE STUCCO

SCALE: 3"=1'-0"

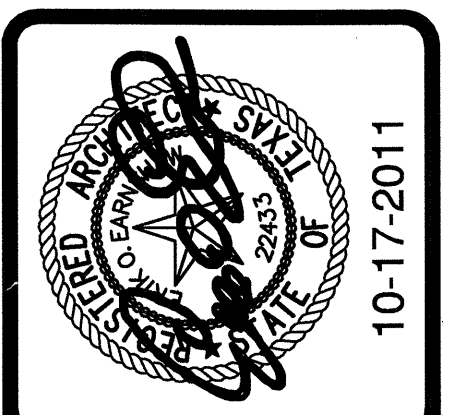

REVISIONS
COORDINATION
10-17-2011

KELLER SPRINGS LOFTS
LOFT APARTMENTS IN ADDISON, TEXAS

CONSTRUCTION ISSUE
10-17-2011

BGO architects
4144 N. Central Exp.
Suite 855
Dallas, TX 75204
214.520.8878
bgoarchitects.com

DATE
08-05-2011

PROJECT
11129

SHEET NUMBER

8.5
DETAILS

COPYRIGHT © Bealer Owens Architects All Rights Reserved