



# CLUB DOOR SCHEDULE

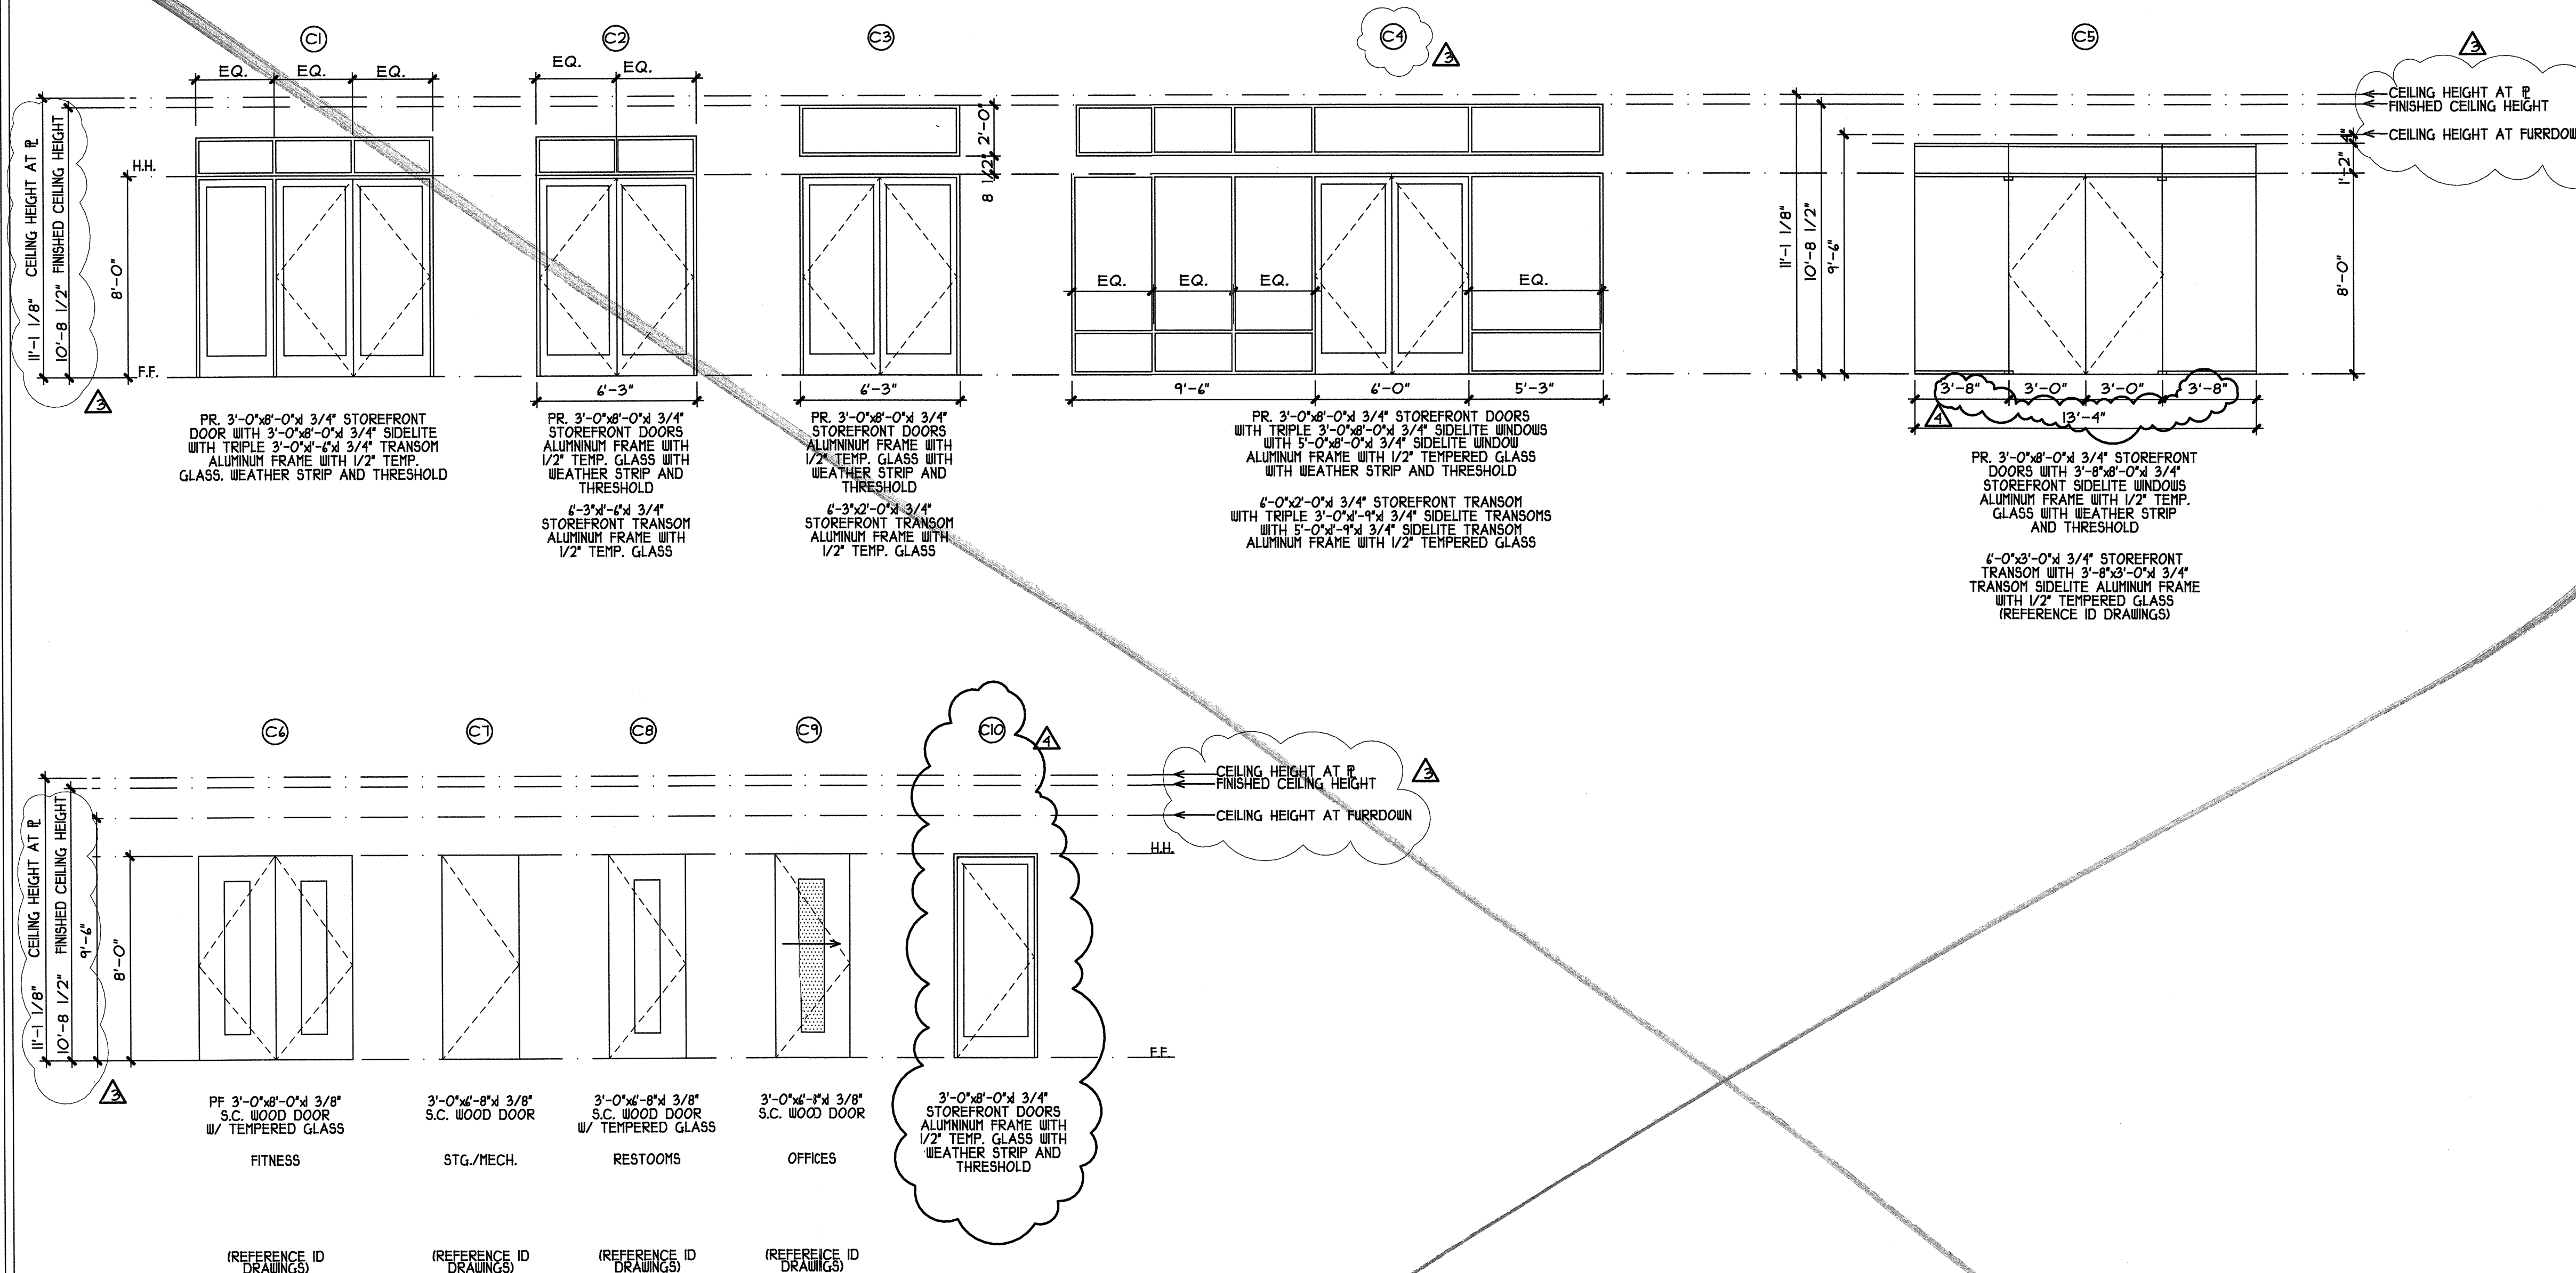

# CLUB WINDOW/TRANSOM SCHEDULE

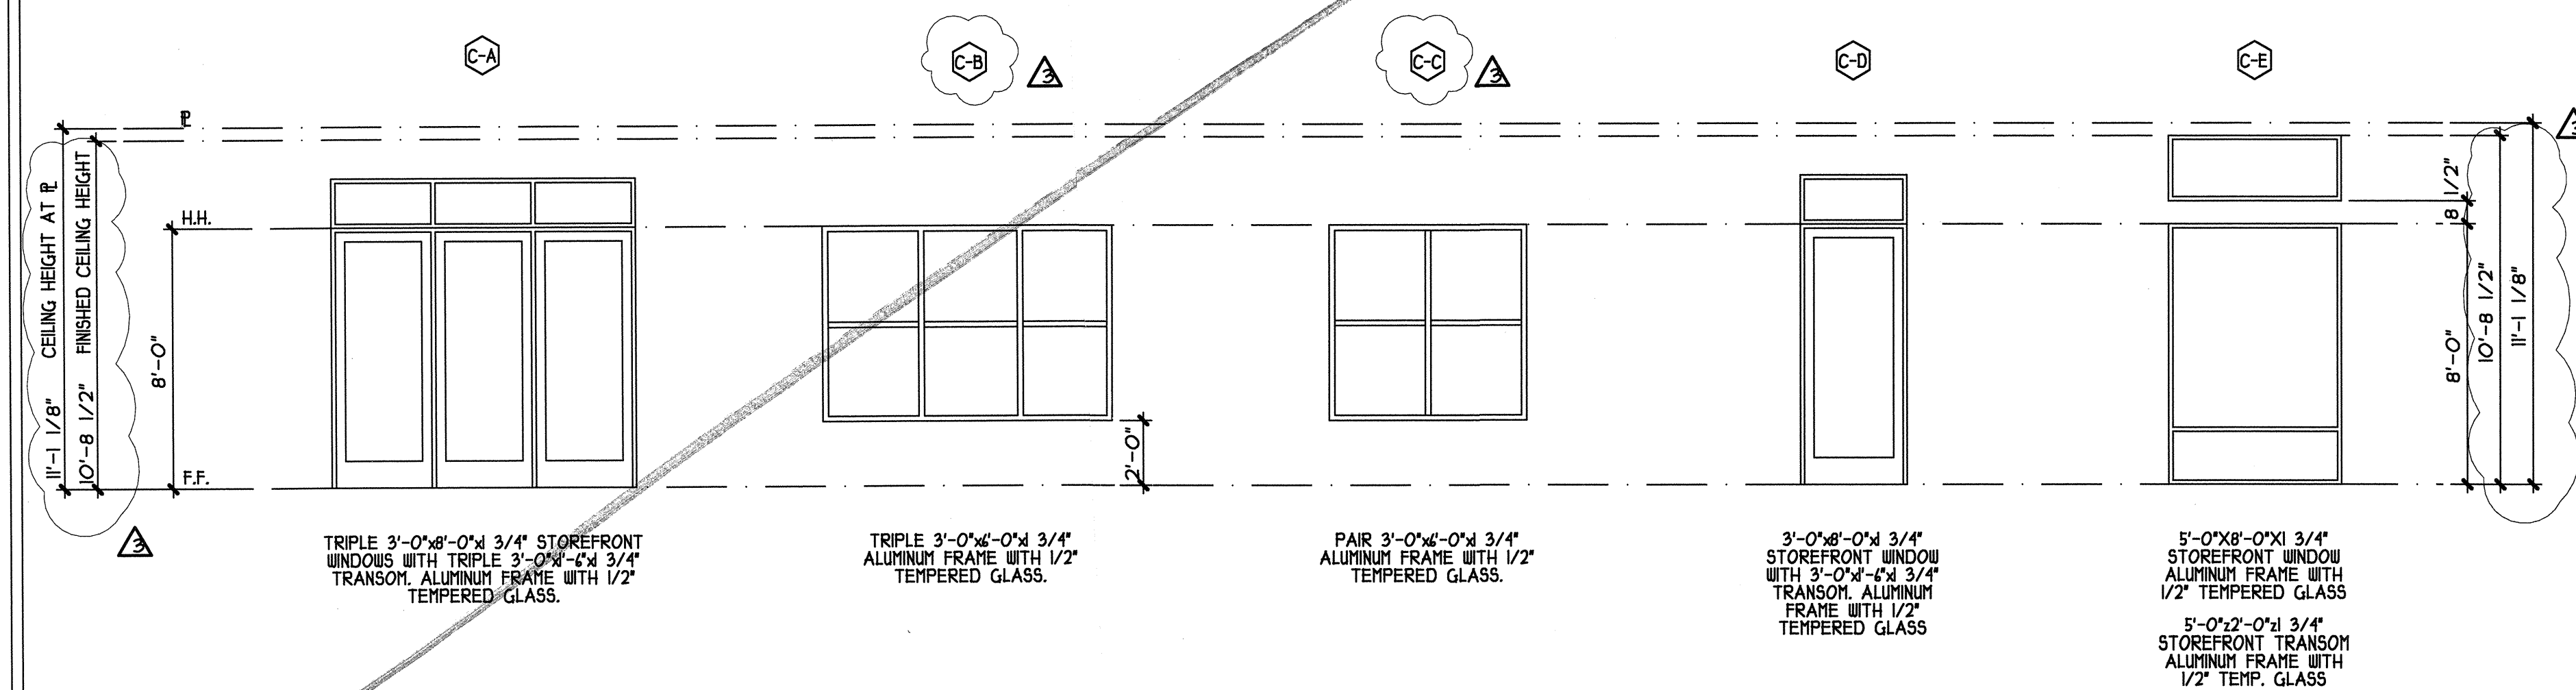

## WINDOW NOTES:

### GENERAL NOTES:

ASTERISK (\*) ON UNIT PLAN DENOTES REQUIRED LOCATIONS FOR TEMPERED GLAZING

TEMPERED GLAZING LOCATION REQUIREMENTS:  
PER 2009 IBC SECTION 2406.4

- GLAZING IN SWINGING DOORS EXCEPT JALOUSIES AND PANELS IN SLIDING AND BIFOLD CLOSET DOOR ASSEMBLIES
  - GLAZING IN FIXED AND SLIDING PANELS OF SLIDING DOOR ASSEMBLIES AND PANELS IN SLIDING AND BIFOLD CLOSET DOOR ASSEMBLIES
  - GLAZING IN STORM DOORS
  - GLAZING IN UNFRAMED SWINGING DOORS
  - GLAZING IN DOORS AND ENCLOSURES FOR HOT TUBS, WHIRLPOOLS, SAUNAS, STEAM ROOMS, BATHTUBS, AND SHOWERS. GLAZING IN ANY PORTION OF A BUILDING WALL ENCLOSING THESE COMPARTMENTS WHERE THE BOTTOM EXPOSED EDGE OF THE GLAZING IS LESS THAN 60 INCHES (1524 MM) ABOVE A STANDING SURFACE.
  - GLAZING IN AN INDIVIDUAL FIXED OR OPERABLE PANEL ADJACENT TO A DOOR WHERE THE NEAREST EXPOSED EDGE OF THE GLAZING IS WITHIN A 24-INCH (610 MM) ARCH OF EITHER VERTICAL EDGE OF THE DOOR IN A CLOSED POSITION AND WHERE THE BOTTOM EXPOSED EDGE OF THE GLAZING IS LESS THAN 60 INCHES (1524 MM) ABOVE THE WALKING SURFACE.
- EXCEPTION:
- PANELS WHERE THERE IS AN INTERVENING WALL OR OTHER PERMANENT BARRIER BETWEEN THE DOOR AND GLAZING.
  - WHERE ACCESS THROUGH THE DOOR IS TO A CLOSET OR STORAGE AREA 3 FEET (914 MM) OR LESS IN DEPTH, GLAZING IN THIS APPLICATION SHALL COMPLY WITH SECTION 2406.3, ITEM 7.
  - GLAZING IN WALLS PERPENDICULAR TO THE PLANE OF THE DOOR IN A CLOSED POSITION OTHER THAN THE WALL TOWARDS WHICH THE DOOR SWINGS WHEN OPENED, IN ONE- AND TWO-FAMILY DWELLINGS OR WITHIN DWELLING UNITS IN GROUP R-2.
- GLAZING IN AN INDIVIDUAL FIXED OR OPERABLE PANEL OTHER THAN IN THOSE LOCATIONS DESCRIBED IN PRECEDING ITEMS 5 AND 6, WHICH MEETS ALL OF THE FOLLOWING CONDITIONS:
    - EXPOSED AREA OF AN INDIVIDUAL PANE GREATER THAN 9 SQUARE FEET (0.84 M<sup>2</sup>);
    - EXPOSED BOTTOM EDGE LESS THAN 18 INCHES (457 MM) ABOVE THE FLOOR;
    - EXPOSED TOP EDGE GREATER THAN 36 INCHES (914 MM) ABOVE THE FLOOR; AND
    - ONE OR MORE WALKING SURFACE(S) WITHIN 36 INCHES (914 MM) HORIZONTALLY OF THE PLANE OF THE GLAZING.

- EXCEPTION: SAFETY GLAZING FOR ITEM 7 IS NOT REQUIRED FOR THE FOLLOWING INSTALLATIONS:
- A PROTECTIVE BAR 1 1/2 INCHES (38 MM) OR MORE IN HEIGHT, CAPABLE OF WITHSTANDING A HORIZONTAL LOAD OF 50 POUNDS (227 N) WITHOUT CONTACTING THE GLASS, IS INSTALLED ON THE ACCESSIBLE SIDES OF THE GLAZING 34 INCHES TO 38 INCHES (864 TO 965 MM) ABOVE THE FLOOR.
  - THE OUTBOARD PANE IN INSULATED GLASS UNITS OR MULTIPLE GLAZING WHERE THE BOTTOM EXPOSED EDGE OF THE GLASS IS 25 FEET (7620 MM) OR MORE ABOVE ANY GRADE, ROOF, WALKING SURFACE OR OTHER HORIZONTAL OR SLOPED (WITHIN 45 DEGREES OF HORIZONTAL) (0.78 RAD) SURFACE ADJACENT TO THE GLASS EXTERIOR.
  - GLAZING IN GUARDS AND RAILINGS, INCLUDING STRUCTURAL BALUSTER PANELS AND NONSTRUCTURAL IN-FILL PANELS, REGARDLESS OF AREA OR HEIGHT ABOVE A WALKING SURFACE
  - GLAZING IN WALLS AND FENCES ENCLOSING INDOOR AND OUTDOOR SWIMMING POOLS, HOT TUBS AND SPAS WHERE ALL OF THE FOLLOWING CONDITIONS ARE PRESENT:
    - THE BOTTOM EDGE OF THE GLAZING ON THE POOL OR SPA SIDE IS LESS THAN 60 INCHES (1524 MM) ABOVE A WALKING SURFACE ON THE POOL OR SPA SIDE OF THE GLAZING; AND
    - THE GLAZING IS WITHIN 60 INCHES (1524 MM) HORIZONTAL OF THE WATER'S EDGE OF A SWIMMING POOL OR SPA.
  - GLAZING ADJACENT TO STAIRWAYS, LANDINGS AND RAMPS WITHIN 36 INCHES (914 MM) HORIZONTALLY OF A WALKING SURFACE WHEN THE EXPOSED SURFACE OF THE GLASS IS LESS THAN 60 INCHES (1524 MM) ABOVE THE PLANE OF THE ADJACENT WALKING SURFACE.
  - GLAZING ADJACENT TO STAIRWAYS WITHIN 60 INCHES (1524 MM) HORIZONTALLY OF THE BOTTOM TREAD OF A STAIRWAY IN ANY DIRECTION WHEN THE EXPOSED SURFACE OF THE GLASS IS LESS THAN 60 INCHES (1524 MM) ABOVE THE NOSE OF THE TREAD.
- EXCEPTION: SAFETY GLAZING FOR ITEM 10 OR 11 IS NOT REQUIRED FOR THE FOLLOWING INSTALLATIONS WHERE:
- THE SIDE OF A STAIRWAY, LANDING OR RAMP WHICH HAS A GUARDRAIL OR HANDRAIL, INCLUDING BALUSTERS OR IN-FILL PANELS, COMPLYING WITH THE PROVISIONS OF SECTIONS 1013 AND 1607.7; AND
  - THE PLANE OF THE GLASS IS GREATER THEN 18 INCHES (457 MM) FROM THE RAILING.



02-13-2012

REVISIONS
COORDINATION 10-11-2011
COORDINATION 02-13-2012

**KELLER SPRINGS LOFTS**  
LOFT APARTMENTS IN ADDISON, TEXAS

CONSTRUCTION ISSUE  
10-17-2011



4144 N. Central Expy.  
Suite 855  
Dallas, TX 75204  
214.520.8878  
bgoarchitects.com

DATE

08-05-2011

PROJECT

11129

SHEET NUMBER

**9.0**  
**CLUB SCHEDULE**

COPYRIGHT © Beiler Guest Owens Architects ALL RIGHTS RESERVED