


Kimley-Horn
and Associates, Inc.

2700 Red Cross Drive, Suite 300
Dallas, TX 75208-1918 972-770-8000
Firm No. 98

No.	Revision	Date
1	REVISED DRIVE APPROACH SPEC	8/26/11
2	ADDED SIDEWALK REFERENCE AND REVISED FIRE LANE	9/14/11

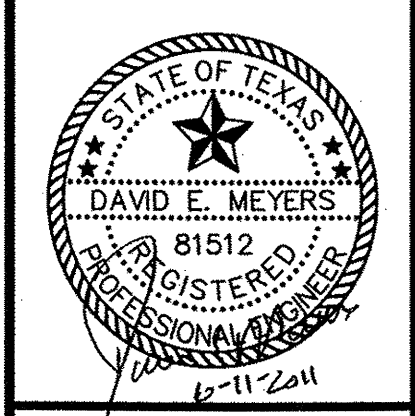

Keller Springs Lofts
Loft Apartments in Addison
Town of Addison, Texas

PAVING PLAN

DATE: OCTOBER 11, 2011
DESIGN: KHA
DRAWN: KHA
CHECKED: KHA
KHA NO.: 064362003
CITY NO.:

SHEET
C4a

LEGEND

- 6" 4200 PSI REINFORCED CONCRETE PAVEMENT ON 6" LIME STABILIZED SUBGRADE, 28 LBS/SY COMPACTED TO A MINIMUM 95% STANDARD PROCTOR DENSITY AT 0% TO 3% OF OPTIMUM MOISTURE.
- 8" 4500 PSI REINFORCED CONCRETE PAVEMENT ON 6" LIME STABILIZED SUBGRADE, 28 LBS/SY COMPACTED TO A MINIMUM 95% STANDARD PROCTOR DENSITY AT 0% TO 3% OF OPTIMUM MOISTURE.
- PROPOSED SIDEWALK REFER TO LANDSCAPE PLAN FOR LOCATION AND DETAILS

BENCH MARKS:

BMS SQUARE CUT ON INLET, SOUTHWEST CORNER OF RATLIFF LANE AND ADDISON ROAD.
ELEVATION 637.20

BMS SQUARE CUT ON INLET, SOUTHWEST CORNER OF AIRPORT PKWY. AND QUORUM DRIVE.
ELEVATION 631.15

BMS BRASS DISK FOUND AT NORTHWEST CORNER OF INLET, SOUTHWEST CORNER OF KELLER SPRINGS AND ADDISON ROAD.
ELEVATION 638.91

NOTES:

- REFER TO DIMENSION CONTROL PLAN FOR PAVING DIMENSIONS AND CENTERLINE CONTROL.
- REFERENCE GENERAL NOTES FOR ADDITIONAL PLAN NOTES
- BARRIER FREE RAMPS AND SIDEWALKS SHALL BE ADA COMPLIANT AND CONSTRUCTED PER CITY DETAILS.