


CAUTION!!
 EXIST. GAS MAIN IN AREA
 CONTACT TEXAS ONE CALL
 1-800-245-4545
 48 HOURS PRIOR TO
 CONSTRUCTION

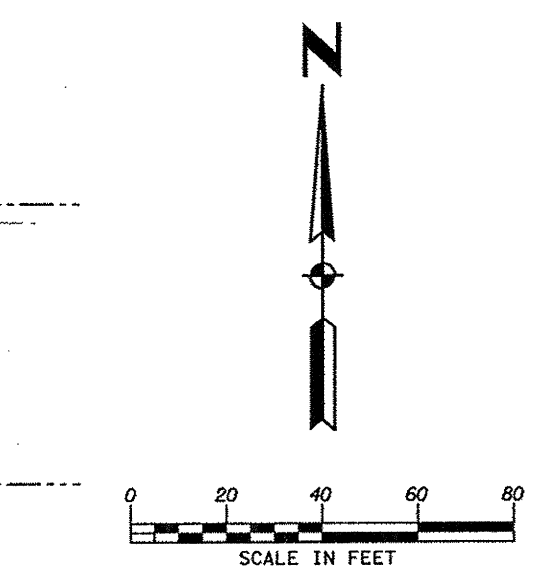

POWER POLE COORDINATES:


POLE#	NORTHING	EASTING
P1	5231.4687	5137.3653
P2	5230.7169	5299.7169
P3	5230.8269	5411.0117
P4	5230.9763	5485.1045
P5	5226.2535	5563.8478
P6	5125.3917	5555.7196
P7	5085.3118	5555.3903
P8	5042.4552	5555.1847
P11	4989.3960	4778.1064
P12	5029.7737	4778.1064
P13	5073.3003	4776.1447
P14	5132.3670	4771.4433

NOTE:
 THIS PLAN IS FOR INFORMATION ONLY. SEE ELECTRICAL SITE PLAN PROVIDED BY JORDAN & SKALA AND SCHEMATIC DESIGN PROVIDED BY ONCOR FOR ELECTRICAL DESIGN INCLUDING PRIMARIES AND METER BANK LOCATIONS.

BENCH MARKS:
 BM5
 SQUARE CUT ON INLET, SOUTHWEST CORNER OF RATLIFF LANE AND ADDISON ROAD.
 ELEVATION 637.20
 BM8
 SQUARE CUT ON INLET, SOUTHWEST CORNER OF AIRPORT PKWY. AND QUORUM DRIVE.
 ELEVATION 631.15
 BM1
 BRASS DISK FOUND AT NORTHWEST CORNER OF INLET, SOUTHWEST CORNER OF KELLER SPRINGS AND ADDISON ROAD.
 ELEVATION 638.91

Kimley-Horn and Associates, Inc.
 1700 W. CAMP PINE, SUITE 300
 DALLAS, TEXAS 75241
 TEL: 972-241-8800
 FAX: 972-241-8800

No.	Revision	Date
1	REVISED TRANSFORMERS AND POWER POLE LAYOUTS	9/19/11
2	REMOVED POWER POLES AND ADDED TRANSFORMERS	2/6/12

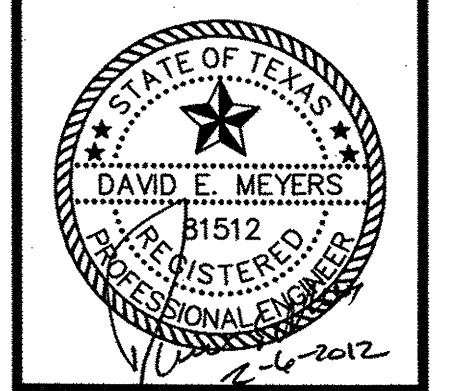

Keller Springs Lofts
 Loft Apartments in Addison
 Town of Addison, Texas

ELECTRICAL SITE PLAN

DATE: FEBRUARY 6, 2012
 DESIGN: KHA
 DRAWN: KHA
 CHECKED: KHA
 KHA NO: 064362003
 CITY NO: