


Kimley-Horn and Associates, Inc.

6700 Park Central Drive, Suite 300
Dallas, TX 75248-6968 972-770-8000
www.kimley-horn.com

NO.	REVISION	DATE
1	REVISED TOWN DETAILS	8/26/11
2	REVISED TYPE B CURB INLET PROTECTION DETAIL	9/19/11

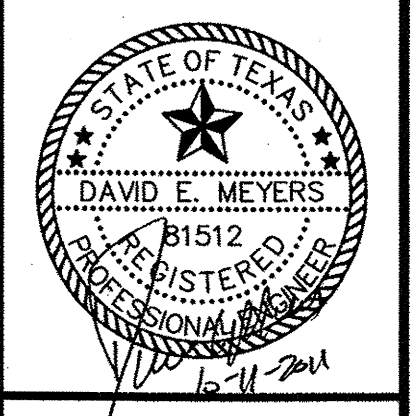

Keller Springs Lofts
Loft Apartments in Addison
Town of Addison, Texas

POLLUTION CONTROL PLAN

DATE: OCTOBER 11, 2011
DESIGN: KHA
DRAWN: KHA
CHECKED: KHA
KHA NO.: 064362003
CITY NO.:

SHEET
C11a