


NOTES:
 1. REPAIRS SHALL EXTEND TO 1' BEYOND EACH SIDE OF TRENCH (Bd).
 2. REINFORCEMENT CHAIRS OR APPROVED DEVICE SHALL BE USED.
 3. REPAIRS SHALL MATCH EXISTING GRADE.


UTILITY INSTALLATION BENEATH CONCRETE ROAD SURFACE
 STANDARD CONSTRUCTION DETAILS UTILITIES TRENCHLINE & STREET RESTORATION
 DATE: AUGUST, 2010 REV DATE: SHEET: SD-101

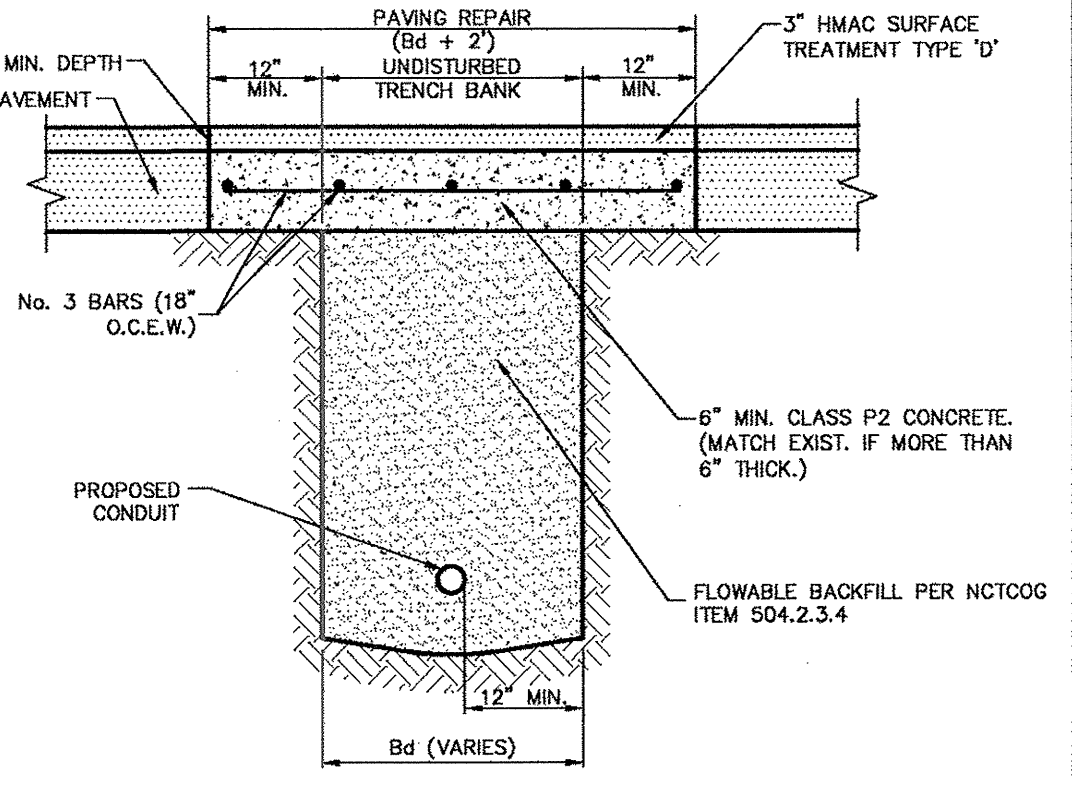

NOTES:
 1. REPAIR SHALL EXTEND TO 1' BEYOND EACH SIDE OF TRENCH (Bd).
 2. REPAIRS SHALL MATCH EXISTING GRADE.


UTILITY INSTALLATION BENEATH ASPHALT ROAD SURFACE
 NTS

UTILITY INSTALLATION BENEATH ASPHALT ROAD SURFACE
 STANDARD CONSTRUCTION DETAILS UTILITIES TRENCHLINE & STREET RESTORATION
 DATE: AUGUST, 2010 REV DATE: SHEET: SD-102

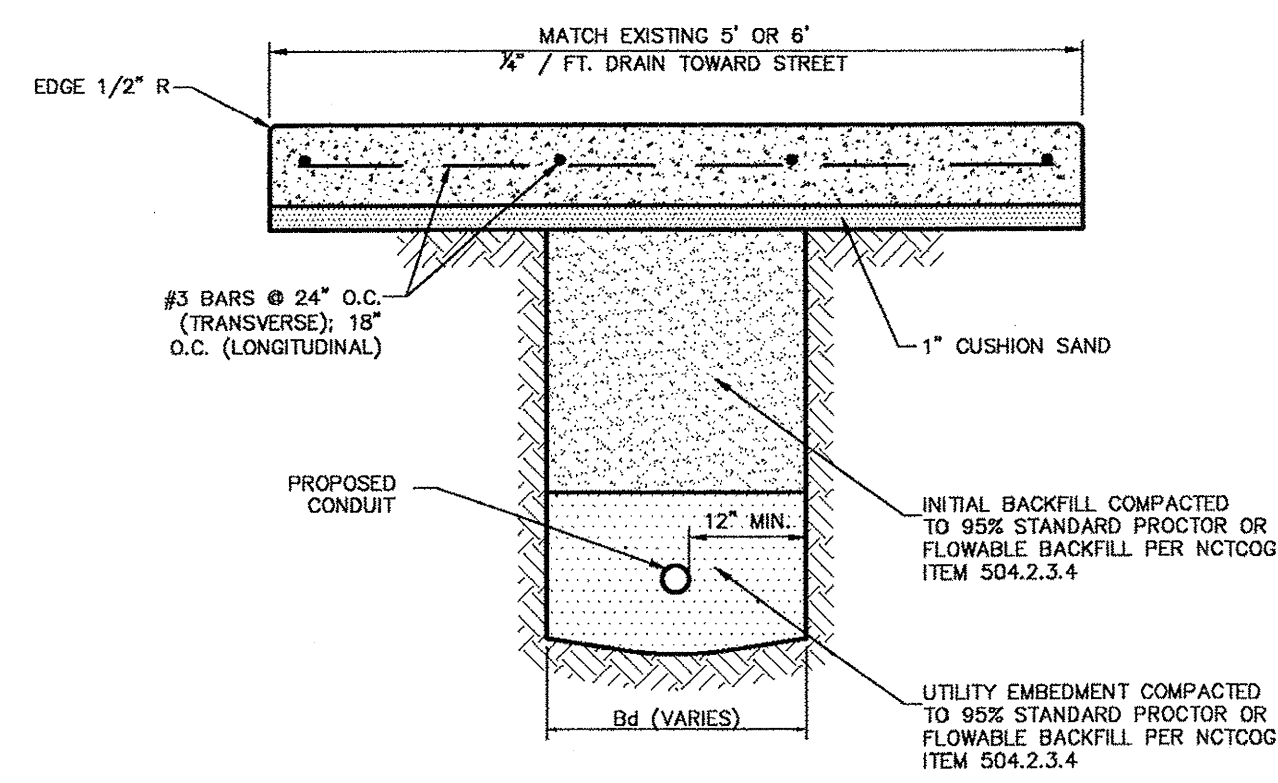

NOTES:
 1. REPAIRS SHALL INCLUDE FULL PANELS FROM JOINT TO JOINT, AND ANY ADJACENT DAMAGED PANELS INDEPENDENT OF Bd.
 2. REINFORCEMENT CHAIRS OR APPROVED DEVICE SHALL BE USED.
 3. SEE CONCRETE SIDEWALK STANDARD DETAIL FOR SIDEWALK JOINT DETAIL.
 4. ALL DISTURBED AREAS SHALL BE SODDED (UNLESS OTHERWISE APPROVED).
 5. BACKFILL AND EMBEDMENT PARTICLE SIZE SHALL NOT EXCEED 3" IN ANY DIRECTION.
 6. CONNECT TO EXISTING SIDEWALK WITH BARS MATCHING EXISTING INSTALLATION.


UTILITY INSTALLATION BENEATH SIDEWALK
 STANDARD CONSTRUCTION DETAILS UTILITIES TRENCHLINE & STREET RESTORATION
 DATE: AUGUST, 2010 REV DATE: SHEET: SD-103

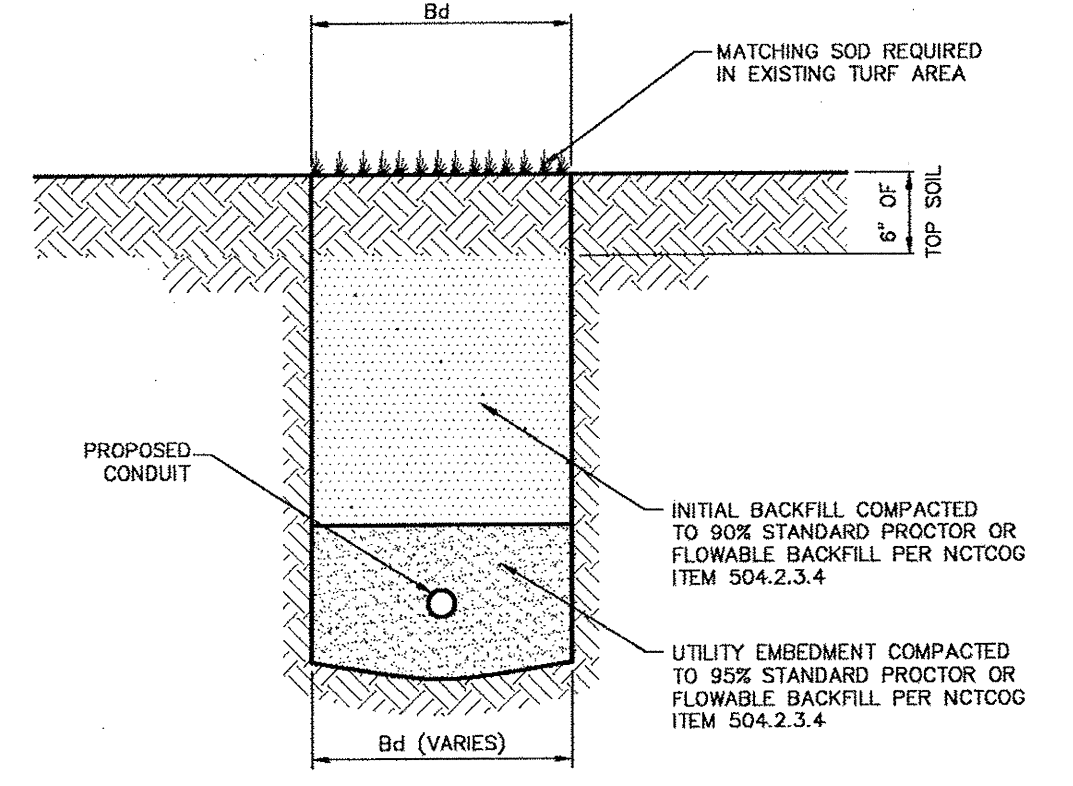

NOTES:
 1. ALL DISTURBED AREAS SHALL BE SODDED (UNLESS OTHERWISE APPROVED).
 2. BACKFILL AND EMBEDMENT PARTICLE SIZE SHALL NOT EXCEED 3" IN ANY DIRECTION.


UTILITY INSTALLATION WITHIN TURF AREAS
 NTS

UTILITY INSTALLATION WITHIN TURF AREAS
 STANDARD CONSTRUCTION DETAILS UTILITIES TRENCHLINE & STREET RESTORATION
 DATE: AUGUST, 2010 REV DATE: SHEET: SD-104

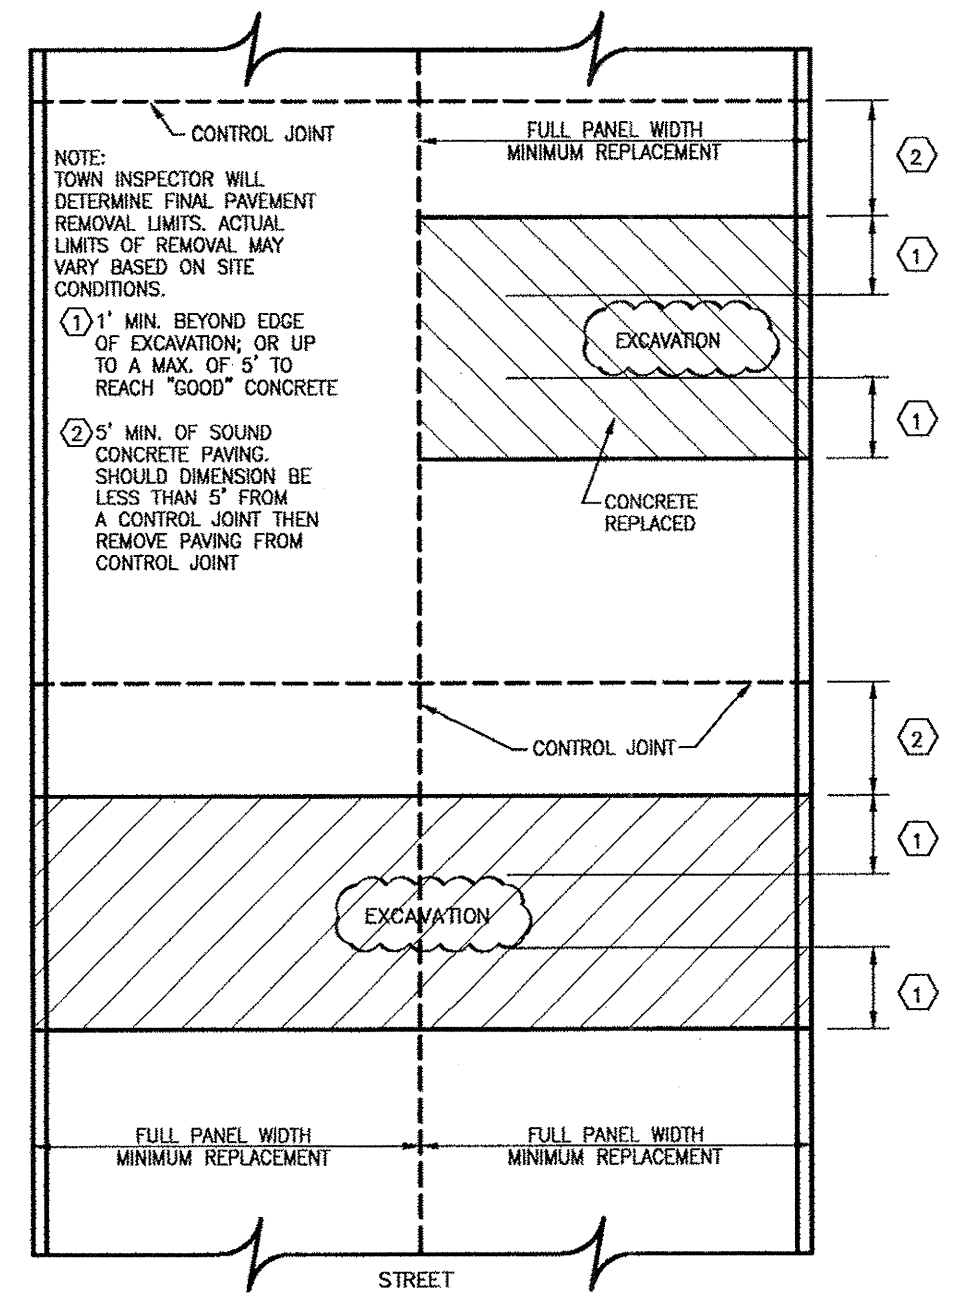


TYPICAL CONCRETE STREET REMOVAL/REPLACEMENT EXAMPLE 1

STREET CUT REPAIRS EXAMPLE 1
 STANDARD CONSTRUCTION DETAILS UTILITIES TRENCHLINE & STREET RESTORATION
 DATE: AUGUST, 2010 REV DATE: SHEET: SD-105

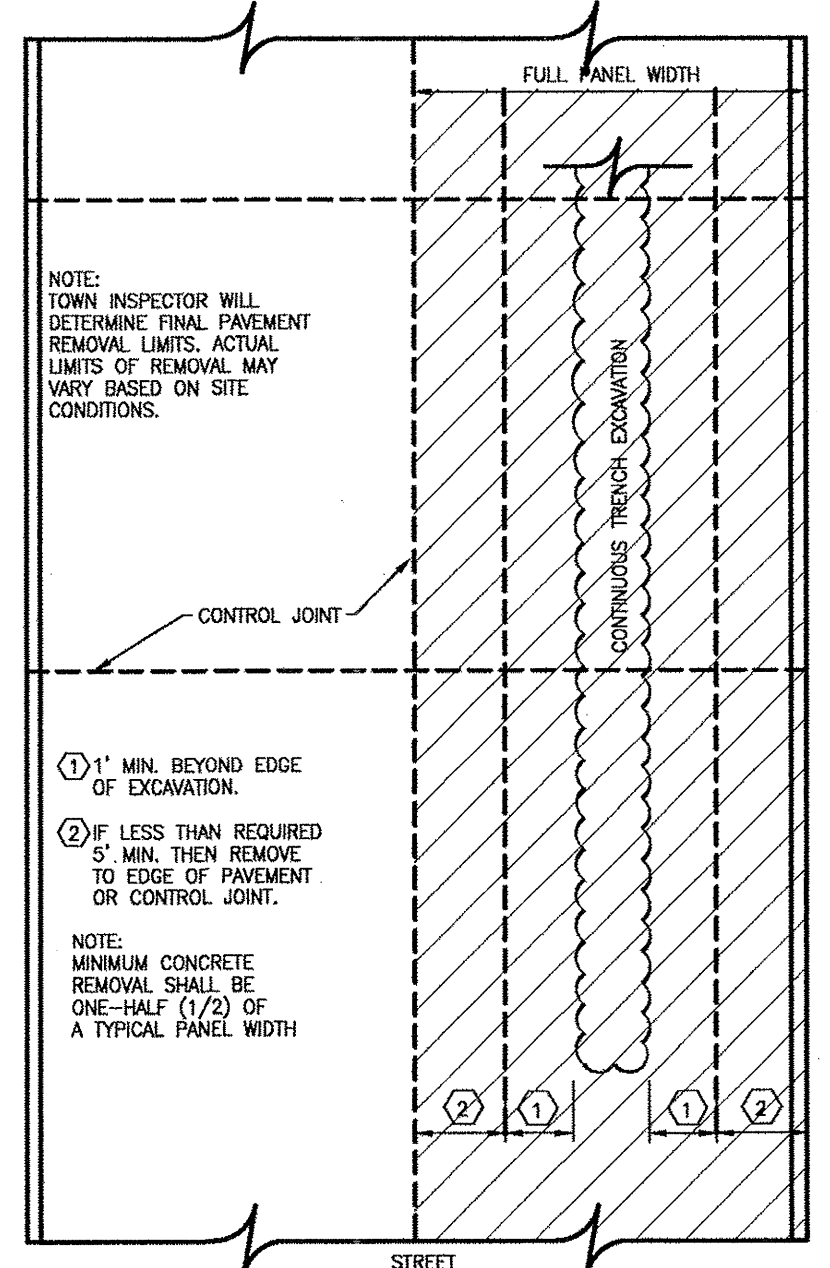


TYPICAL CONCRETE STREET REMOVAL/REPLACEMENT EXAMPLE 2

STREET CUT REPAIRS EXAMPLE 2
 STANDARD CONSTRUCTION DETAILS UTILITIES TRENCHLINE & STREET RESTORATION
 DATE: AUGUST, 2010 REV DATE: SHEET: SD-106

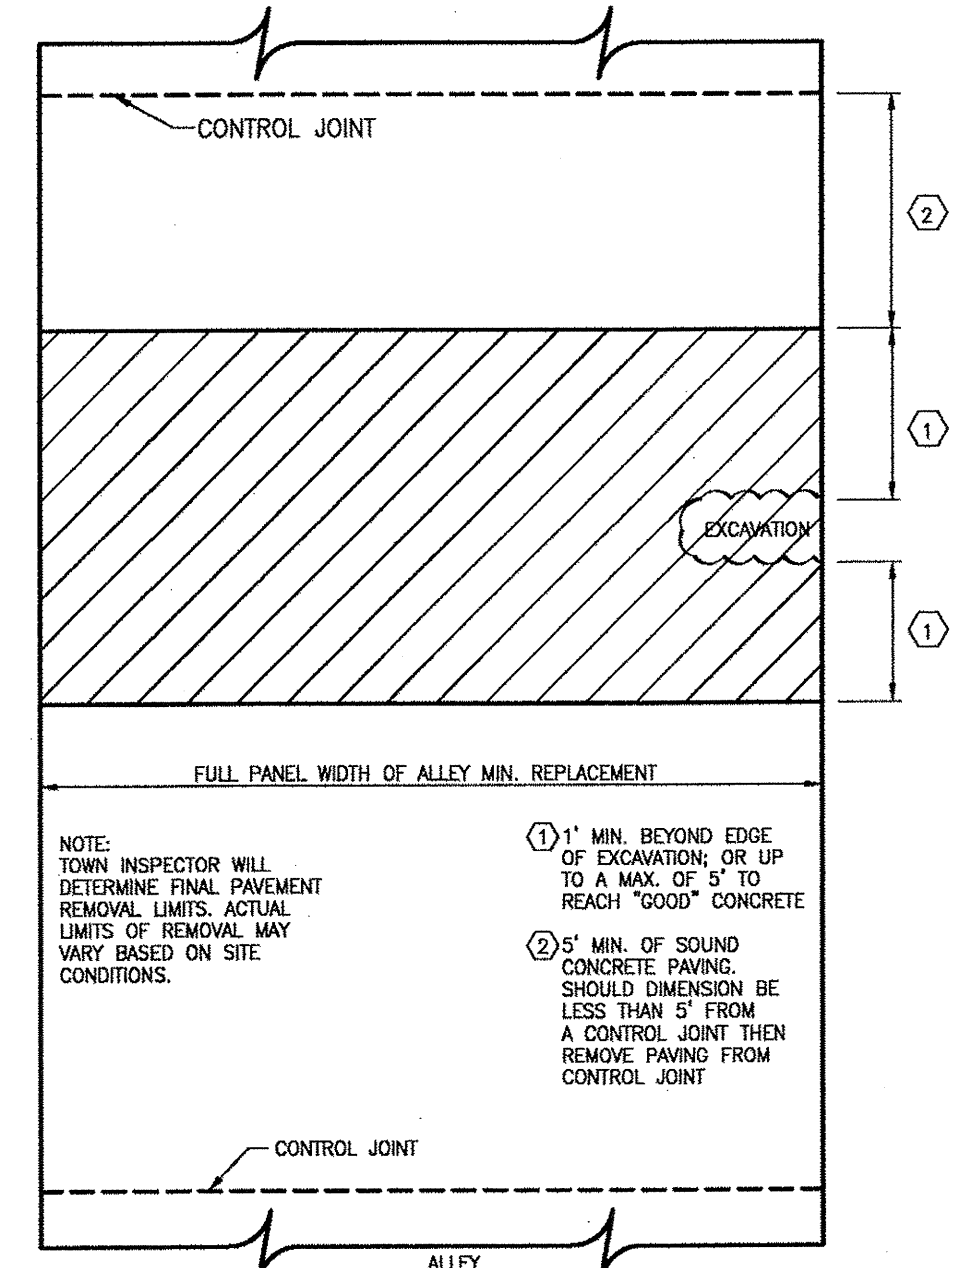

TYPICAL CONCRETE ALLEY REMOVAL/REPLACEMENT EXAMPLE 3


STREET CUT REPAIRS EXAMPLE 3
 STANDARD CONSTRUCTION DETAILS UTILITIES TRENCHLINE & STREET RESTORATION
 DATE: AUGUST, 2010 REV DATE: SHEET: SD-107

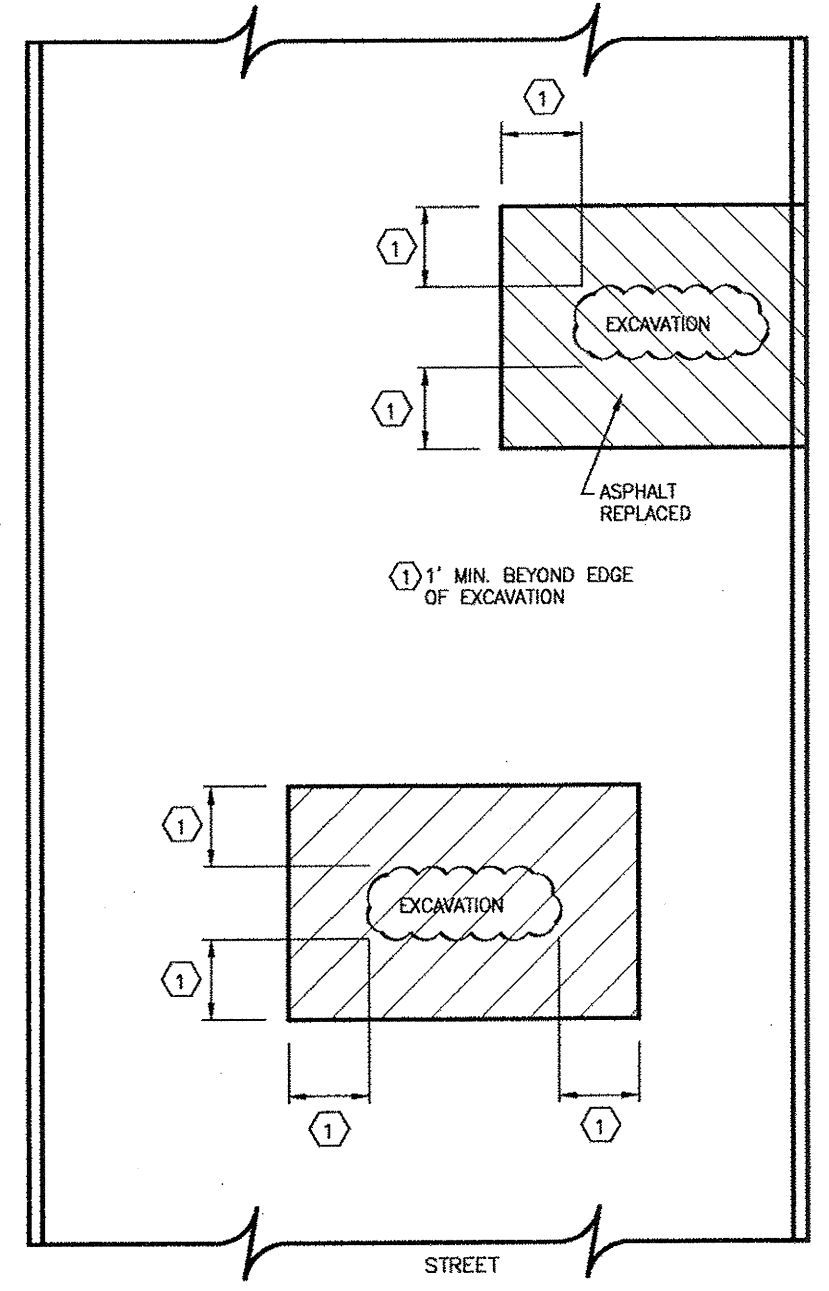

TYPICAL ASPHALT STREET REMOVAL/REPLACEMENT EXAMPLE 4

STREET CUT REPAIRS EXAMPLE 4
 STANDARD CONSTRUCTION DETAILS UTILITIES TRENCHLINE & STREET RESTORATION
 DATE: AUGUST, 2010 REV DATE: SHEET: SD-108

Kimley-Horn and Associates, Inc.
 1700 Ross Street, Suite 800
 Dallas, TX 75201-9818 (972) 770-8000
 Fax: 972-770-8282

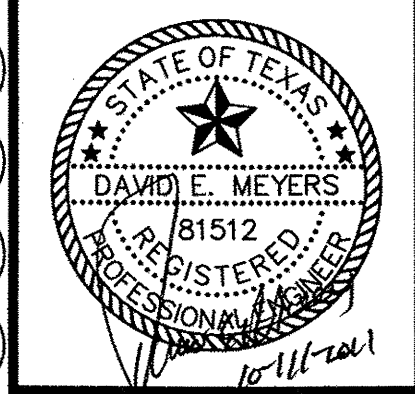

**Keller Springs Lofts
 Loft Apartments in Addison**
 Town of Addison, Texas

UTILITY DETAILS

DATE: OCTOBER 11, 2011
 DESIGN: KHA
 DRAWN: KHA
 CHECKED: KHA
 KHA NO.: 064-362003
 CITY NO.:

SHEET