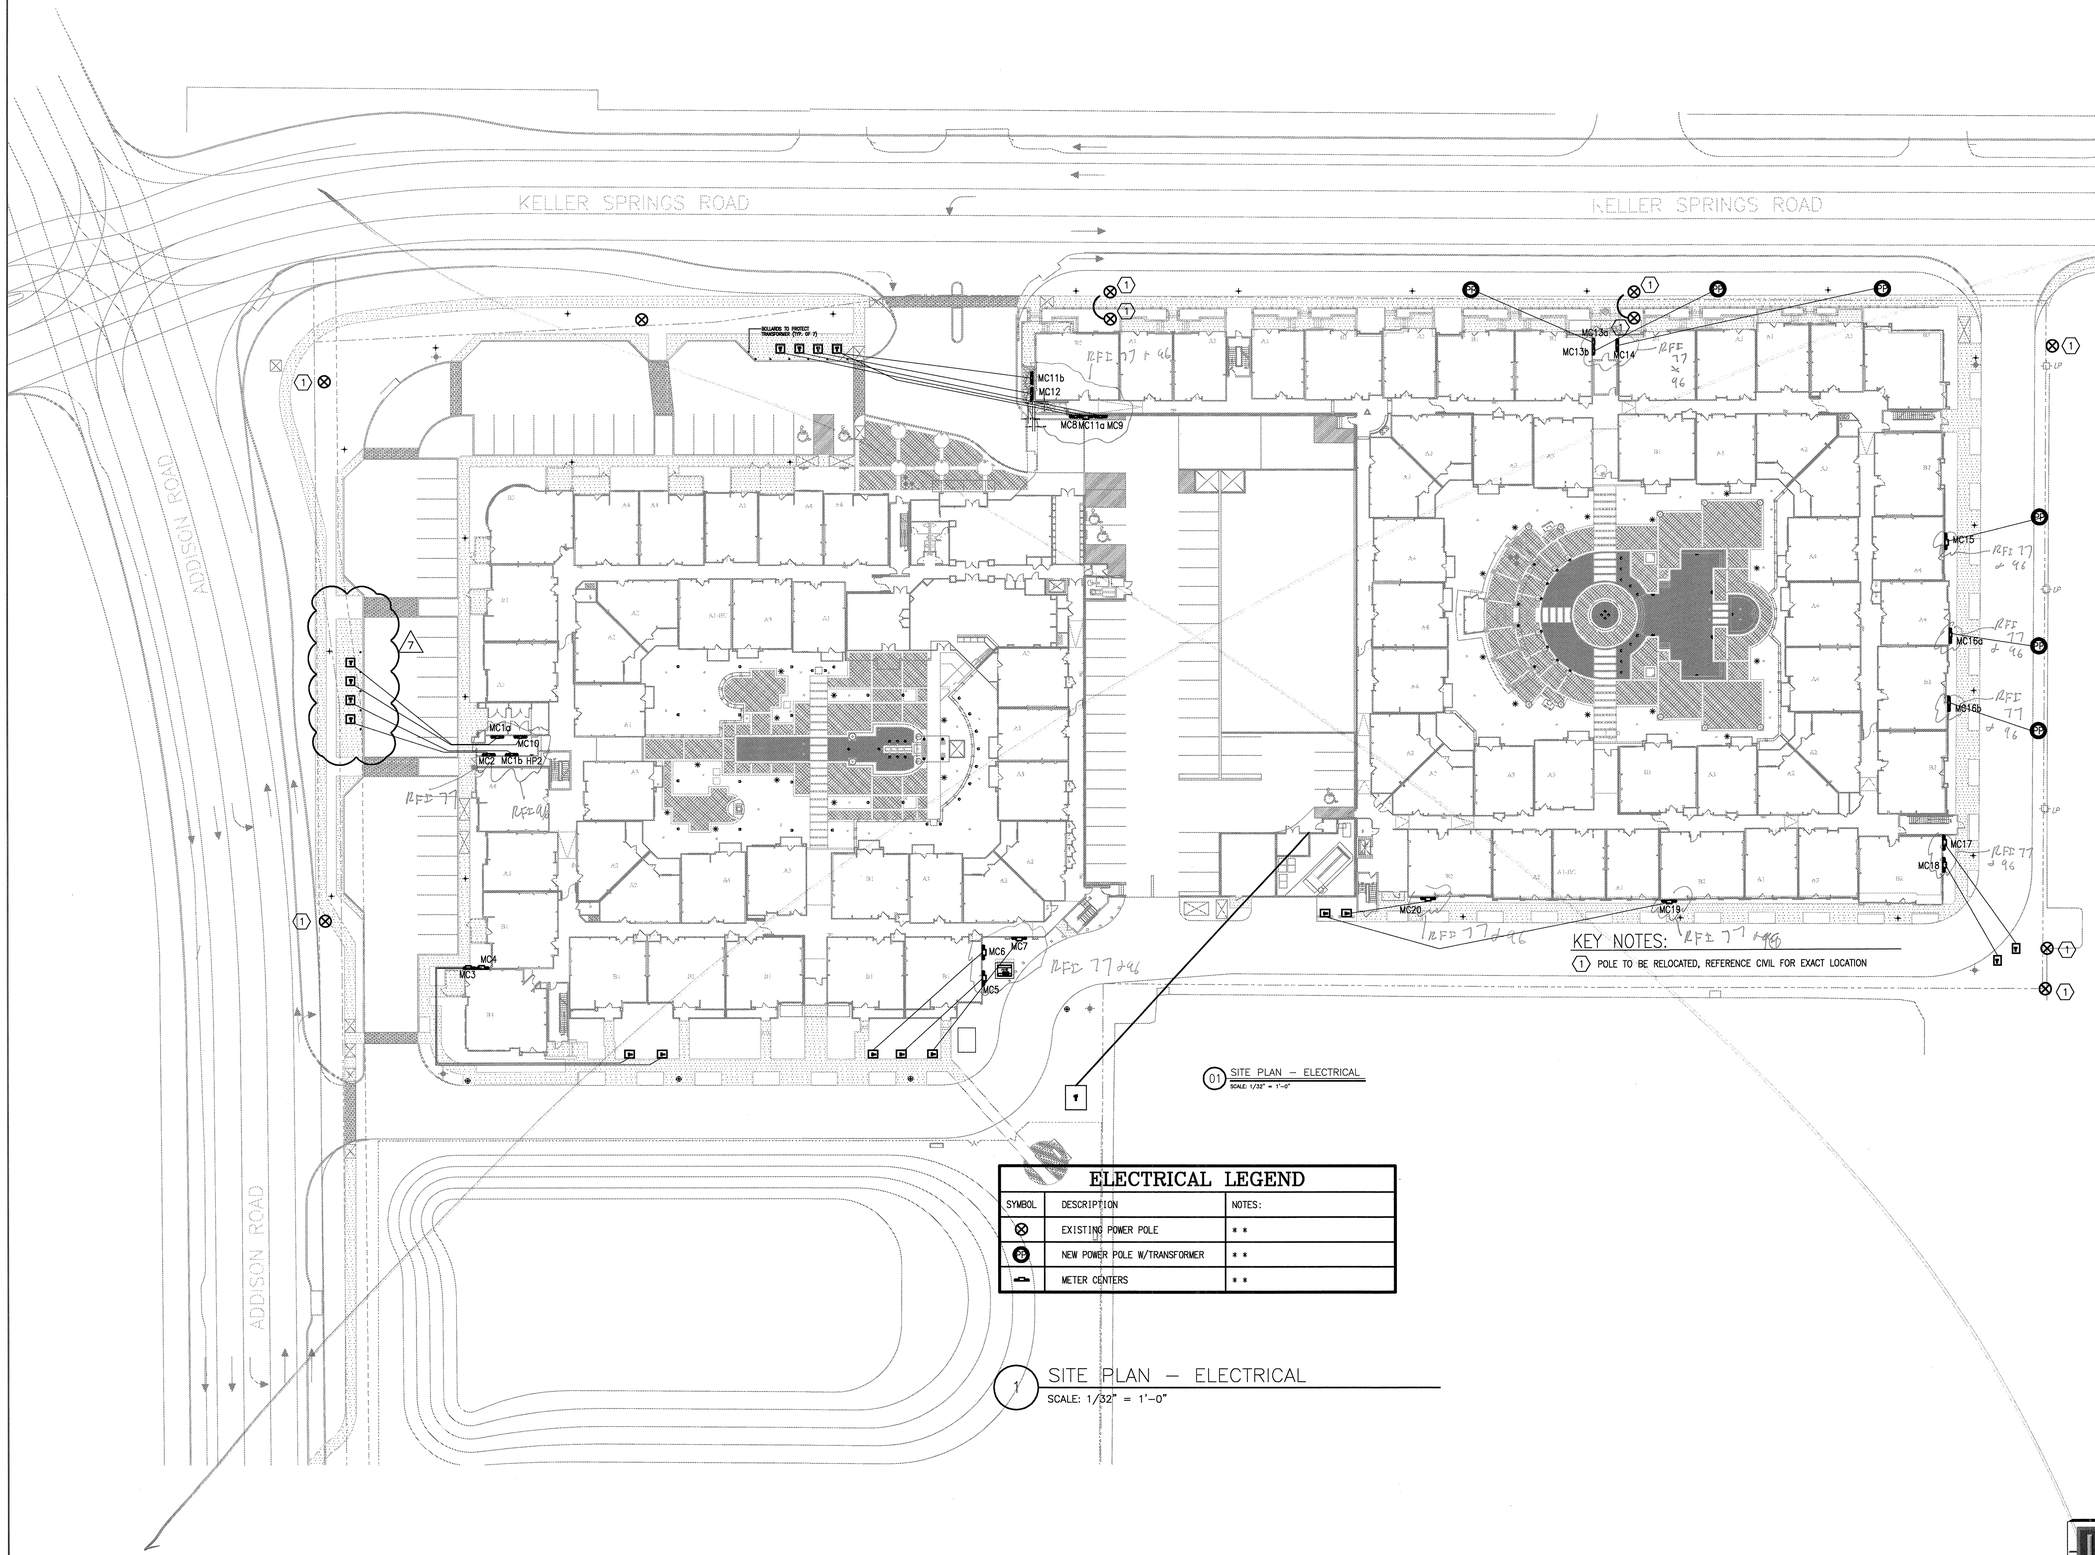

01 SITE PLAN – ELECTRICAL
SCALE: 1/32" = 1'-0"

ELECTRICAL LEGEND		
SYMBOL	DESCRIPTION	NOTES:
⊗	EXISTING POWER POLE	* *
⊗	NEW POWER POLE W/TRANSFORMER	* *
	METER CENTERS	* *

1 SITE PLAN – ELECTRICAL
SCALE: 1/32" = 1'-0"

STATE OF TEXAS
ROSS McFARLAND
108752
LICENSED PROFESSIONAL ENGINEER
1/17/12

REVISIONS

1	9-2-2011	DESIGN REVISIONS
2	9-13-2011	ANSI/FHA COMMENTS
3	9-23-2011	DESIGN REVISIONS
4	10-17-2011	CONSTRUCTION ISSUE
5	12-21-2011	DESIGN REVISIONS
6	1-17-2012	DESIGN REVISIONS
7	2-15-2012	TRANSFORMER REVISIONS

KELLER SPRINGS LOFTS

LOFT APARTMENTS IN ADDISON, TEXAS

BGO architects
4144 N. Central Expy.
Suite 855
Dallas, TX 75204
214.520.8878
bgoarchitects.com

DATE
08-05-11

PROJECT
11129

SHEET NUMBER
E-10.1

SITE PLAN ELECTRICAL

Jordan & Skala Engineers
14240 Midway Road, Suite 350
Dallas, TX 75244-5138
V: (469) 385-1616 F: (469) 385-1615
Project Number - 113-0355
Drawn By: MJ
Texas Firm Registration # F-4990
Checked By: RAD