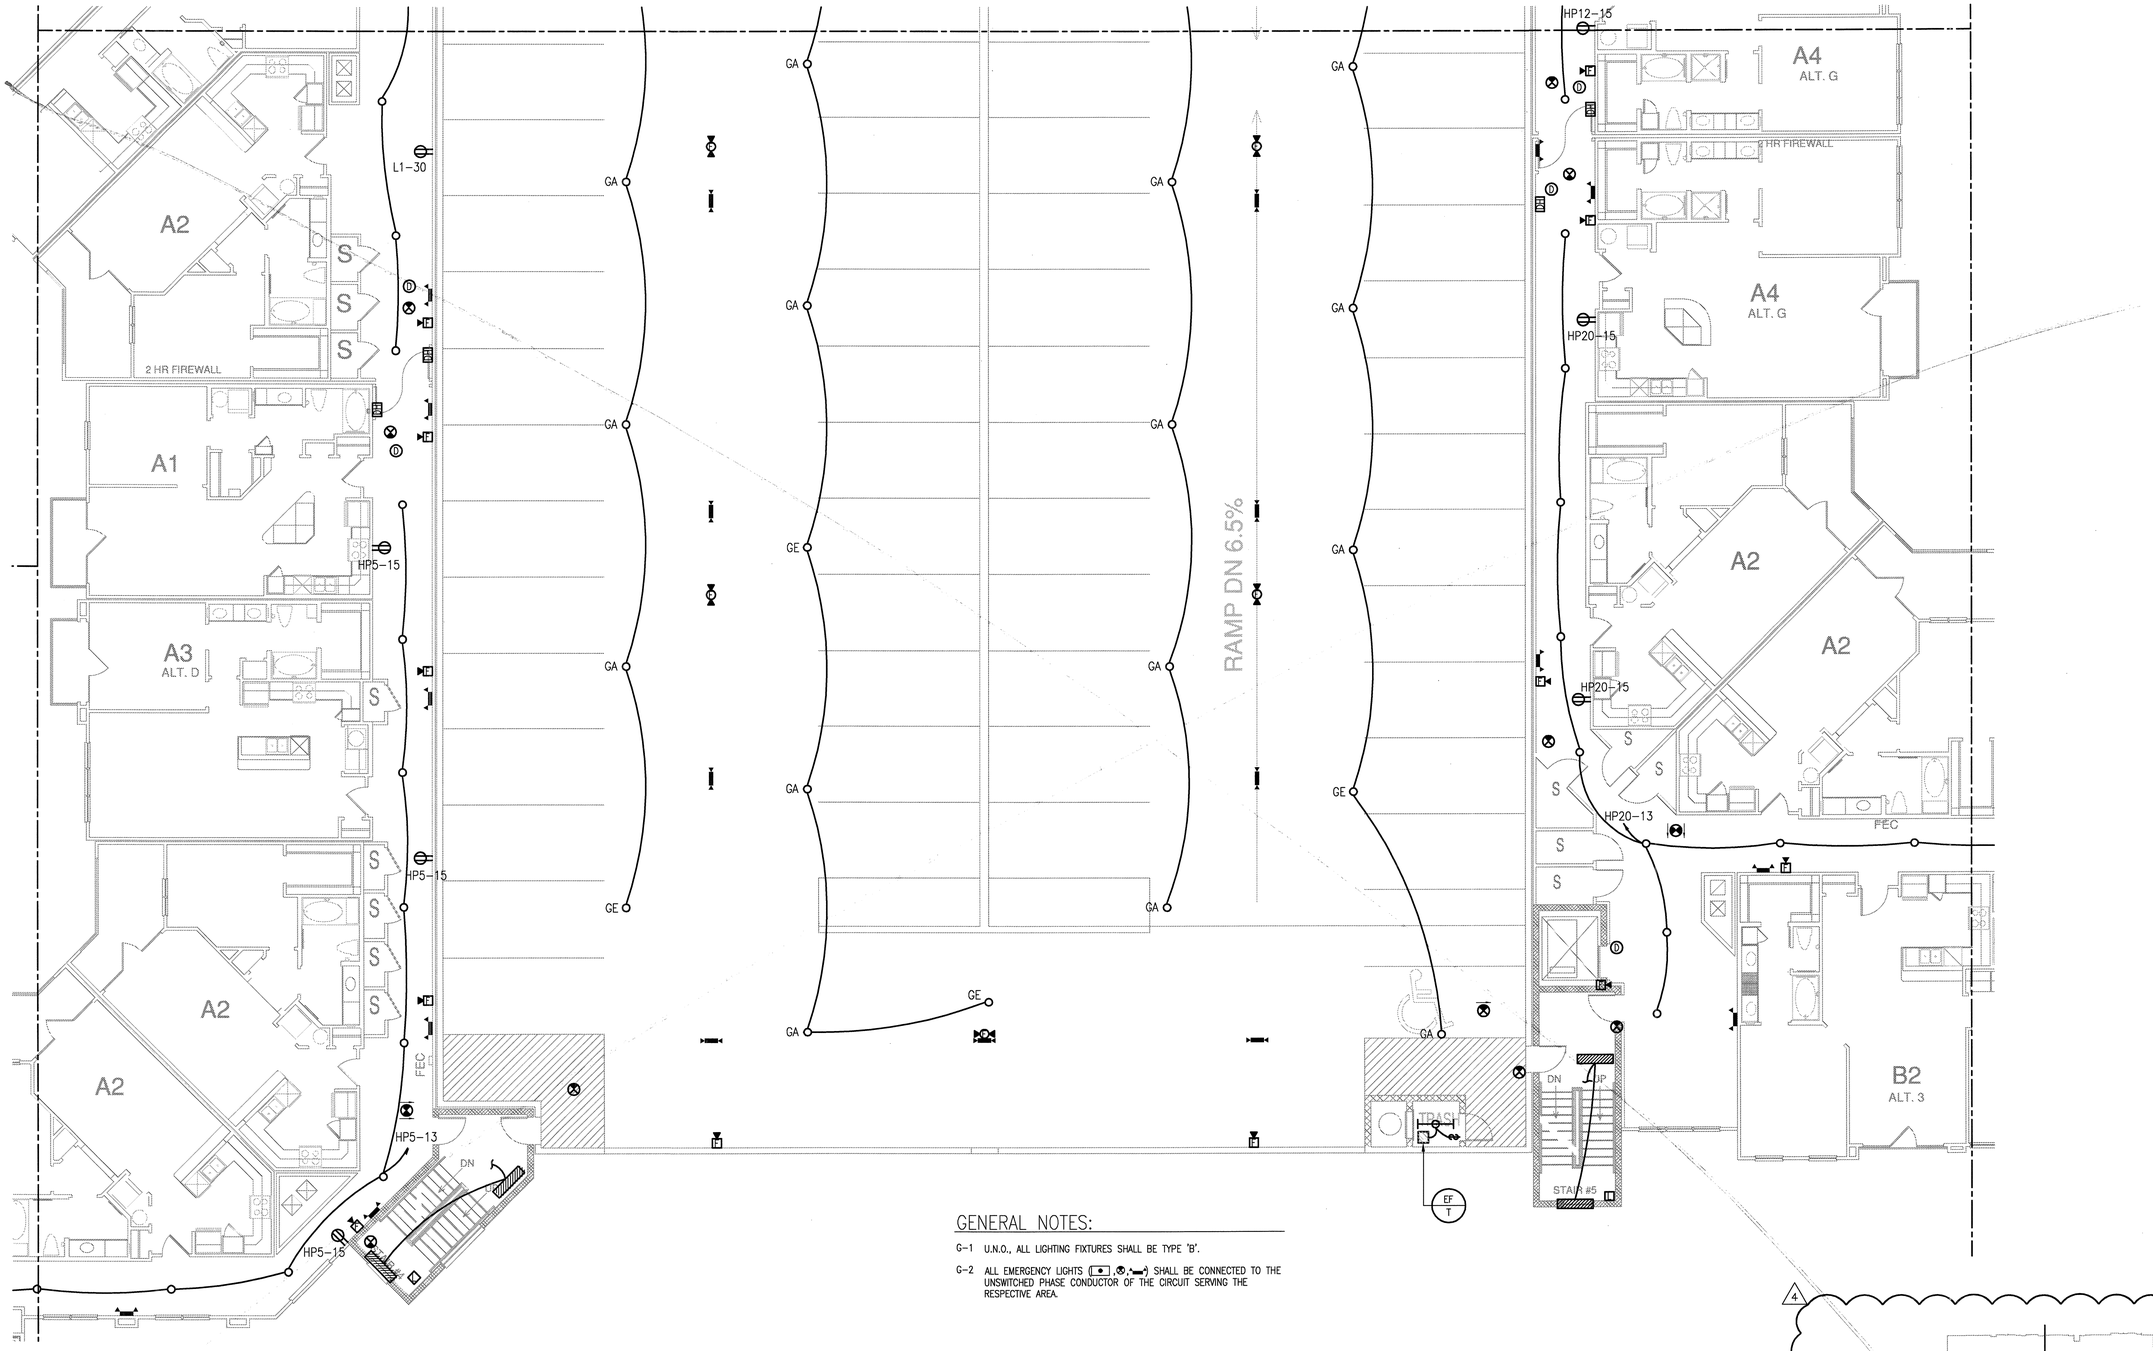

GENERAL NOTES:

G-1 U.N.O., ALL LIGHTING FIXTURES SHALL BE TYPE 'B'.

G-2 ALL EMERGENCY LIGHTS (, ,) SHALL BE CONNECTED TO THE UNSWITCHED PHASE CONDUCTOR OF THE CIRCUIT SERVING THE RESPECTIVE AREA.

1 DIVISION 'D' FOURTH FLOOR PLAN

SCALE: 1/8" = 1'-0"

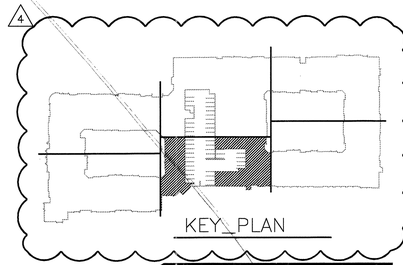

Jordan & Skala Engineers
14240 Midway Road, Suite 350
Dallas, TX 75244-5138
V: (469) 383-1616 F: (469) 383-1615
Project Number - 113-0355
Drawn By: MJ
Texas Firm Registration # F-4990
Checked By: RAD

STATE OF TEXAS
ROSS McFARLAND
108752
LICENSED
PROFESSIONAL ENGINEER
10/21/11

REVISIONS

1	9-2-2011	DESIGN REVISIONS
2	9-13-2011	ANSI/FHA COMMENTS
3	9-23-2011	DESIGN REVISIONS
4	10-17-2011	CONSTRUCTION ISSUE

KELLER SPRINGS LOFTS

LOFT APARTMENTS IN ADDISON, TEXAS

BGO architects
4144 N. Central Expy.
Suite 855
Dallas, TX 75204
214.520.8878
bgoarchitects.com

DATE
08-05-11

PROJECT
11129

SHEET NUMBER
E-3.4D