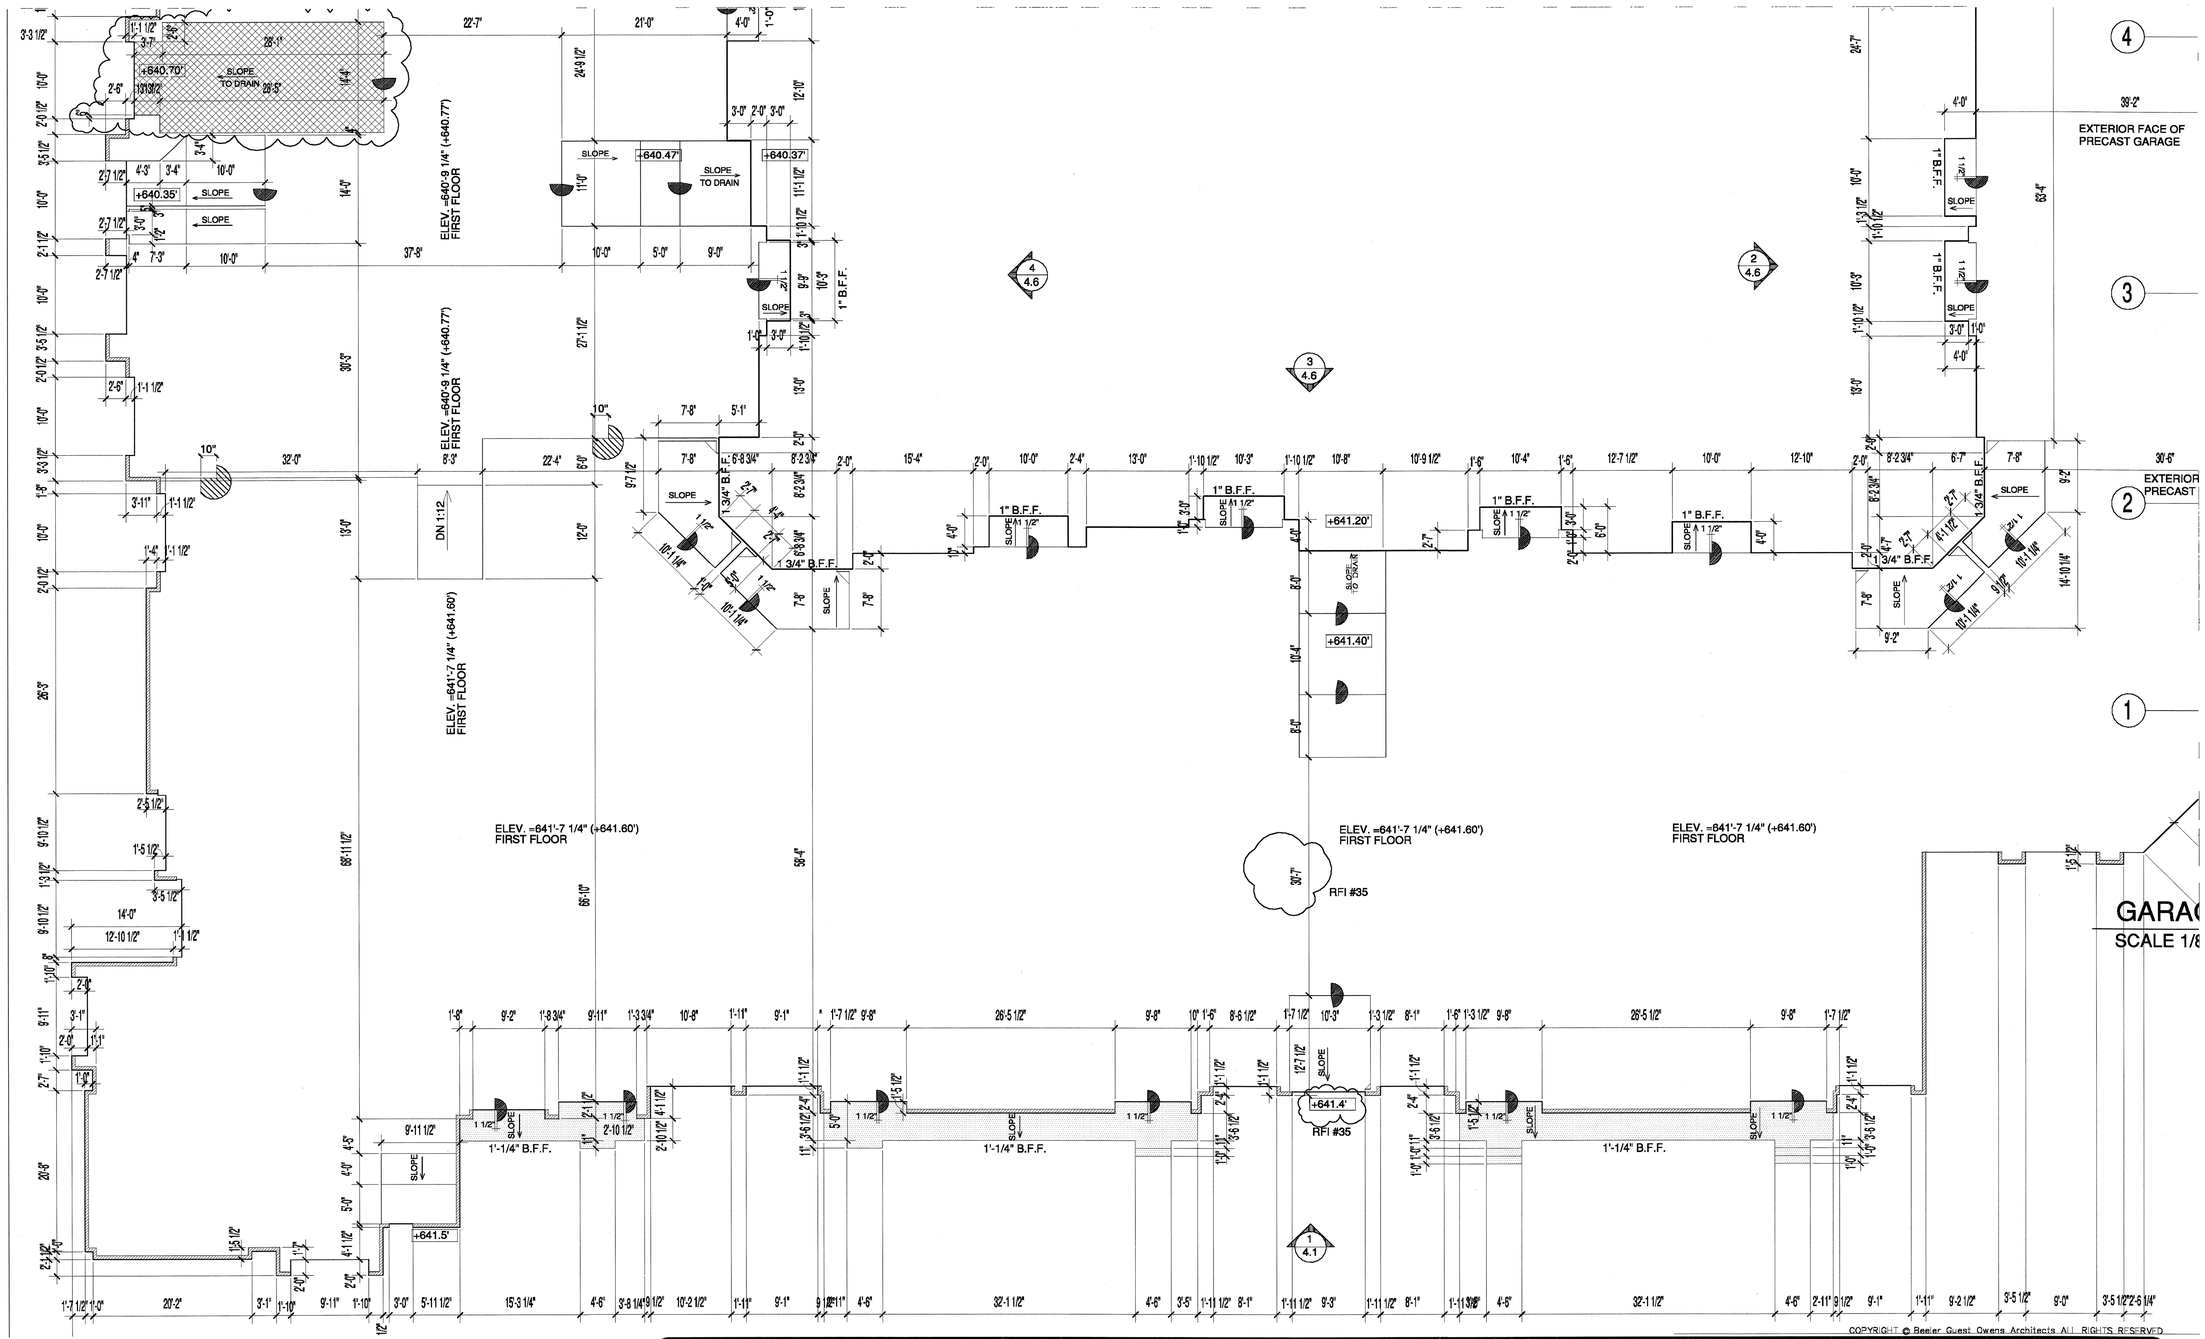

COPYRIGHT © Beeler Guest Owens Architects ALL RIGHTS RESERVED

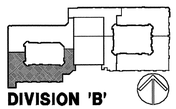

DIVISION 'B'

BGO architects
4144 N. Central Expy.
Suite 855
Dallas, TX 75204
214.520.8878
bgoarchitects.com

CONSTRUCTION ISSUE
10-17-2011

REVISIONS

KELLER SPRINGS LOFTS

LOFT APARTMENTS IN ADDISON, TEXAS

REGISTERED ARCHITECT
DAVID O. EARNEST
22433
STATE OF TEXAS
01-03-2012

DATE
08-05-2011

PROJECT
11129

SHEET NUMBER
FP-B
BLDG PLAN 'B'